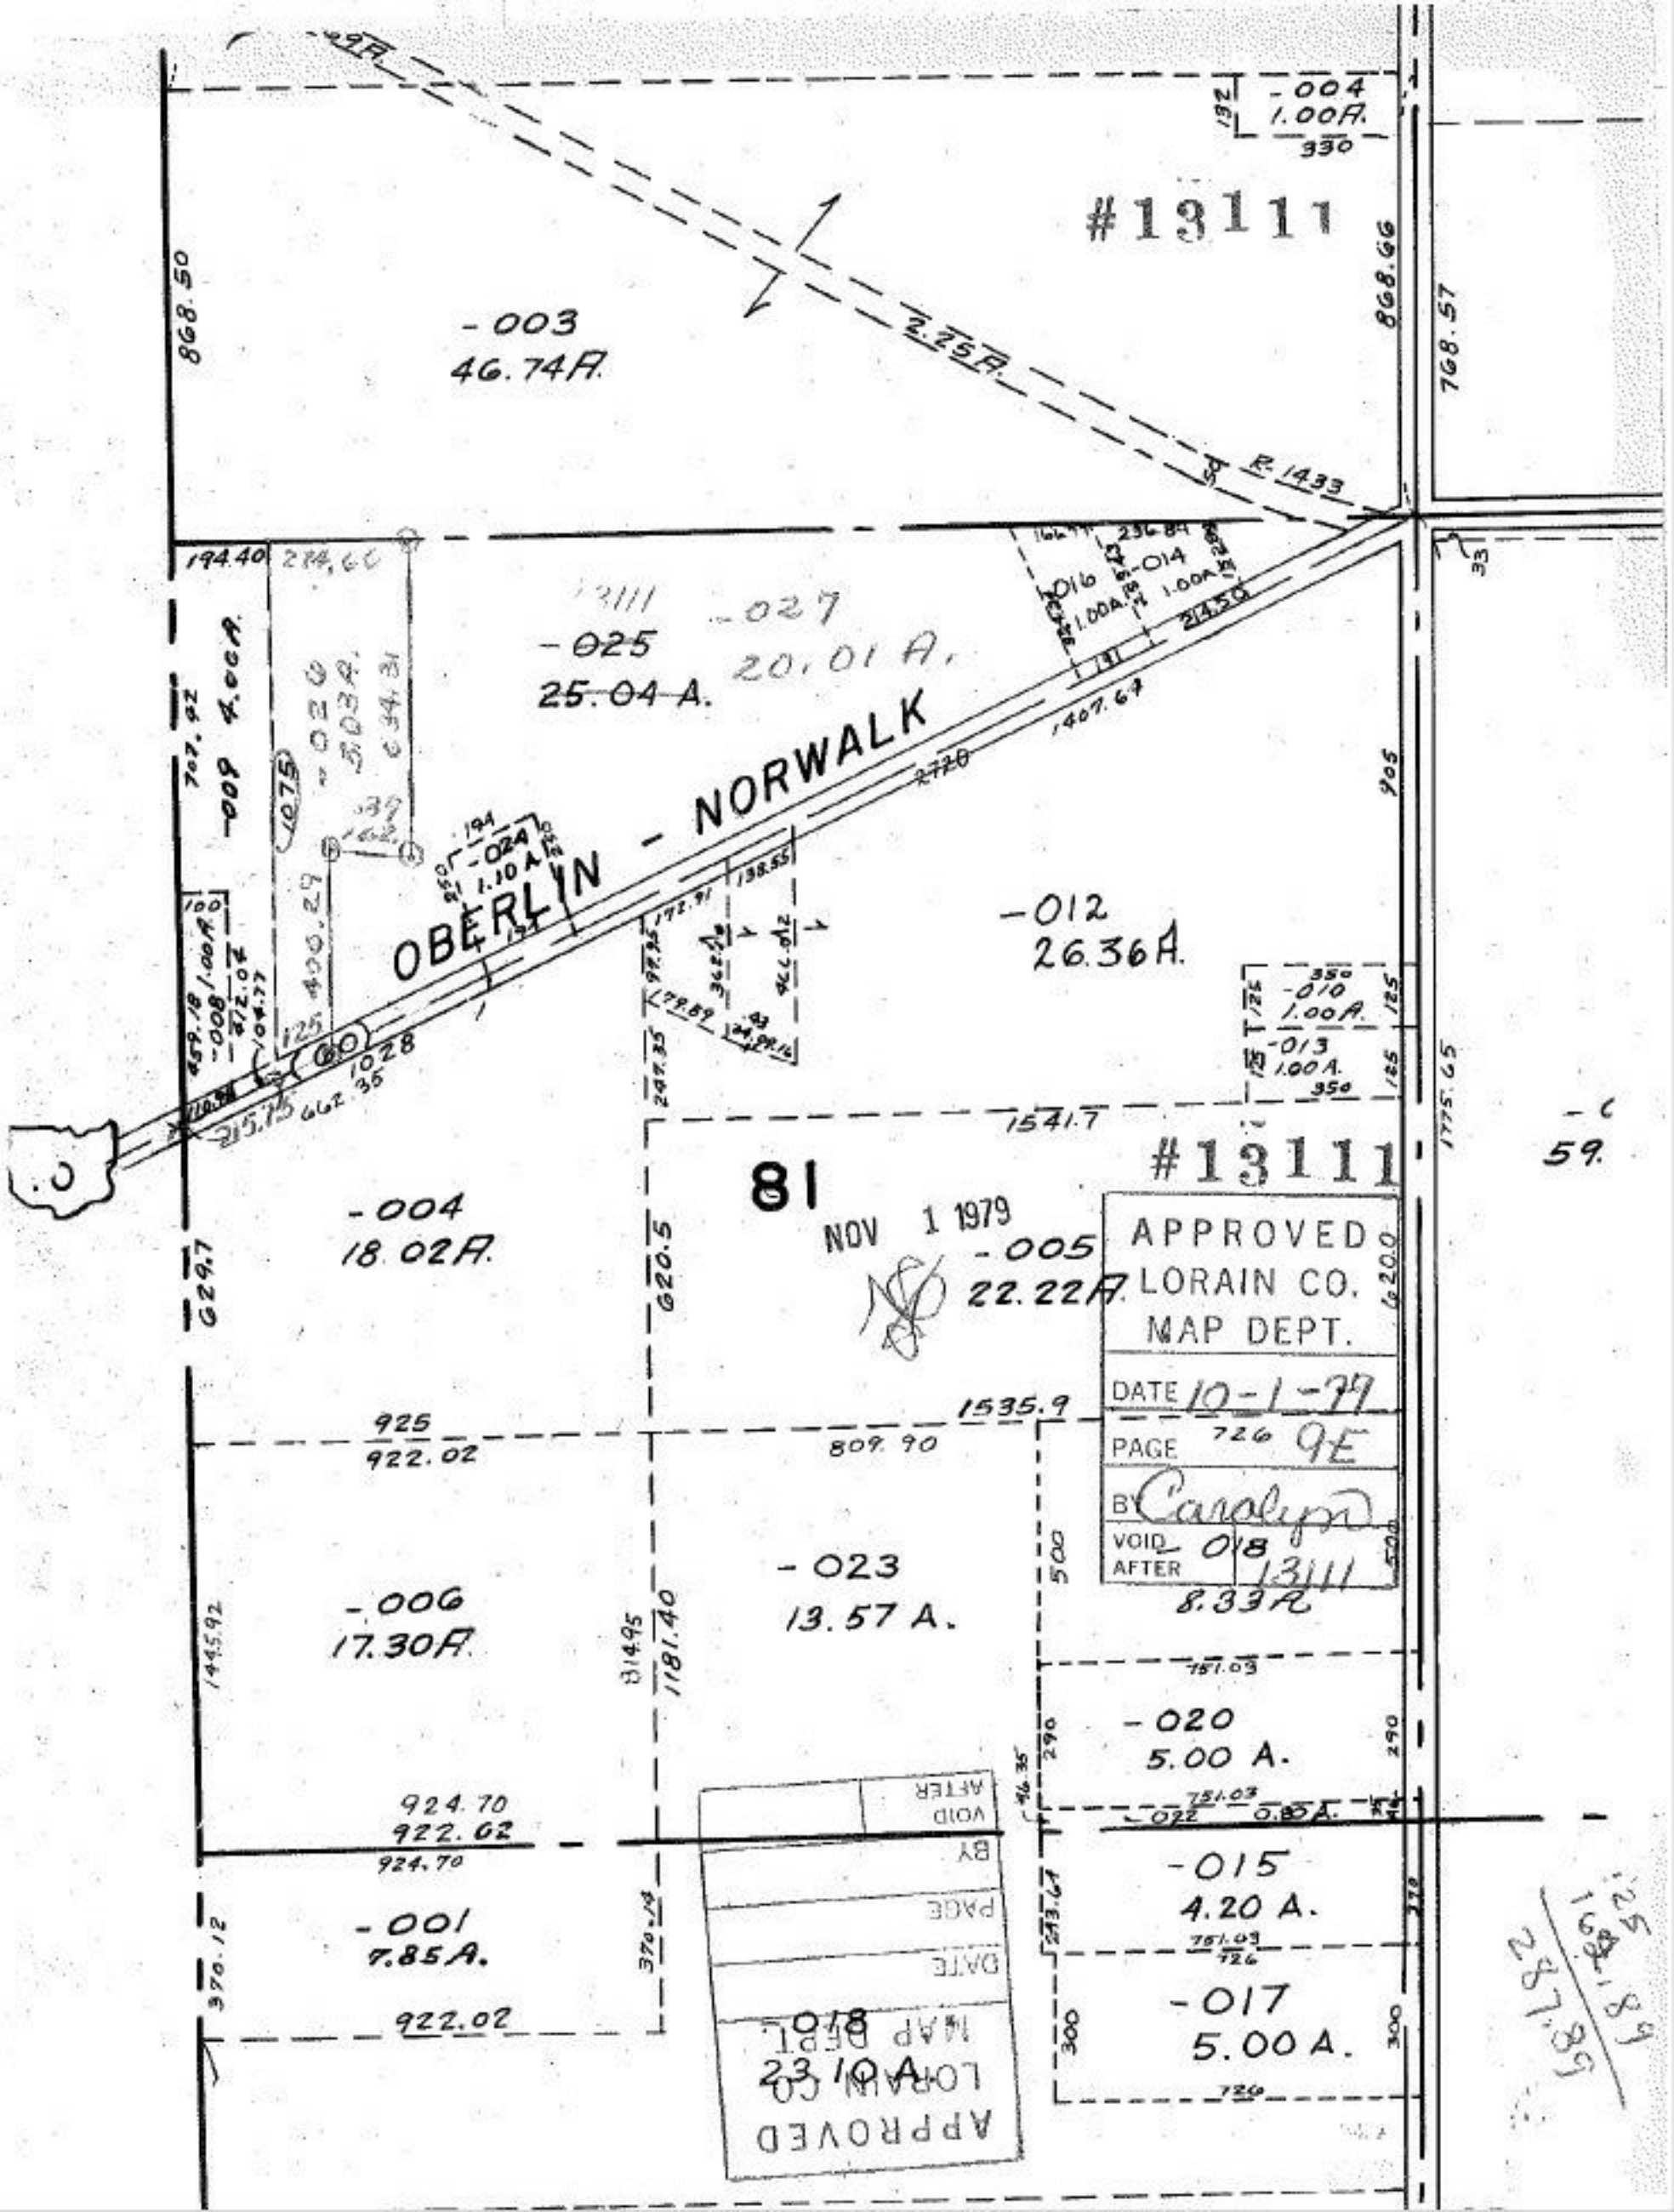

#13111
-004
1.00A.
330
-003
46.74A.
2.25A.
R-1433
868.50
868.66
768.57
194.40
-025
25.04 A.
-027
20.01 A.
-009 4.00A.
-026
5.03A.
-024
1.10 A.
OBERLIN - NORWALK
-012
26.36A.
-010
1.00A.
-013
1.00A.
1541.7
1775.65
59.
81
NOV 1 1979
-004
18.02A.
-005
22.22A.
APPROVED
LORAIN CO.
MAP DEPT.
DATE 10-1-79
PAGE 9E
BY Carolyn
VOID AFTER 13111
-018
8.33A.
925
922.02
1535.9
809.90
-006
17.30A.
-023
13.57 A.
-020
5.00 A.
-022
0.80A.
924.70
922.02
924.70
-015
4.20 A.
-001
7.85A.
-017
5.00 A.
922.02
-018
23.10A.
APPROVED
LORAIN CO.
MAP DEPT.
DATE
PAGE
BY
VOID AFTER