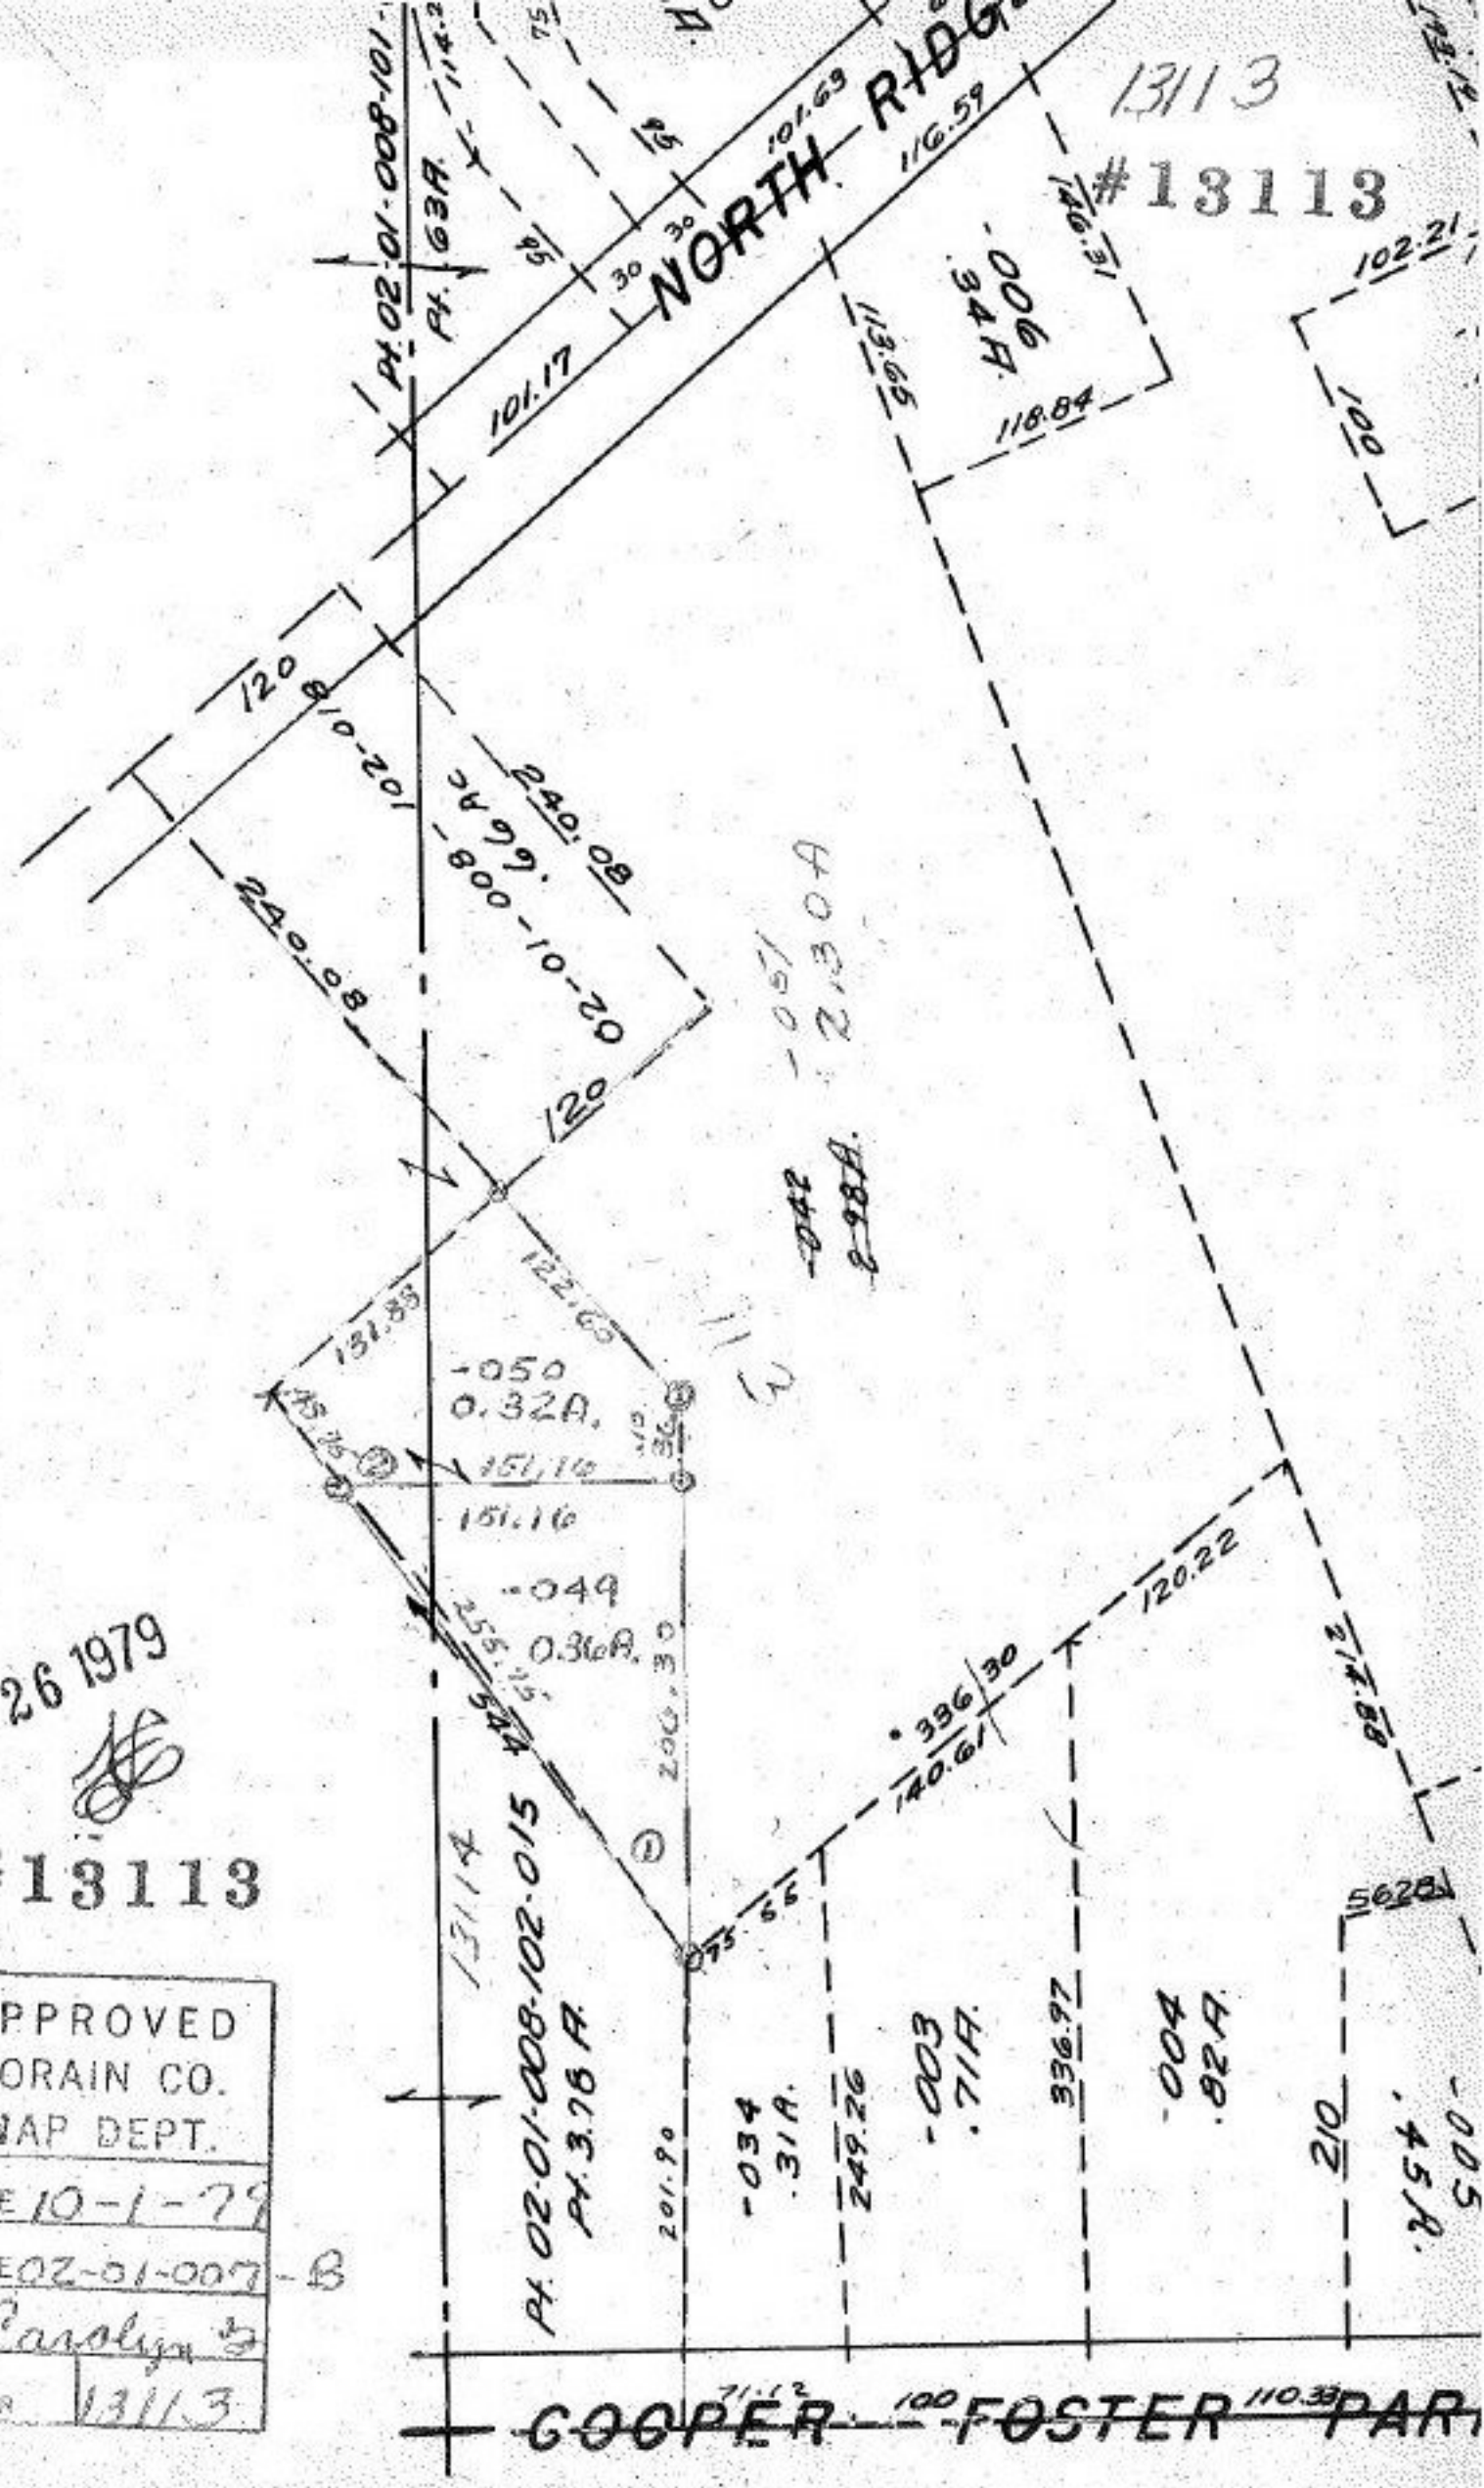

NOV 26 1979

#13113

APPROVED
LORAIN CO.
MAP DEPT.
DATE 10-1-79
PAGE 02-01-007-B
BY Carolyn
VOID AFTER 13113