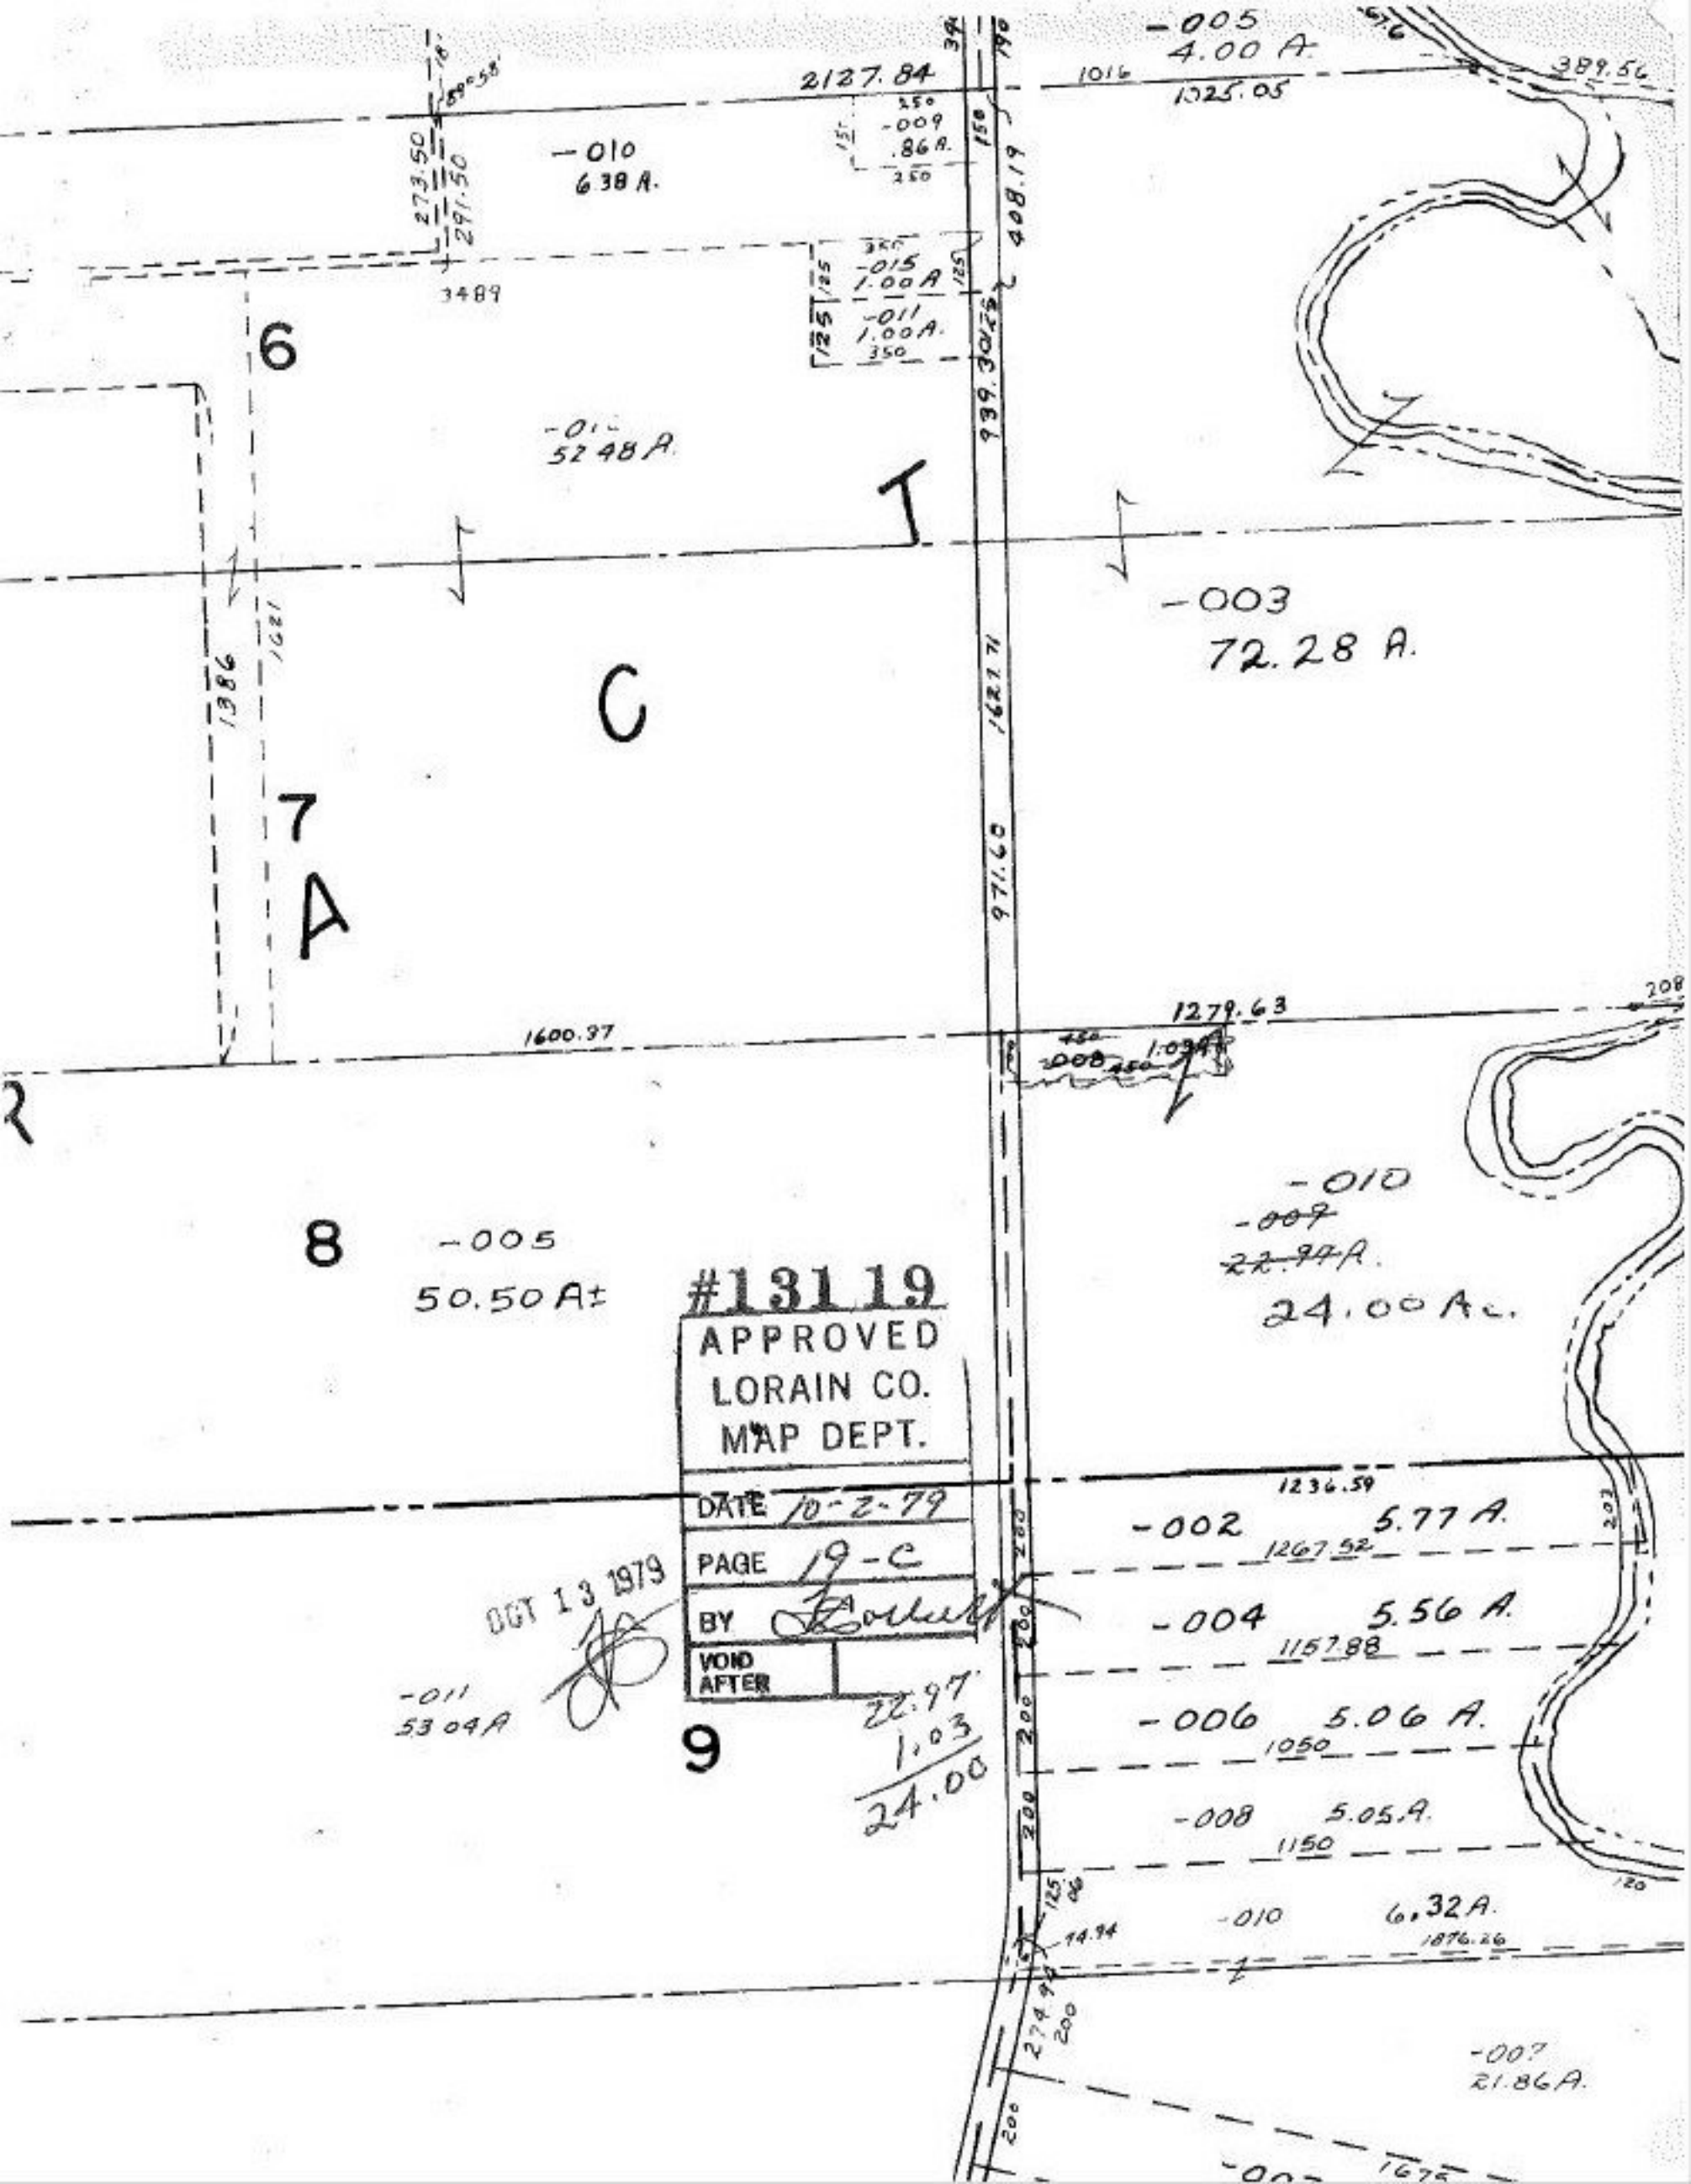

-005
4.00 A.
2127.84
1016
1025.05
389.56
-010
6.38 A.
273.50
291.50
-009
.86 A.
408.19
-015
1.00 A
-011
1.00 A.
3489
6
-010
52.48 A.
939.30
T
-003
72.28 A.
1386
1621
C
1627.71
7
A
971.60
1279.63
1600.37
R
8
-005
50.50 A±
-010
-009
22.97 A.
24.00 Ac.
#13119
APPROVED
LORAIN CO.
MAP DEPT.
DATE 10-2-79
PAGE 19-C
BY
VOID AFTER
OCT 13 1979
1236.59
-002
5.77 A.
1267.52
-004
5.56 A.
1157.88
-011
53.04 A
9
22.97
1.03
24.00
-006
5.06 A.
1050
-008
5.05 A.
1150
-010
6.32 A.
1876.26
-007
21.86 A.