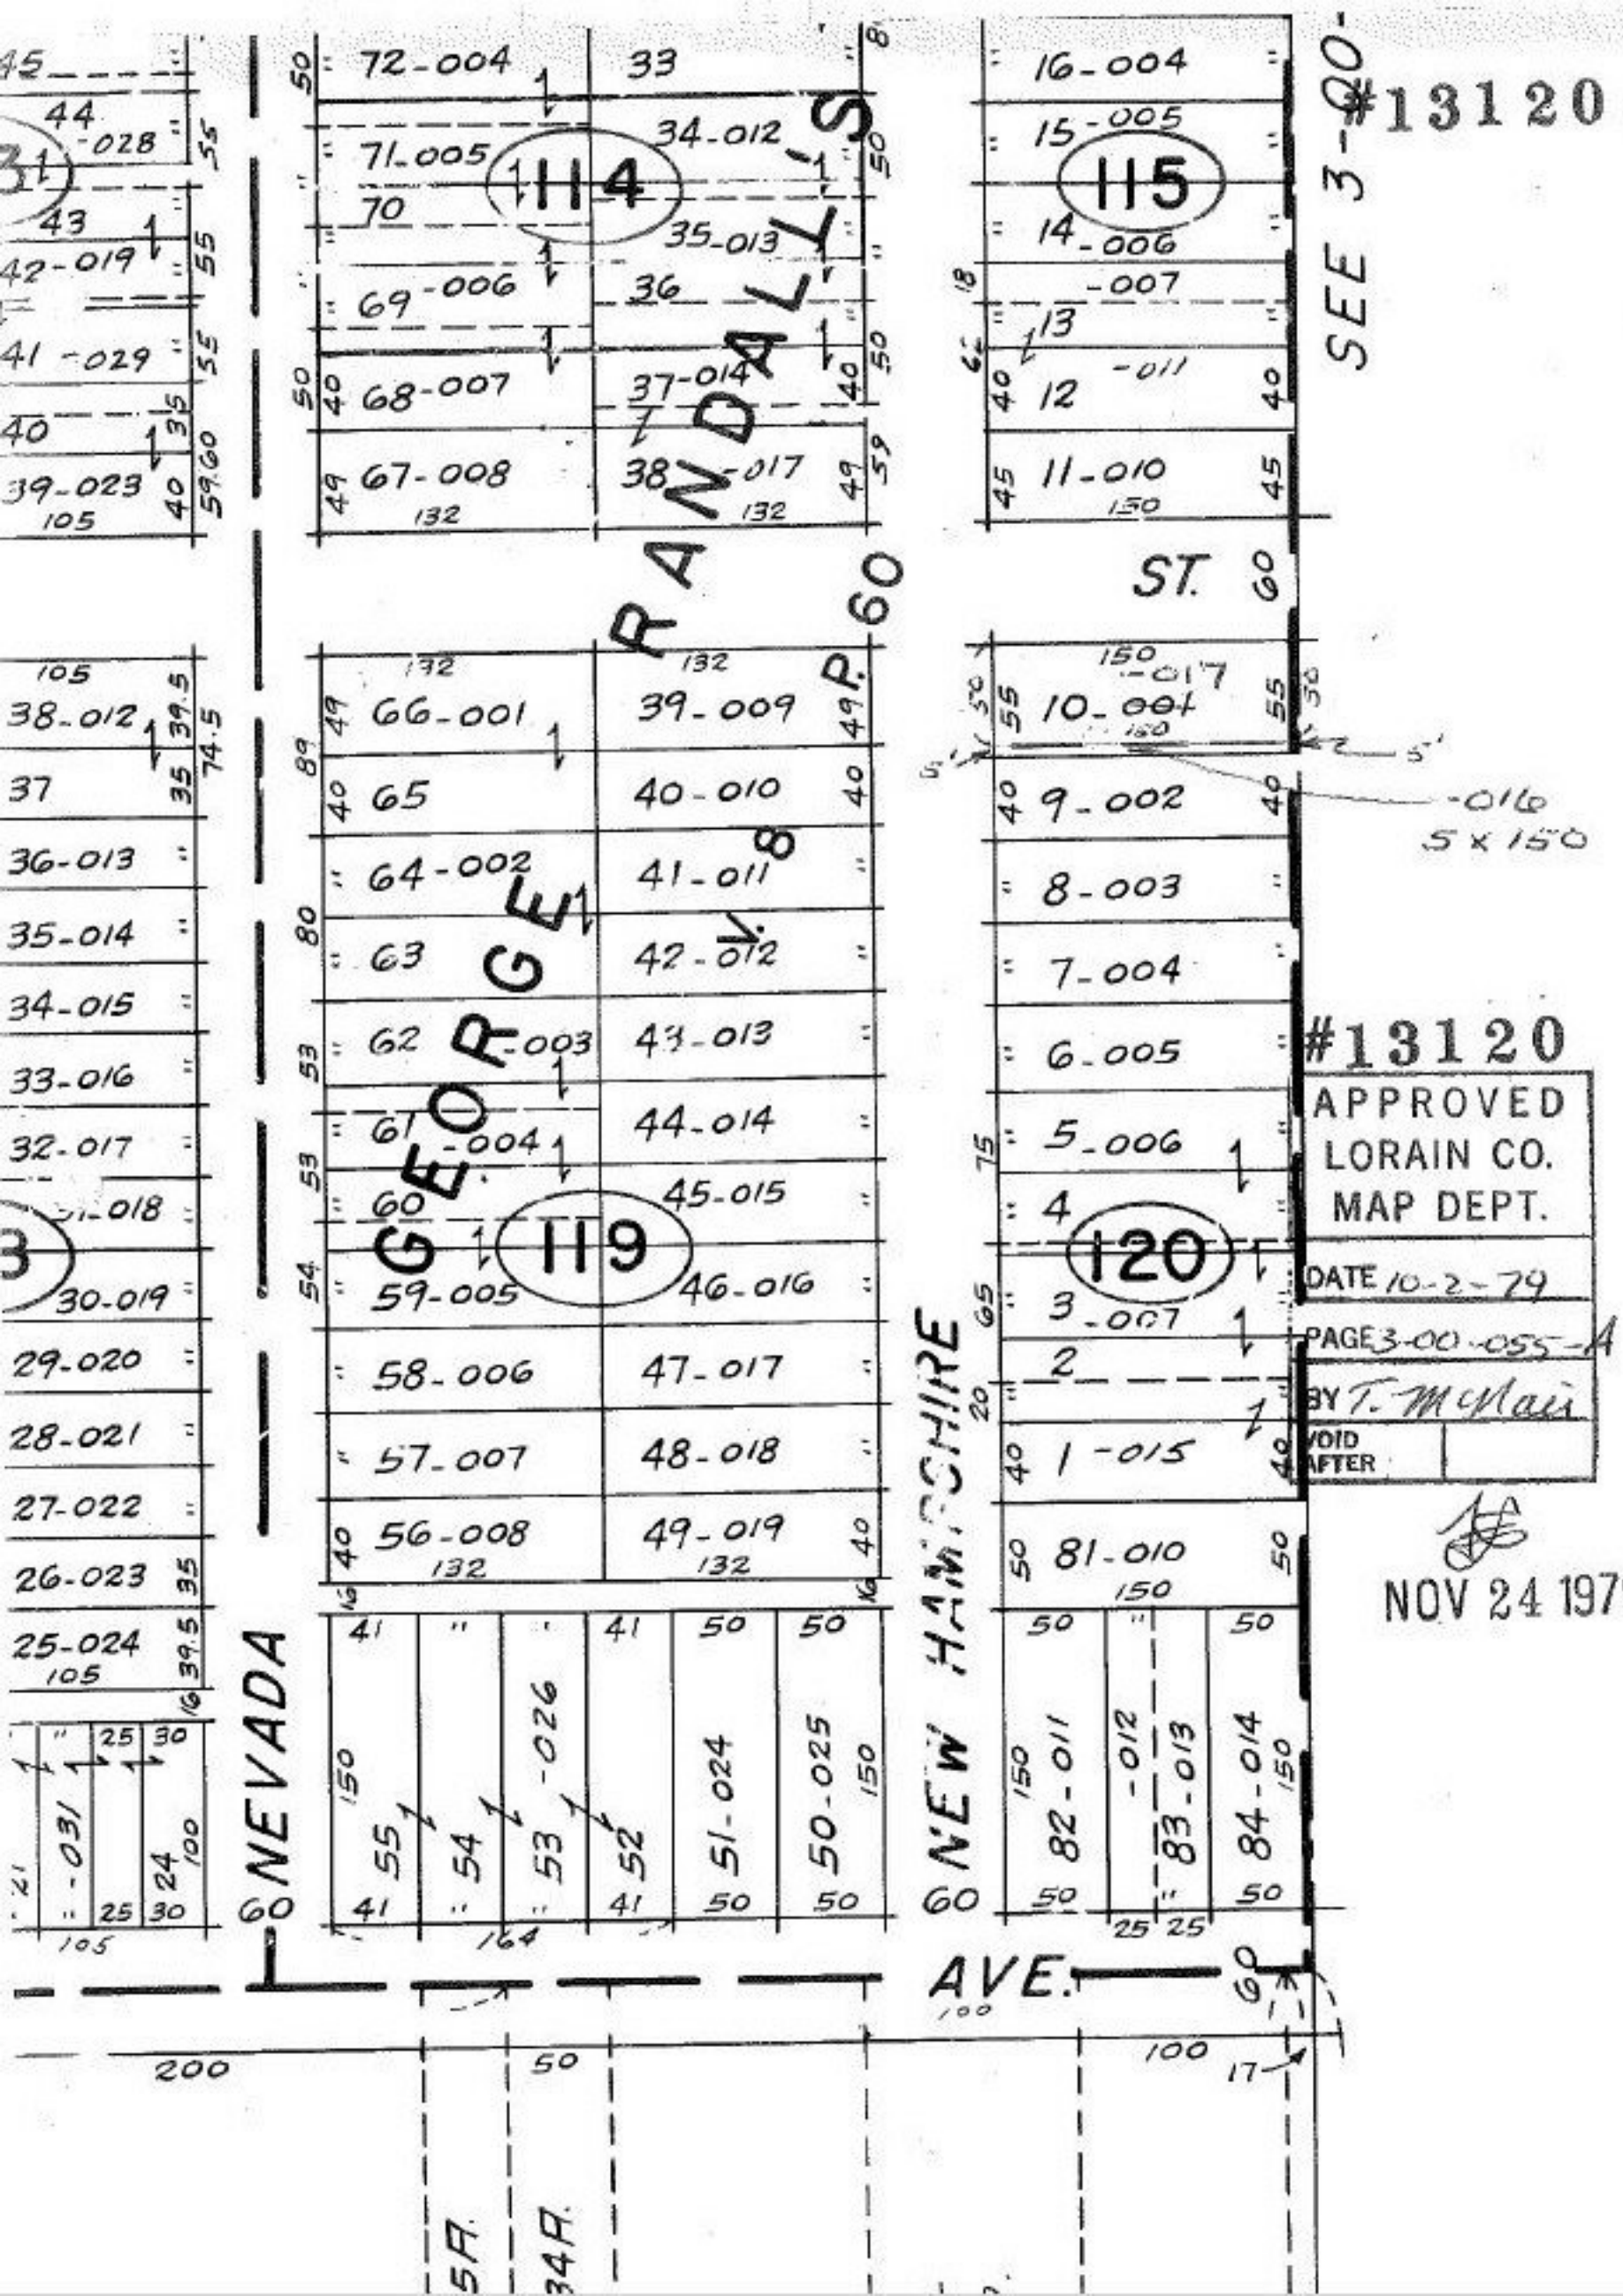

#13120
APPROVED
LORAIN CO.
MAP DEPT.
DATE 10-2-79
PAGE 3-00-055-A
BY T. McNair
VOID AFTER

NOV 24 1979