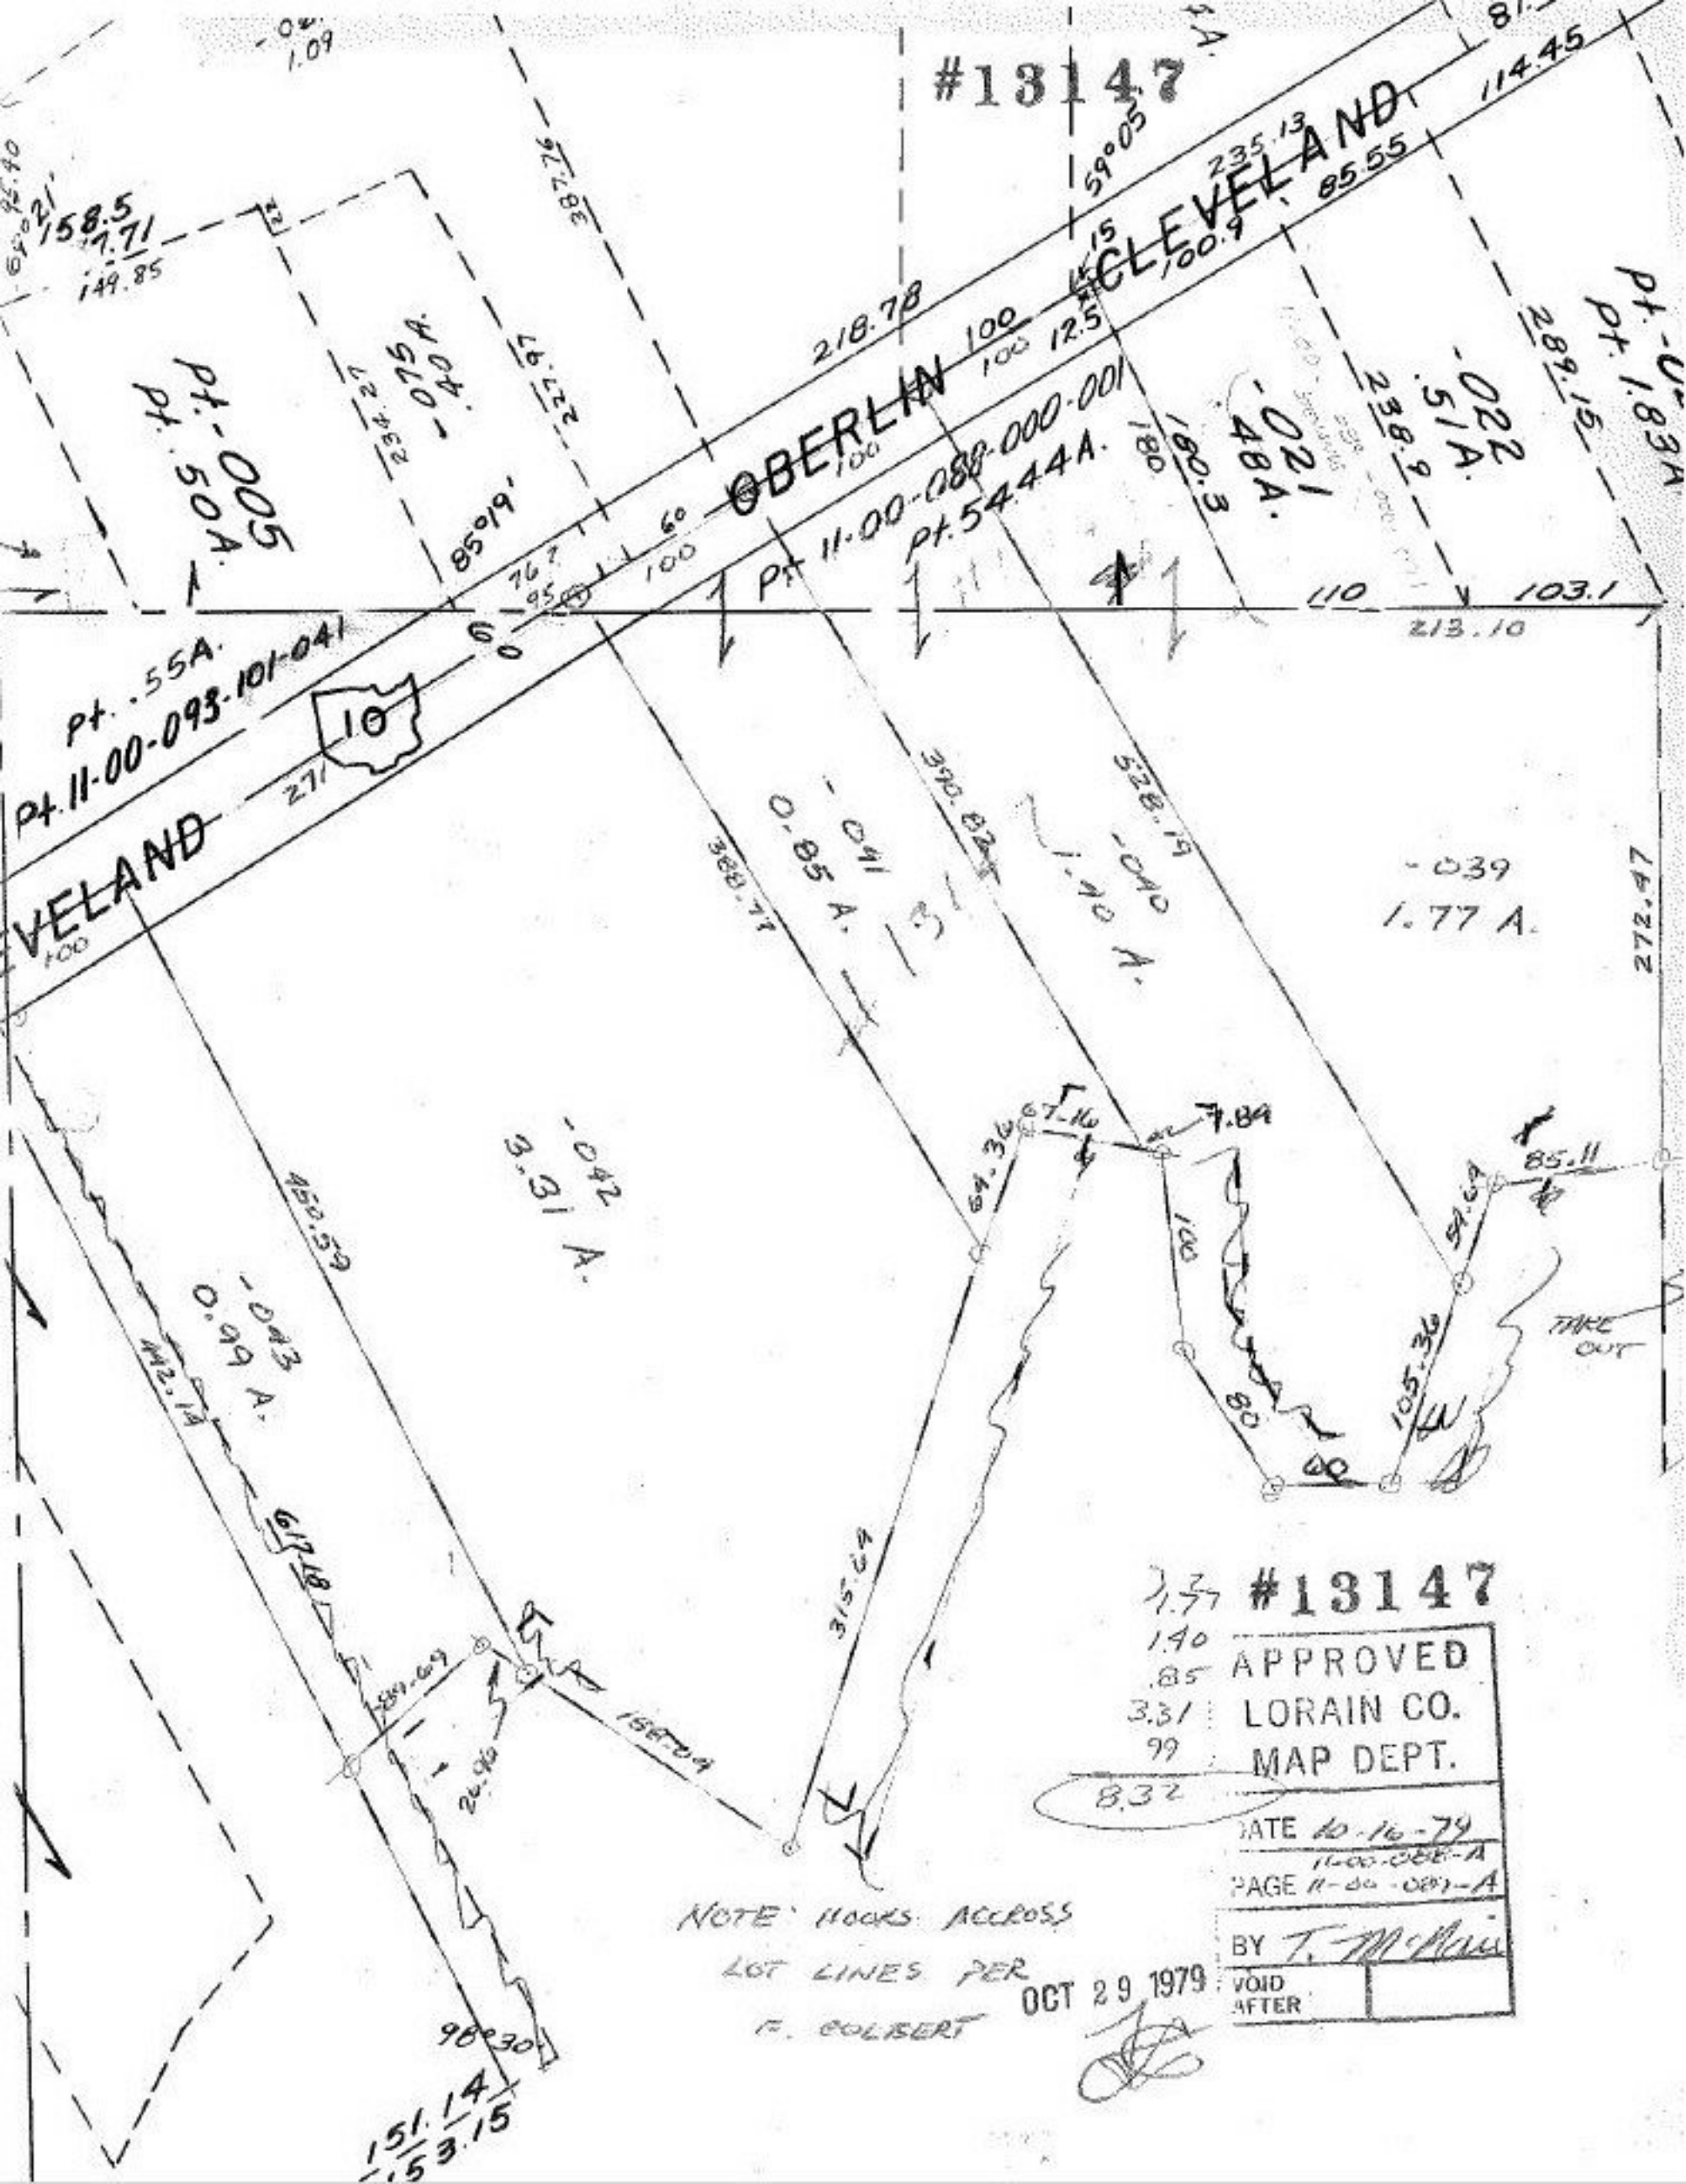
#13147
OBERLIN CLEVELAND
Pt. 11-00-088-000-001
Pt. 54.44A.
Pt. -005
Pt. .50A.
-075
.40 A.
-021
.48A.
-022
.51A.
Pt. .55A.
Pt. 11-00-093-101-041
10
-041
0.85 A.
-040
1.40 A.
-039
1.77 A.
-042
3.31 A.
-043
0.99 A.
TAKE OUT
NOTE: HOOKS ACCROSS
LOT LINES PER
F. COLBERT
OCT 29 1979
#13147
APPROVED
LORAIN CO.
MAP DEPT.
DATE 10-16-79
PAGE 11-00-088-A
BY T. McNair
VOID AFTER