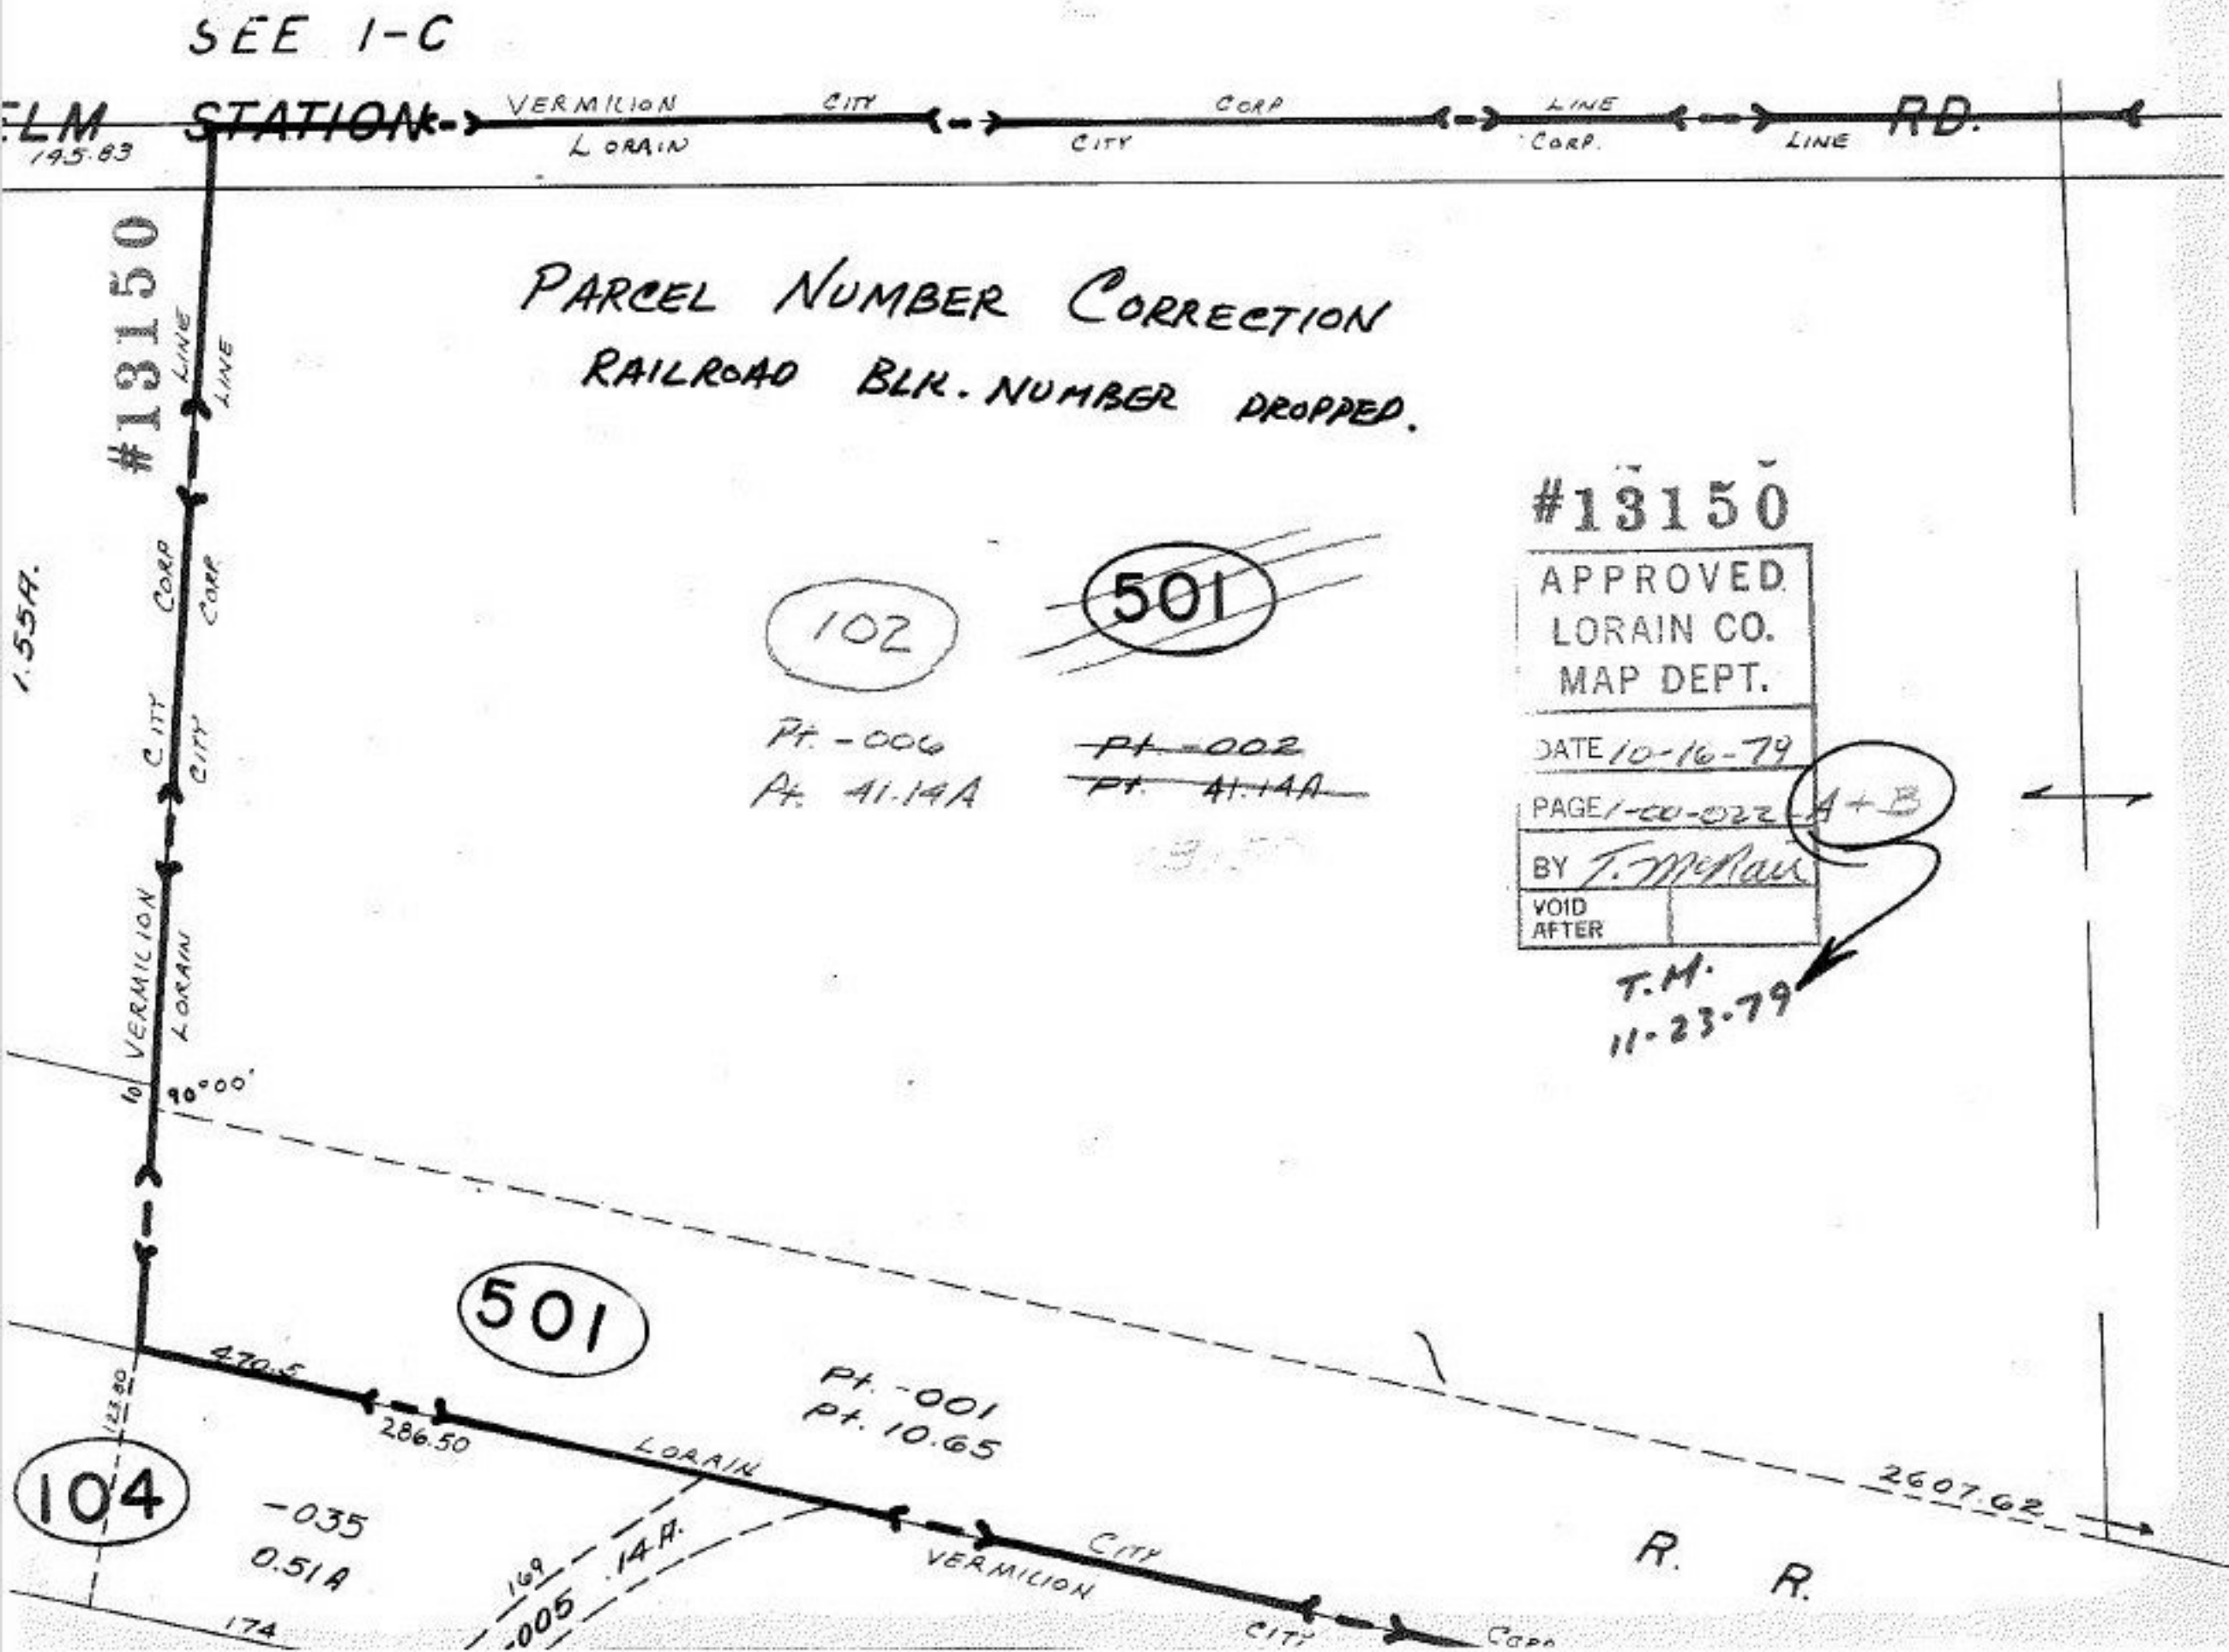
SEE 1-C
ELM STATION
145.83
VERMILION
LORAIN
CITY
CORP
CITY
LINE
CORP.
LINE
RD.
#13150
LINE
LINE
CORP
CORP
CITY
CITY
VERMILION
LORAIN
1.55A.
90°00'
PARCEL NUMBER CORRECTION
RAILROAD BLK. NUMBER DROPPED.
102
Pt. -006
Pt. 41.14A
501
Pt. -002
Pt. 41.14A
#13150
APPROVED
LORAIN CO.
MAP DEPT.
DATE 10-16-79
PAGE 1-00-022 A+B
BY T. McNair
VOID AFTER
T.M.
11-23-79
501
470.5
286.50
Pt. -001
Pt. 10.65
LORAIN
VERMILION
CITY
CITY
CORP
104
-035
0.51A
169
-005
.14A.
174
2607.62
R. R.