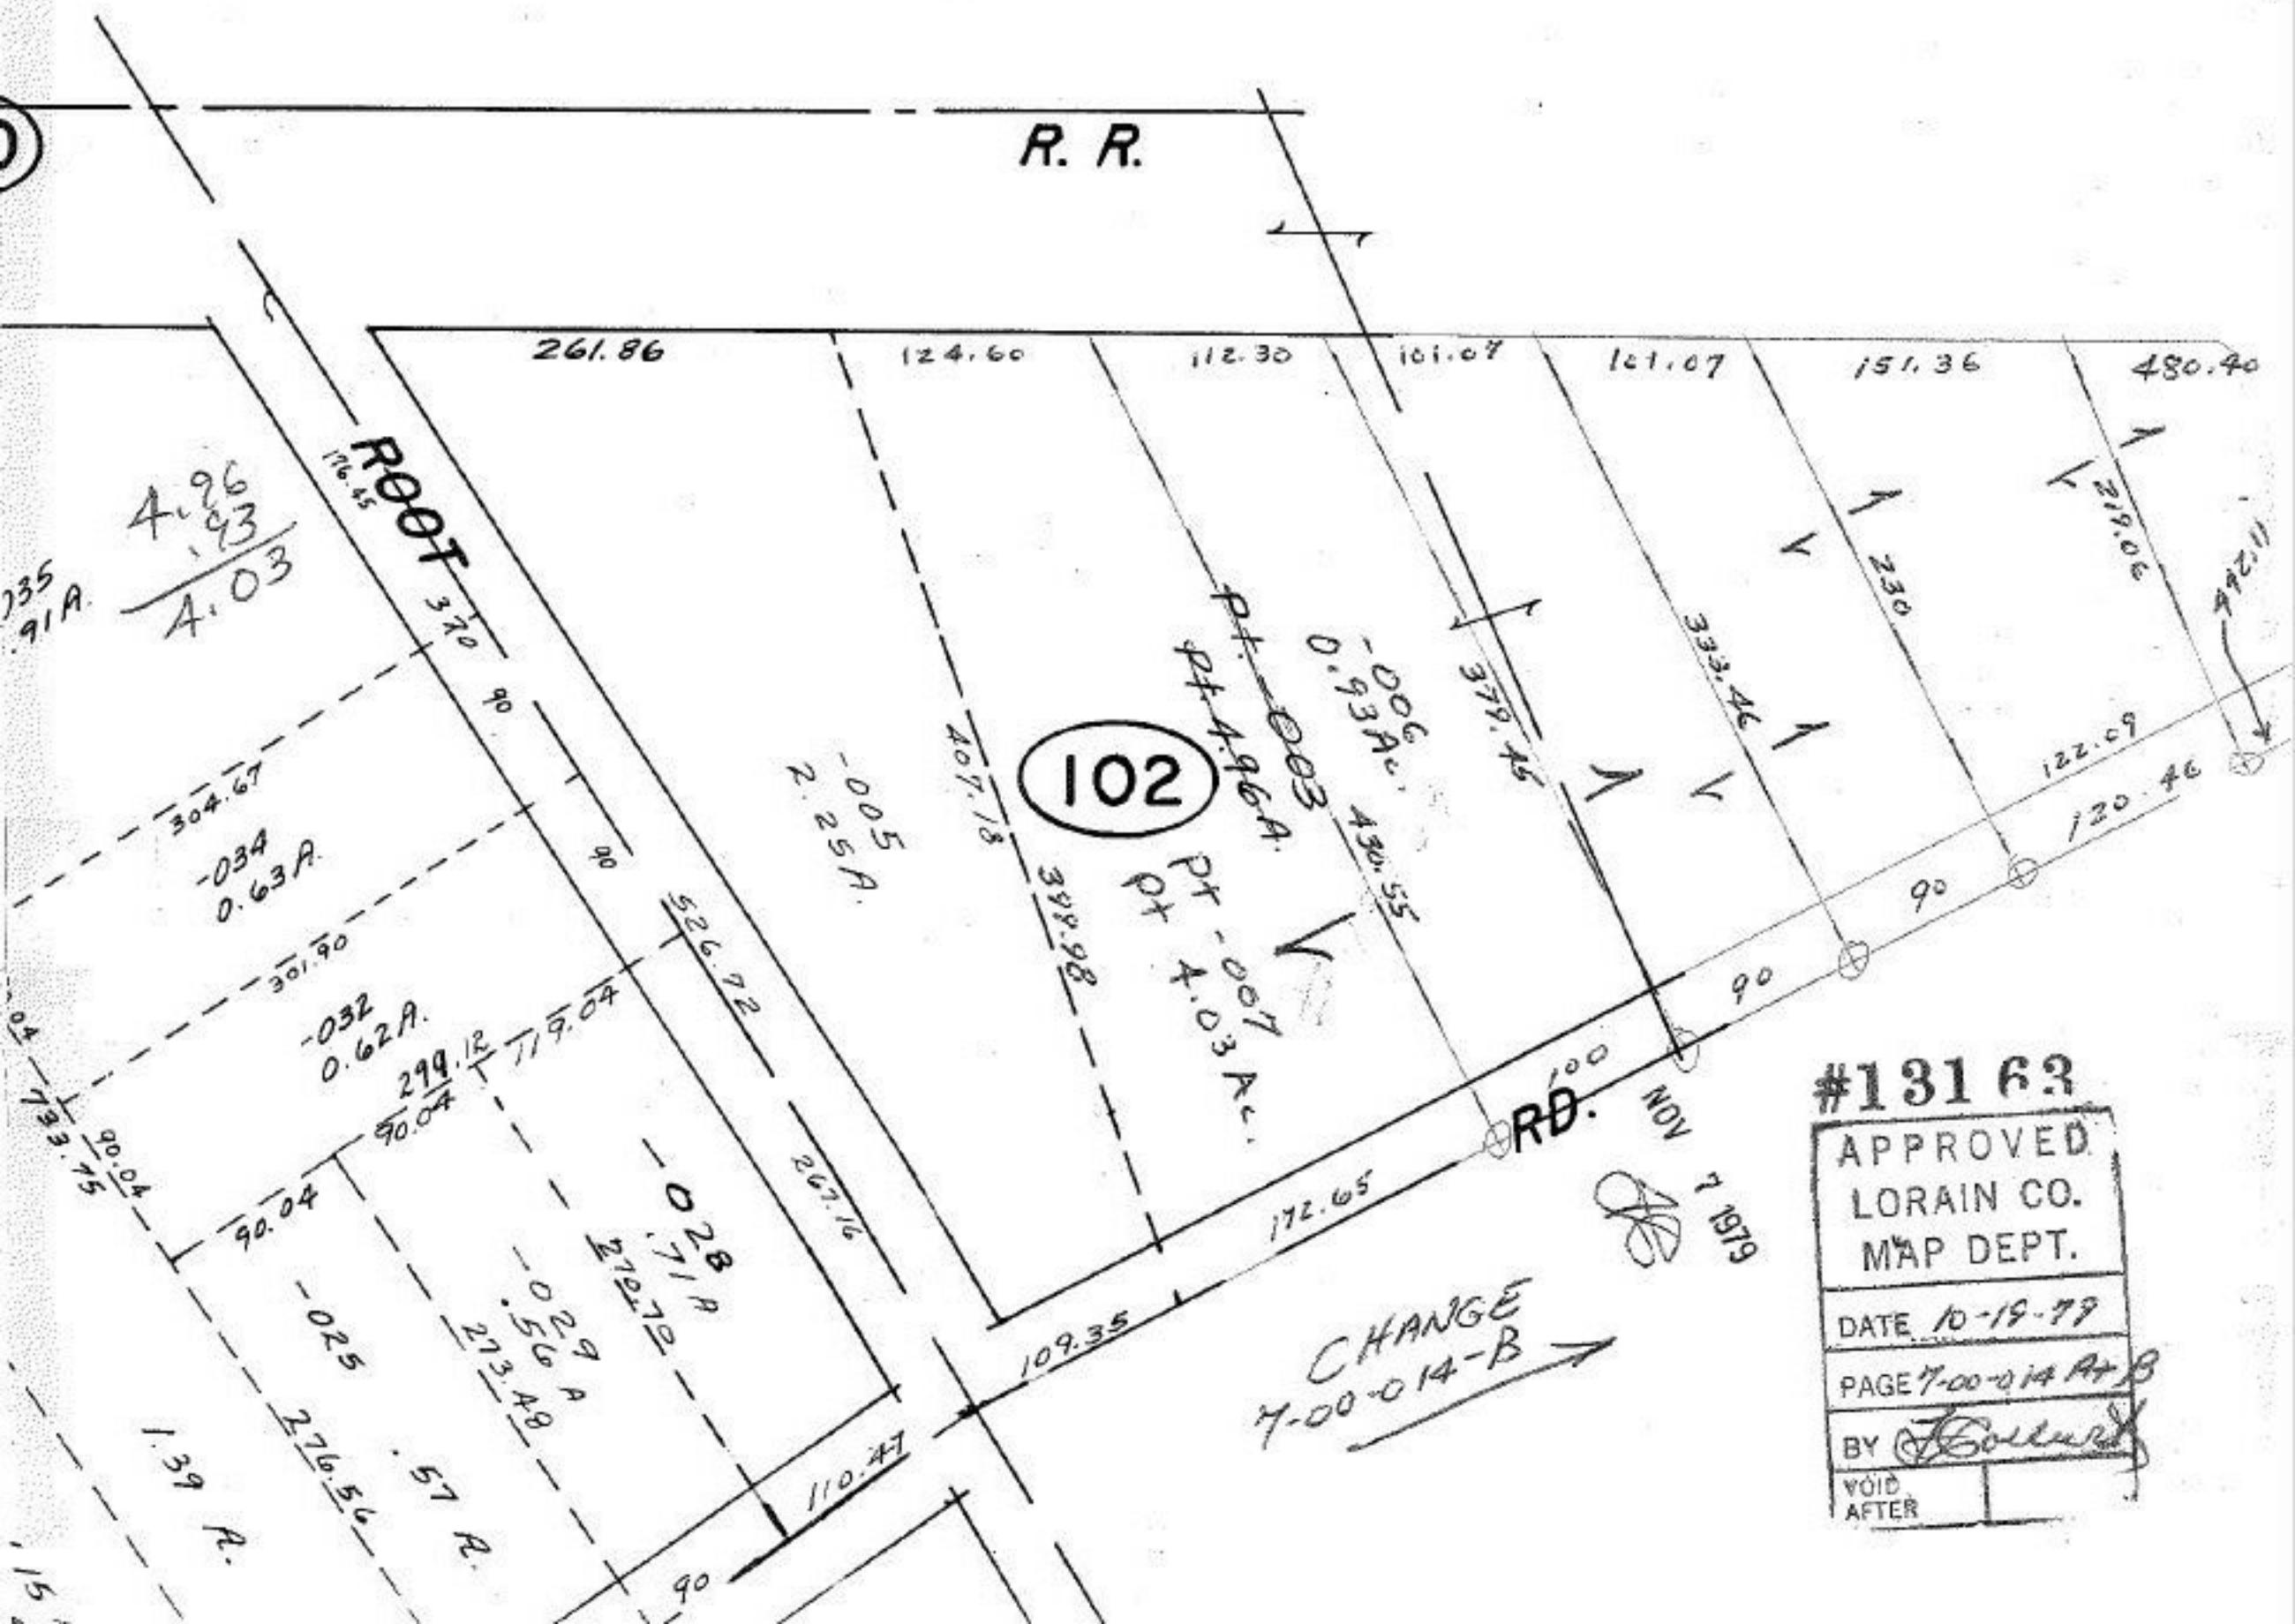
R. R.
261.86
124.60
112.30
101.07
101.07
151.36
480.40
ROOT
176.45
370
90
4.96
.93
4.03
304.67
-034
0.63A.
301.90
-032
0.62A.
299.12
90.04
119.04
90.04
90.04
733.75
-005
2.25A.
407.18
399.98
102
Pt -003
Pt 4.96A.
Pt -007
Pt 4.03 Ac.
-006
0.93Ac.
430.55
379.45
333.46
230
219.06
122.09
120.46
90
90
100
RD.
172.65
109.35
110.47
90
526.72
267.16
-028
.71 A
270.70
-029
.56 A
273.48
-025
276.56
.57 A.
1.39 A.
CHANGE
7-00-014-B
NOV 7 1979
#13163
APPROVED
LORAIN CO.
MAP DEPT.
DATE 10-19-79
PAGE 7-00-014 A+B
BY
VOID AFTER