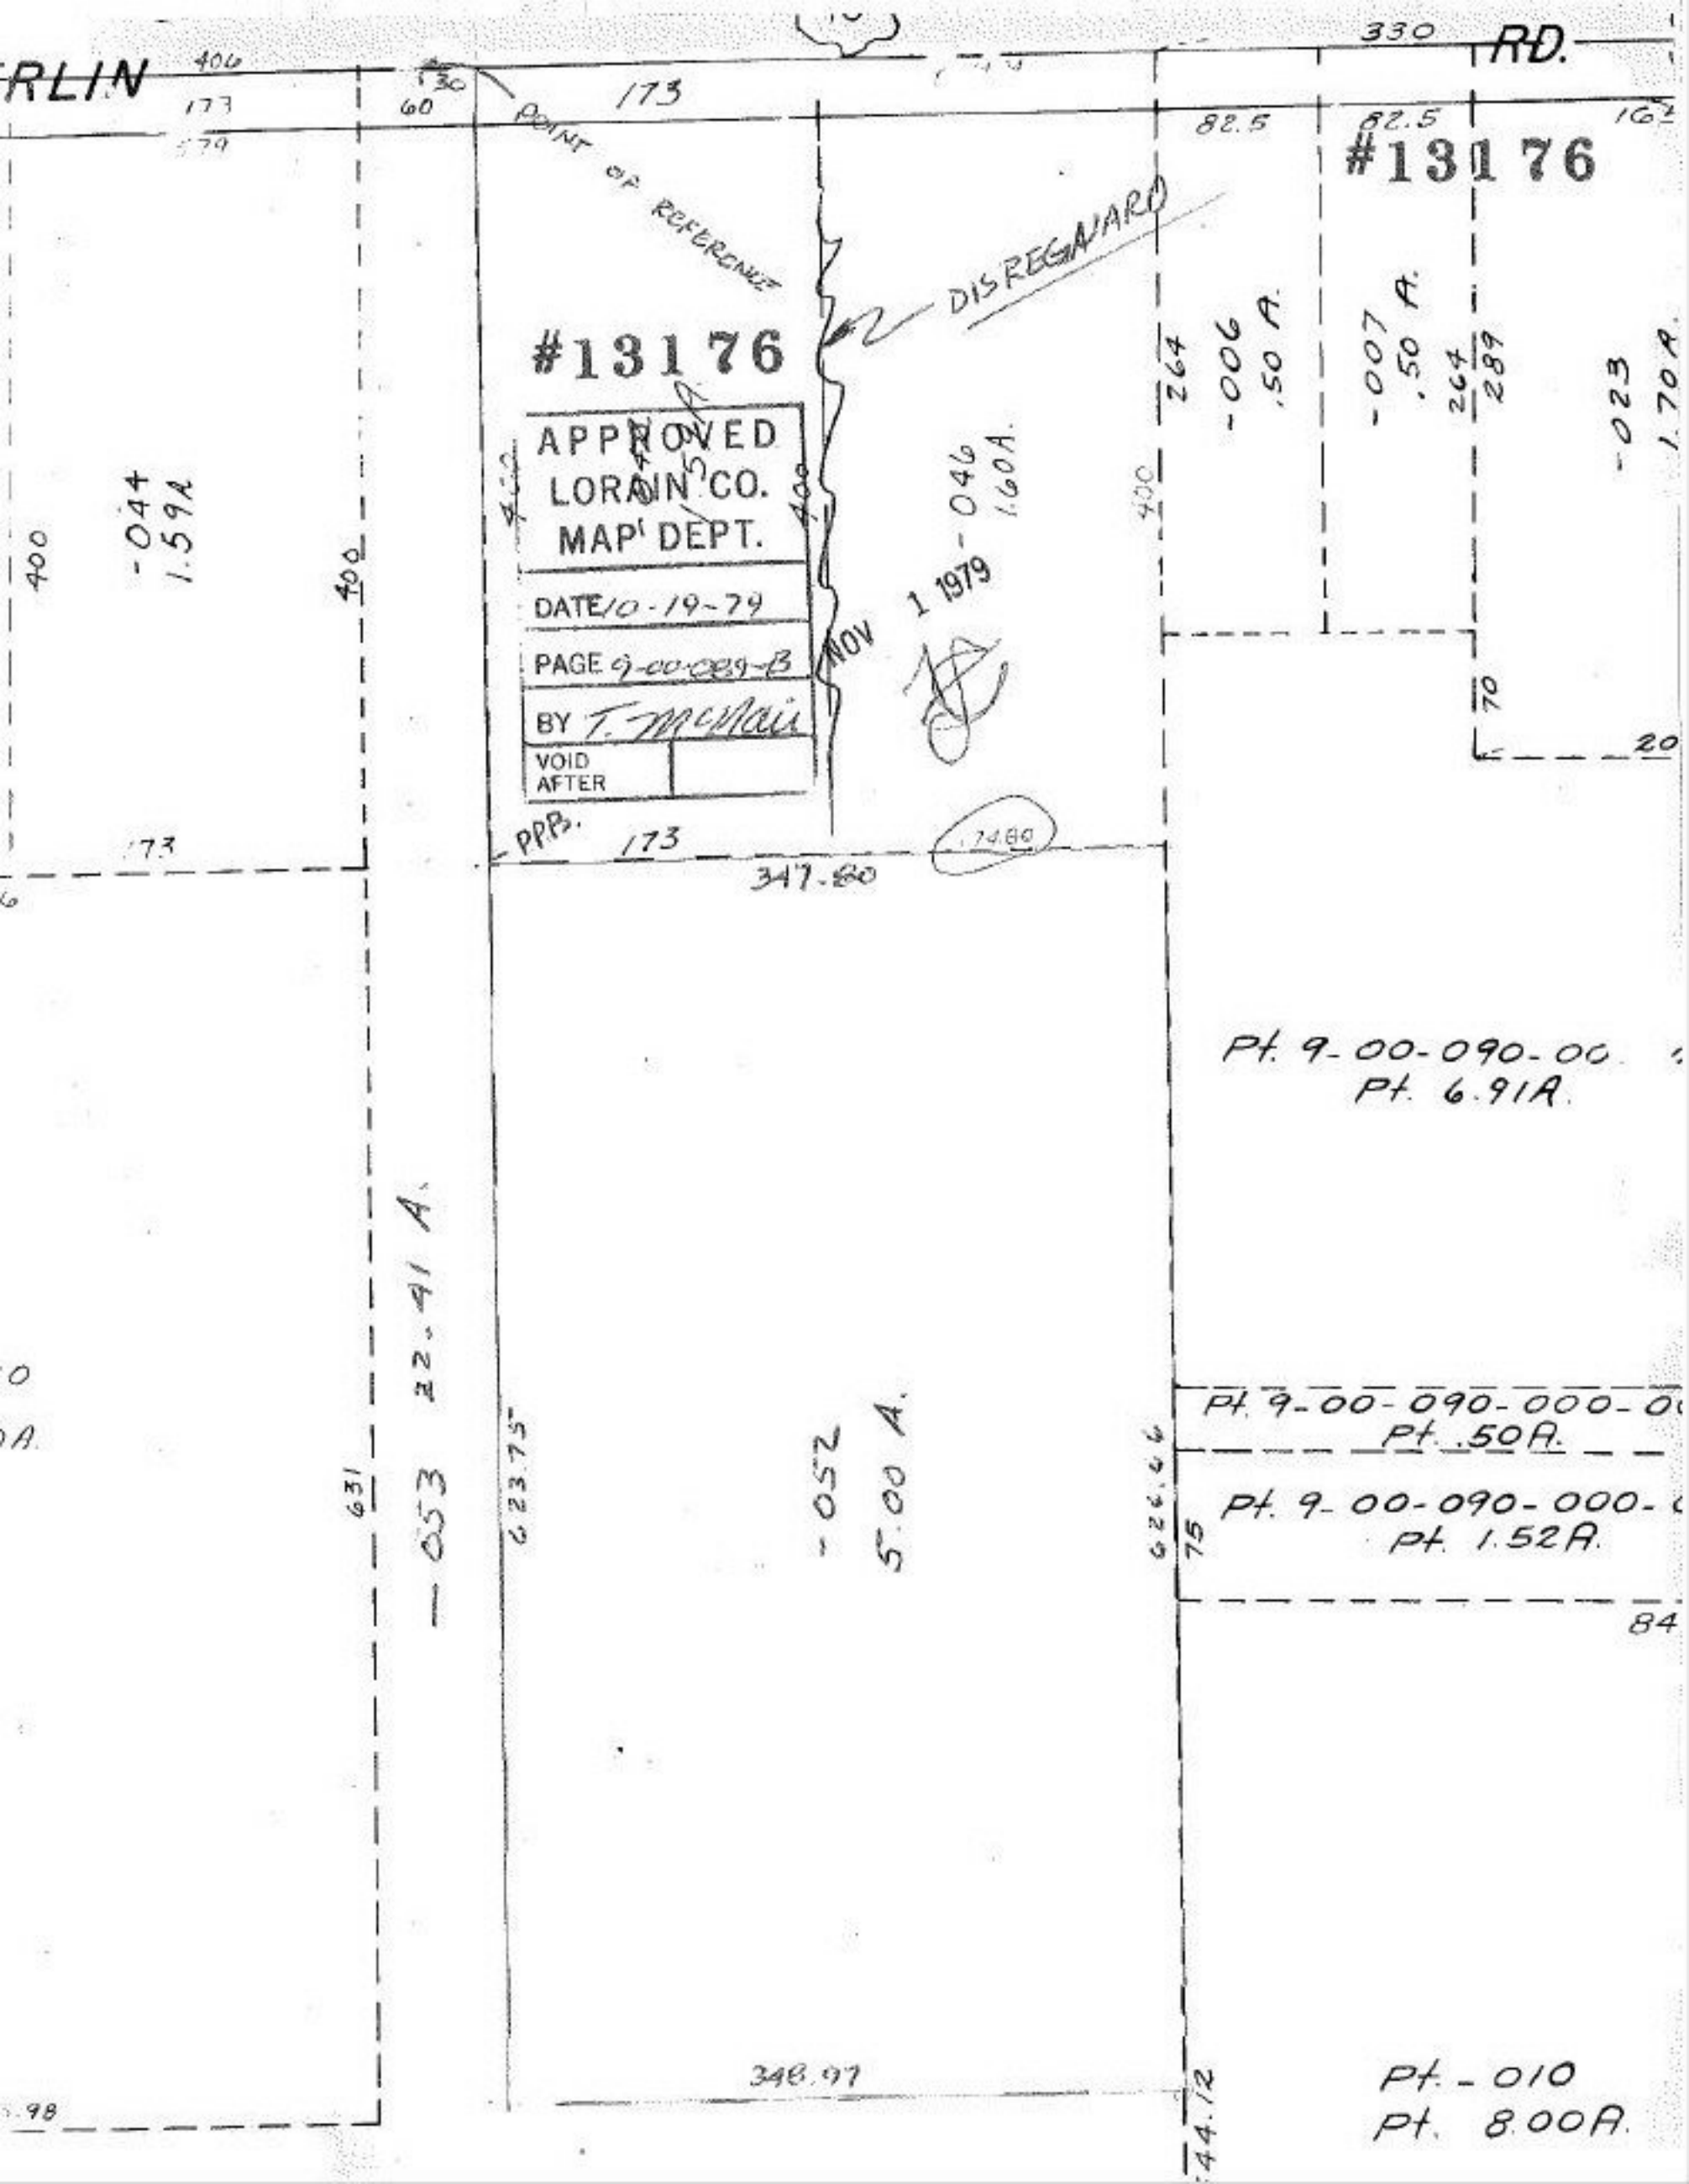

RLIN
RD.
#13176
#13176
POINT OF REFERENCE
DISREGARD
APPROVED
LORAIN CO.
MAP DEPT.
DATE 10-19-79
PAGE 9-00-089-B
BY T. McNair
VOID AFTER
NOV 1 1979
-044
1.59A
-046
1.60A.
-006
.50 A.
-007
.50 A.
-023
1.70 A.
-053
22.41 A.
-052
5.00 A.
Pt. 9-00-090-00
Pt. 6.91A.
Pt. 9-00-090-000-0
Pt. .50A.
Pt. 9-00-090-000-
Pt. 1.52A.
Pt. -010
Pt. 8.00A.
347.80
348.97