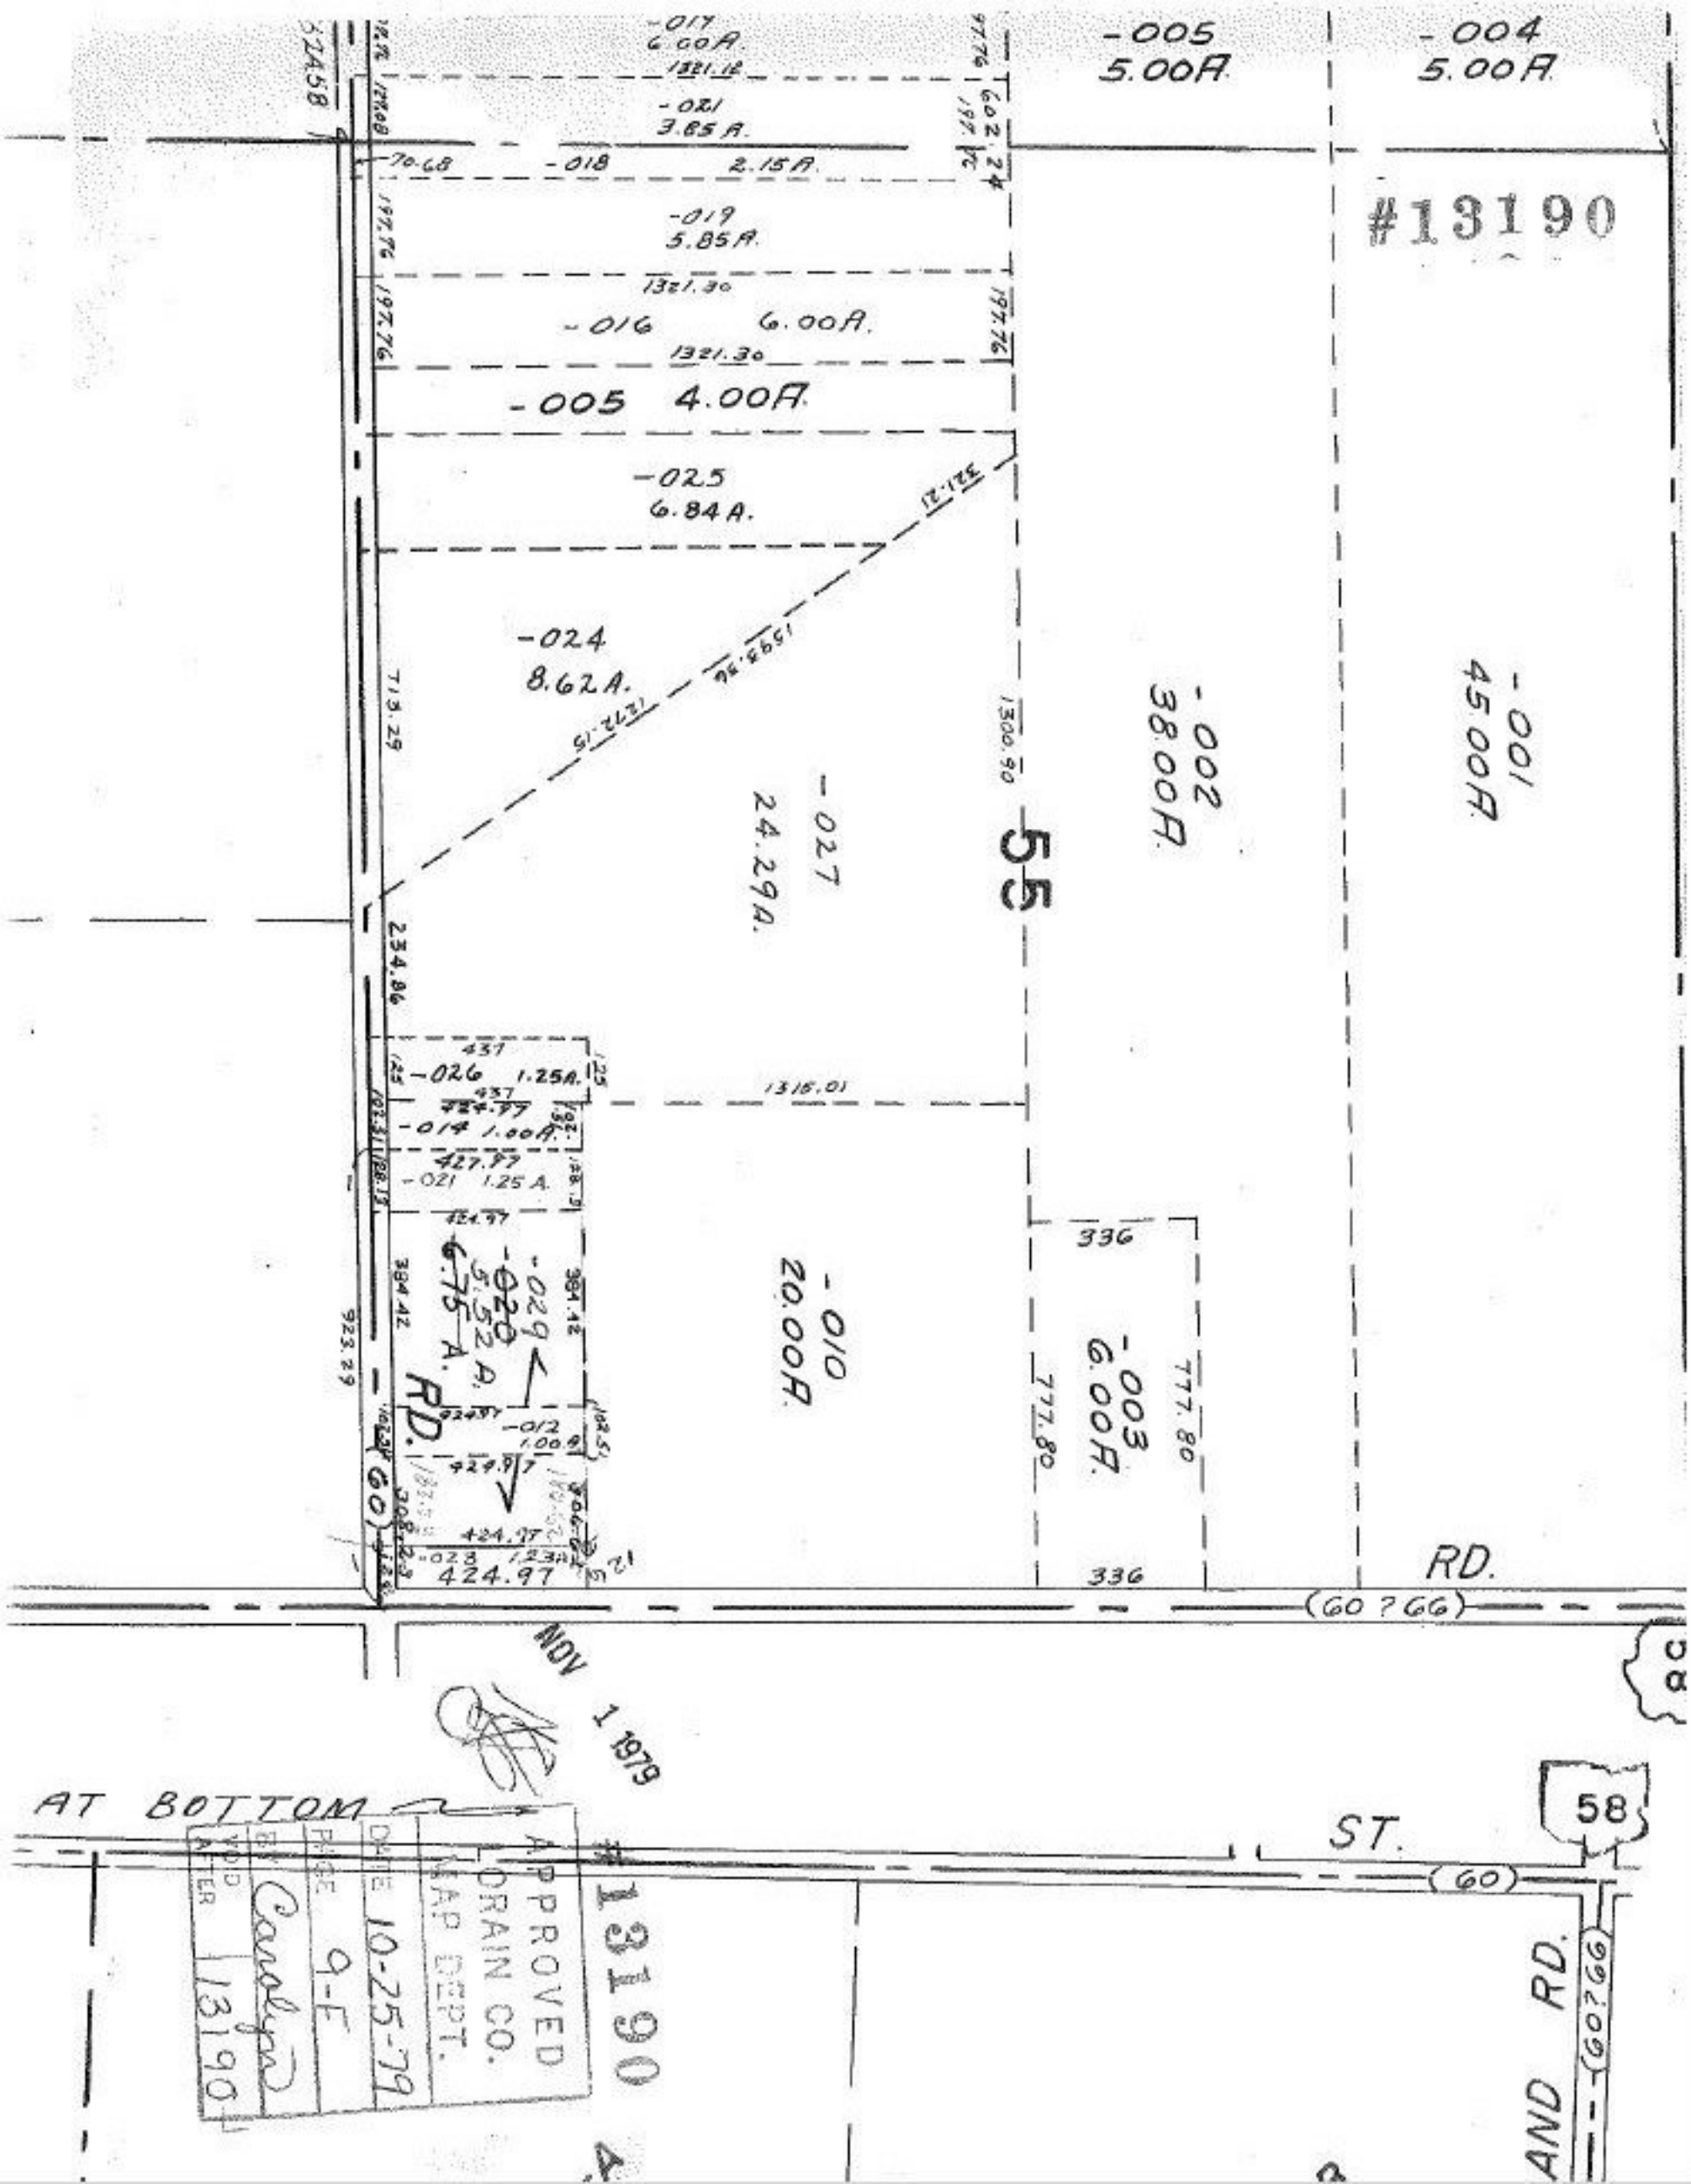

#13190
-017 6.00A.
1321.12
-021 3.85A.
-018 2.15A.
-019 5.85A.
1321.30
-016 6.00A.
1321.30
-005 4.00A.
-025 6.84A.
-024 8.62A.
1593.36
1272.15
-027 24.29A.
-005 5.00A.
-004 5.00A.
-002 38.00A.
-001 45.00A.
55
1300.90
713.29
234.86
-026 1.25A.
-014 1.00A.
-021 1.25A.
1315.01
-029 5.52A.
-020 6.75A.
-010 20.00A.
-003 6.00A.
336
777.80
RD.
(60)
-012 1.00A.
424.97
-028 1.23A.
RD.
(60 ? 66)
NOV 1 1979
AT BOTTOM
ST.
58
(60)
RD.
(60?66)
AND
APPROVED
LORAIN CO.
MAP DEPT.
DATE 10-25-79
PAGE 9-E
BY Carolyn
VOID AFTER 13190
#13190