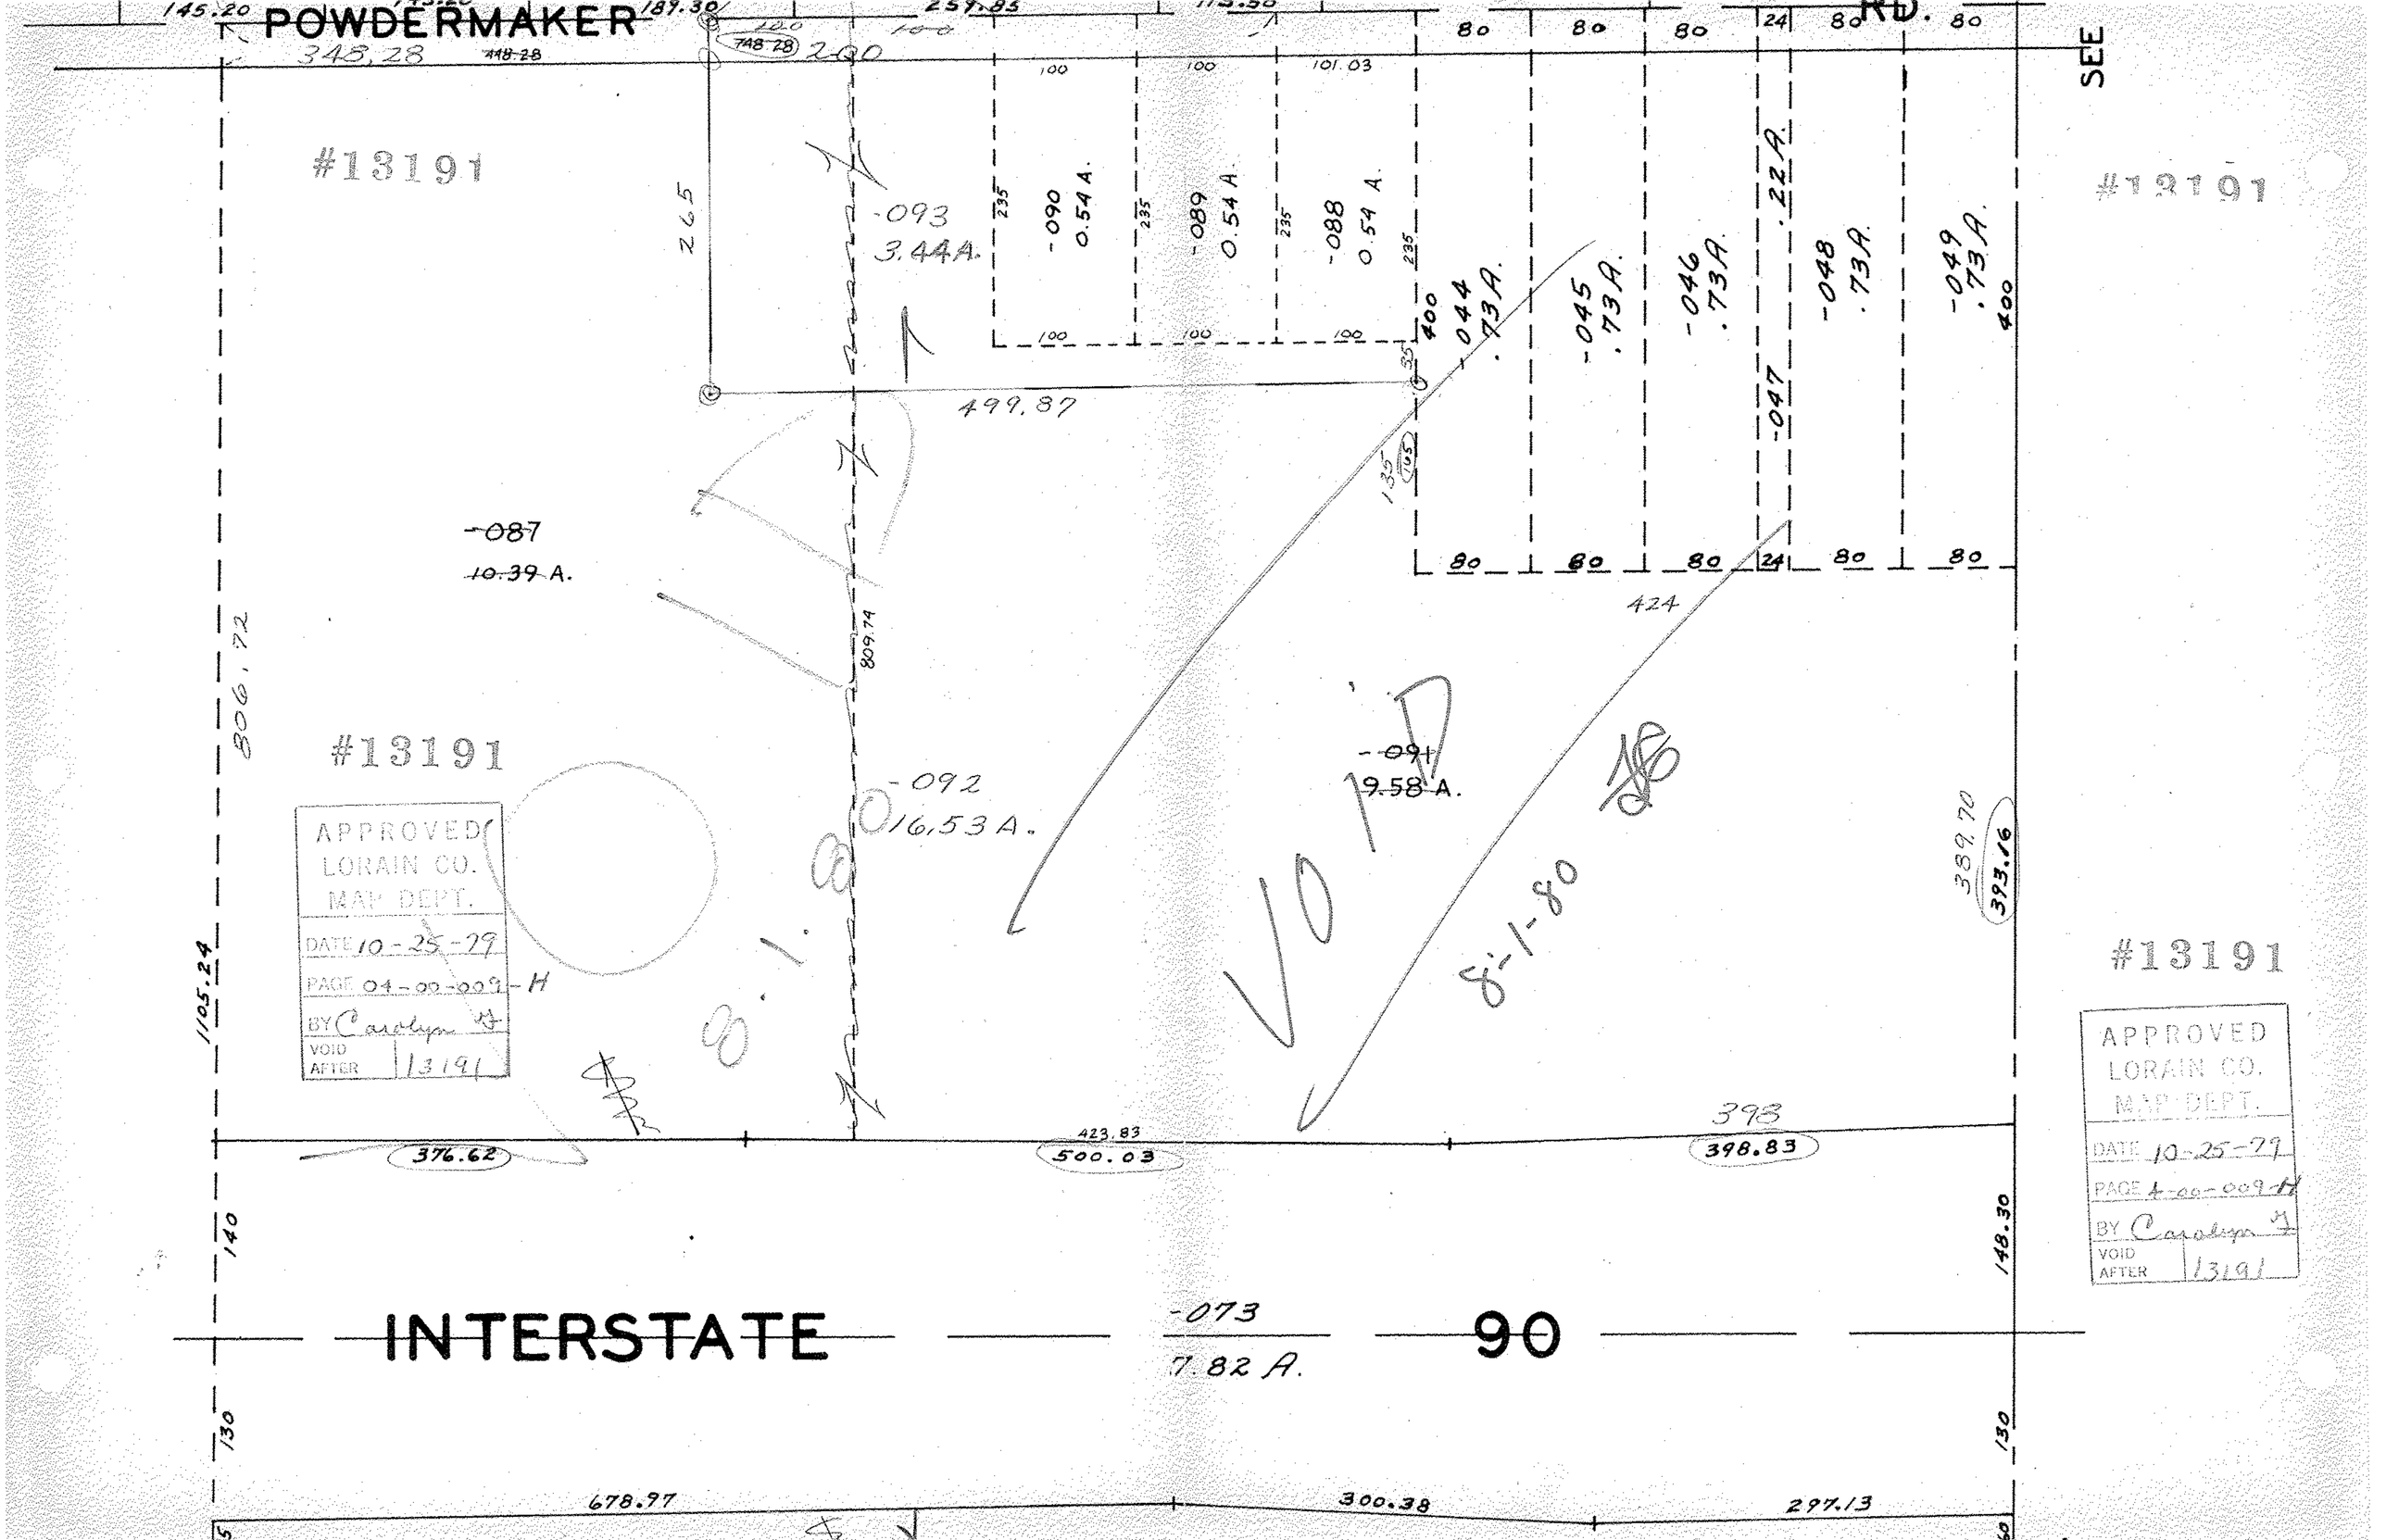

POWDERMAKER
RD.
SEE
#13191
#13191
#13191
#13191
-093
3.44A.
-090
0.54 A.
-089
0.54 A.
-088
0.54 A.
-044
.73A.
-045
.73A.
-046
.73A.
-047
.22A.
-048
.73A.
-049
.73A.
-087
10.39 A.
-092
16.53 A.
-091
9.58 A.
-073
7.82 A.
VOID
8-1-80
8-1-80
INTERSTATE
90
348.28
499.87
806.72
1105.24
376.62
500.03
398.83
423.83
398
389.70
393.16
148.30
678.97
300.38
297.13
APPROVED
LORAIN CO.
MAP DEPT.
DATE 10-25-79
PAGE 04-00-009-H
BY Carolyn
VOID AFTER 13191
APPROVED
LORAIN CO.
MAP DEPT.
DATE 10-25-79
PAGE 4-00-009-H
BY Carolyn
VOID AFTER 13191