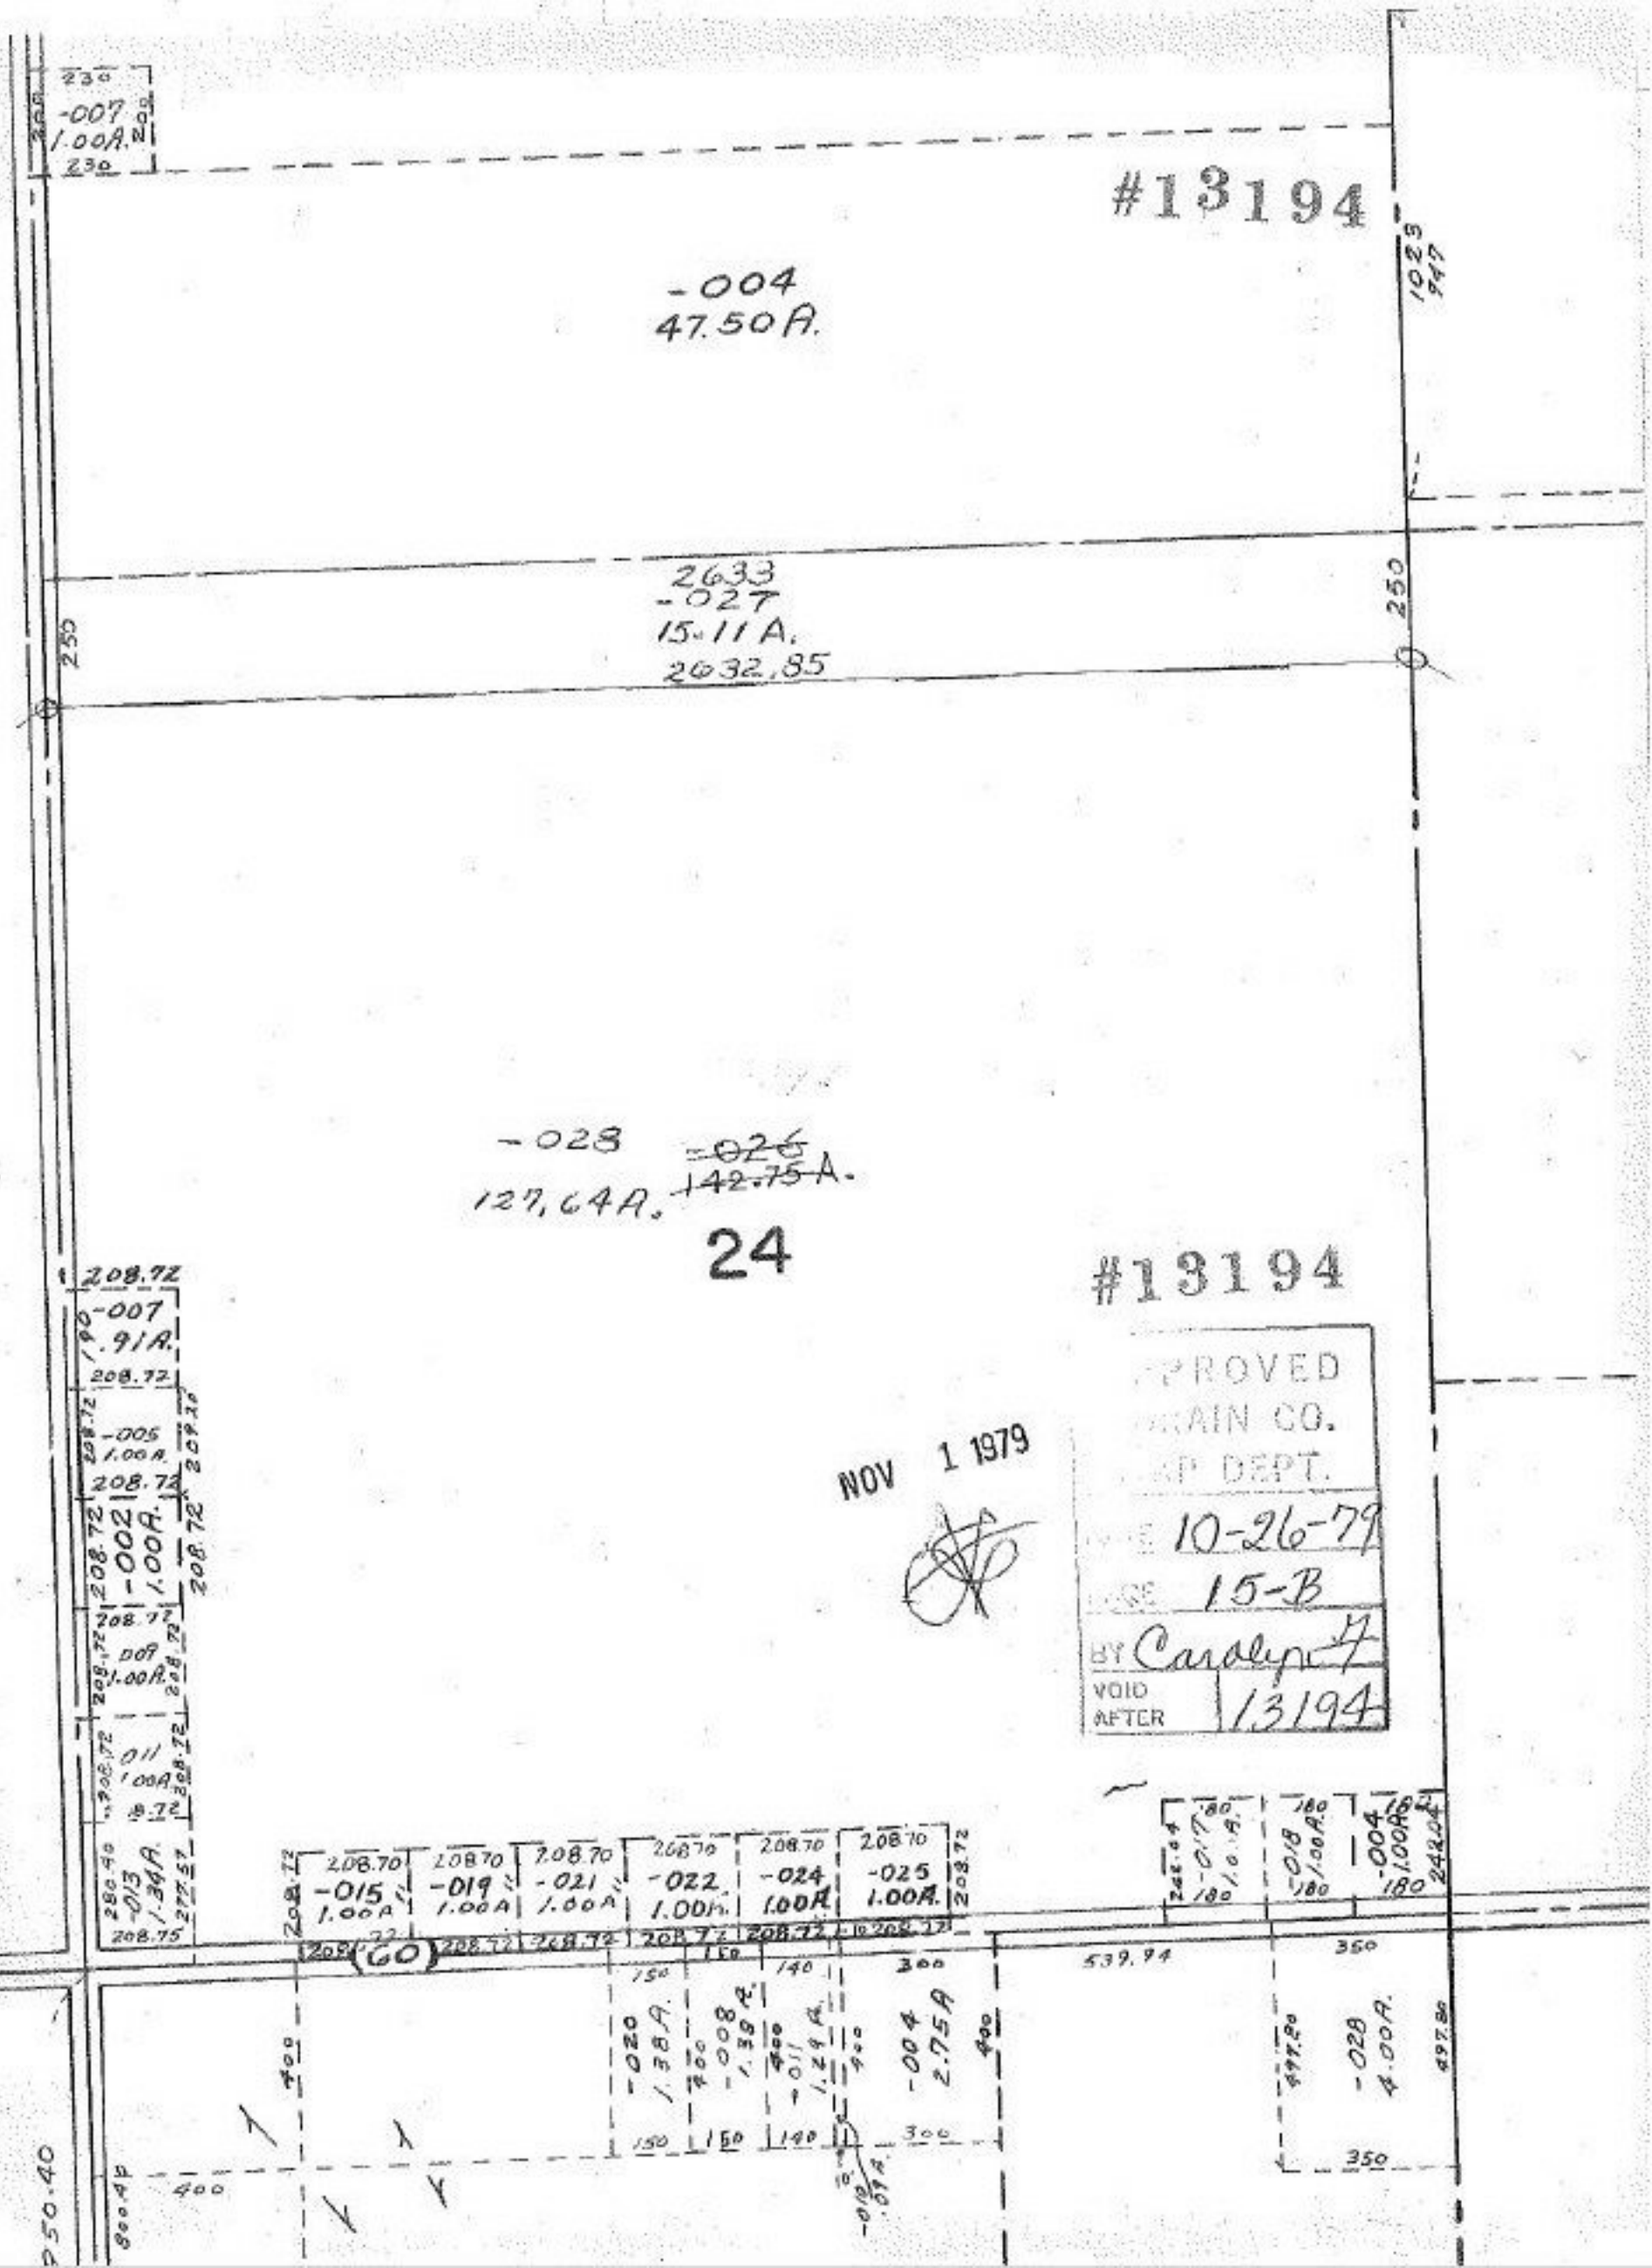

#13194
-004
47.50A.
2633
-027
15.11 A.
2632.85
-028
127.64A.
~~-026~~
~~142.75~~ A.
24
#13194
NOV 1 1979
APPROVED
DRAIN CO.
DEPT.
10-26-79
15-B
BY Carolyn
VOID AFTER 13194
-007
1.00A.
-005
1.00A.
-002
1.00A.
-009
1.00A.
-011
1.00A.
-013
1.34A.
-015
1.00A
-019
1.00A
-021
1.00A
-022
1.00A.
-024
1.00A
-025
1.00A.
-017
1.0A.
-018
1.00A.
-004
1.00A.
-020
1.38A.
-008
1.38A.
-011
1.29A.
-004
2.75A
-028
4.00A.
539.94