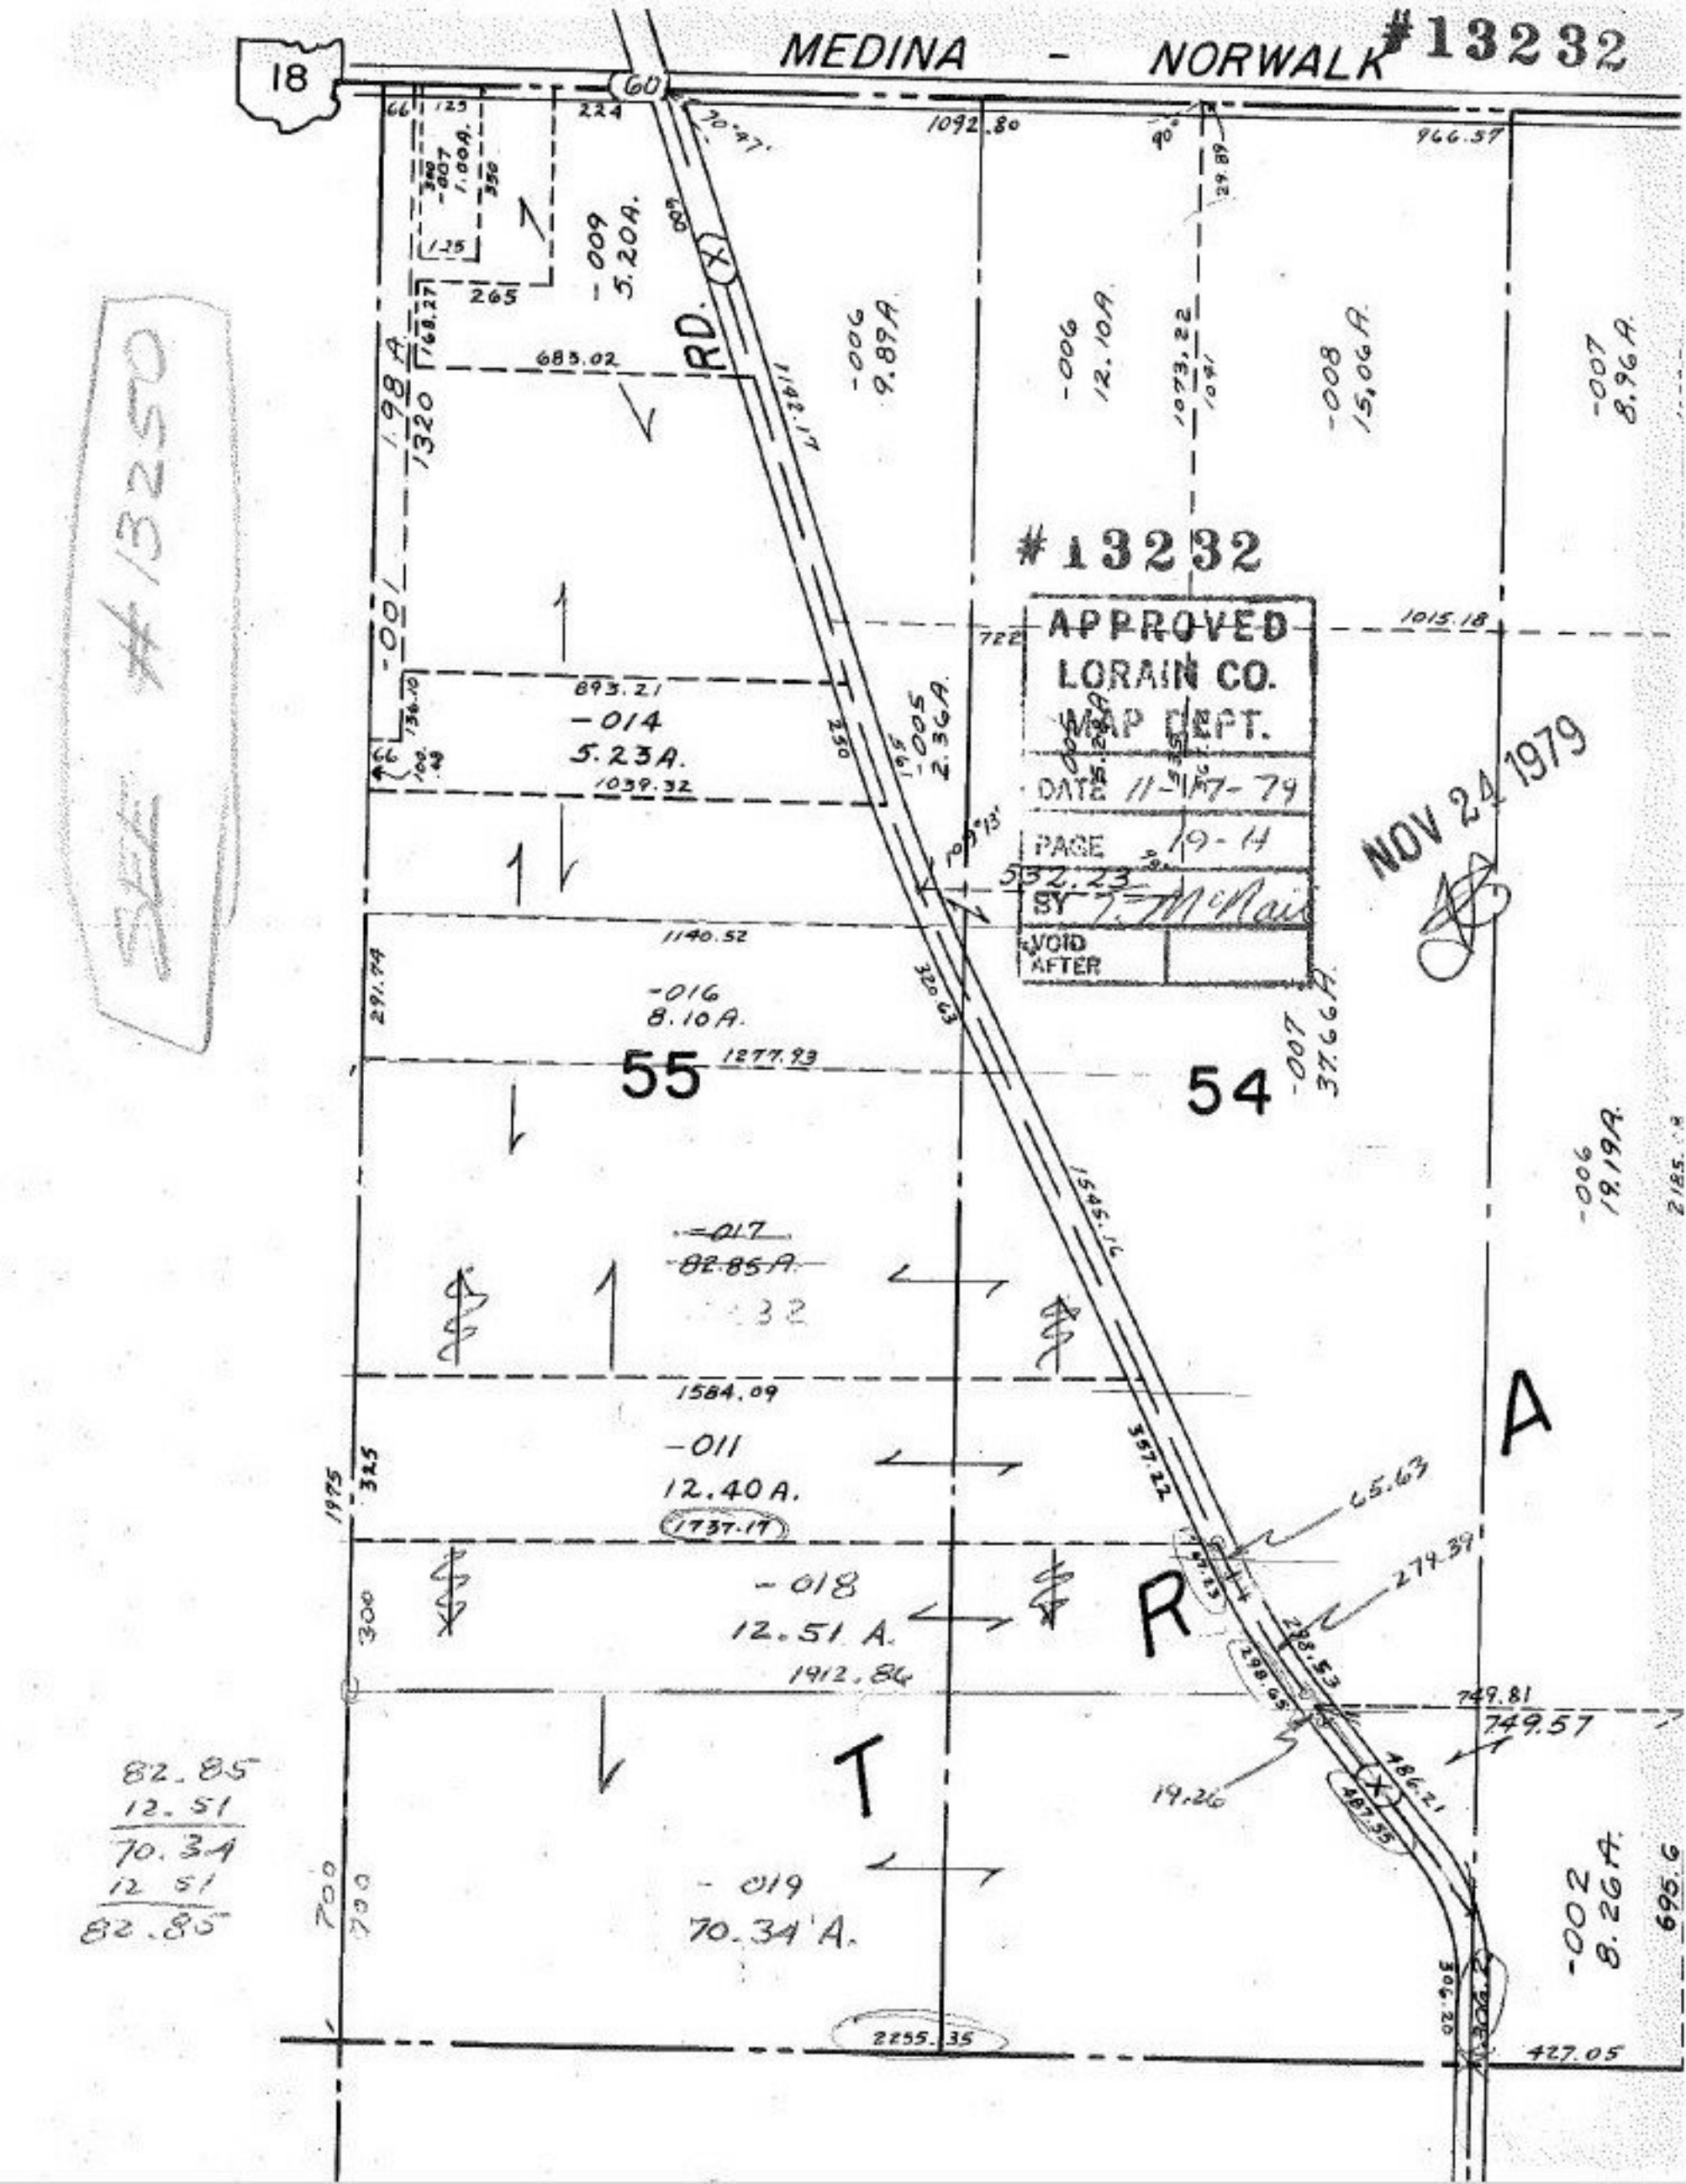

18
MEDINA - NORWALK
#13232
60
RD.
#13232
APPROVED
LORAIN CO.
MAP DEPT.
DATE 11-17-79
PAGE 19-14
BY T. McNair
VOID AFTER
NOV 24 1979
-009 5.20A.
-006 9.89A.
-006 12.10A.
-008 15.06A.
-007 8.96A.
-001 1.98A.
-014 5.23A.
-005 2.36A.
-016 8.10A.
-007 37.66A.
-006 19.19A.
-017 82.85A.
-011 12.40A.
-018 12.51 A.
-019 70.34 A.
-002 8.26A.
55
54
T
R
A
1092.80
966.57
1015.18
1140.52
1277.93
1584.09
1912.86
2255.35
427.05
749.81
749.57
65.63
274.39
19.26
82.85
12.51
70.34
12.51
82.85