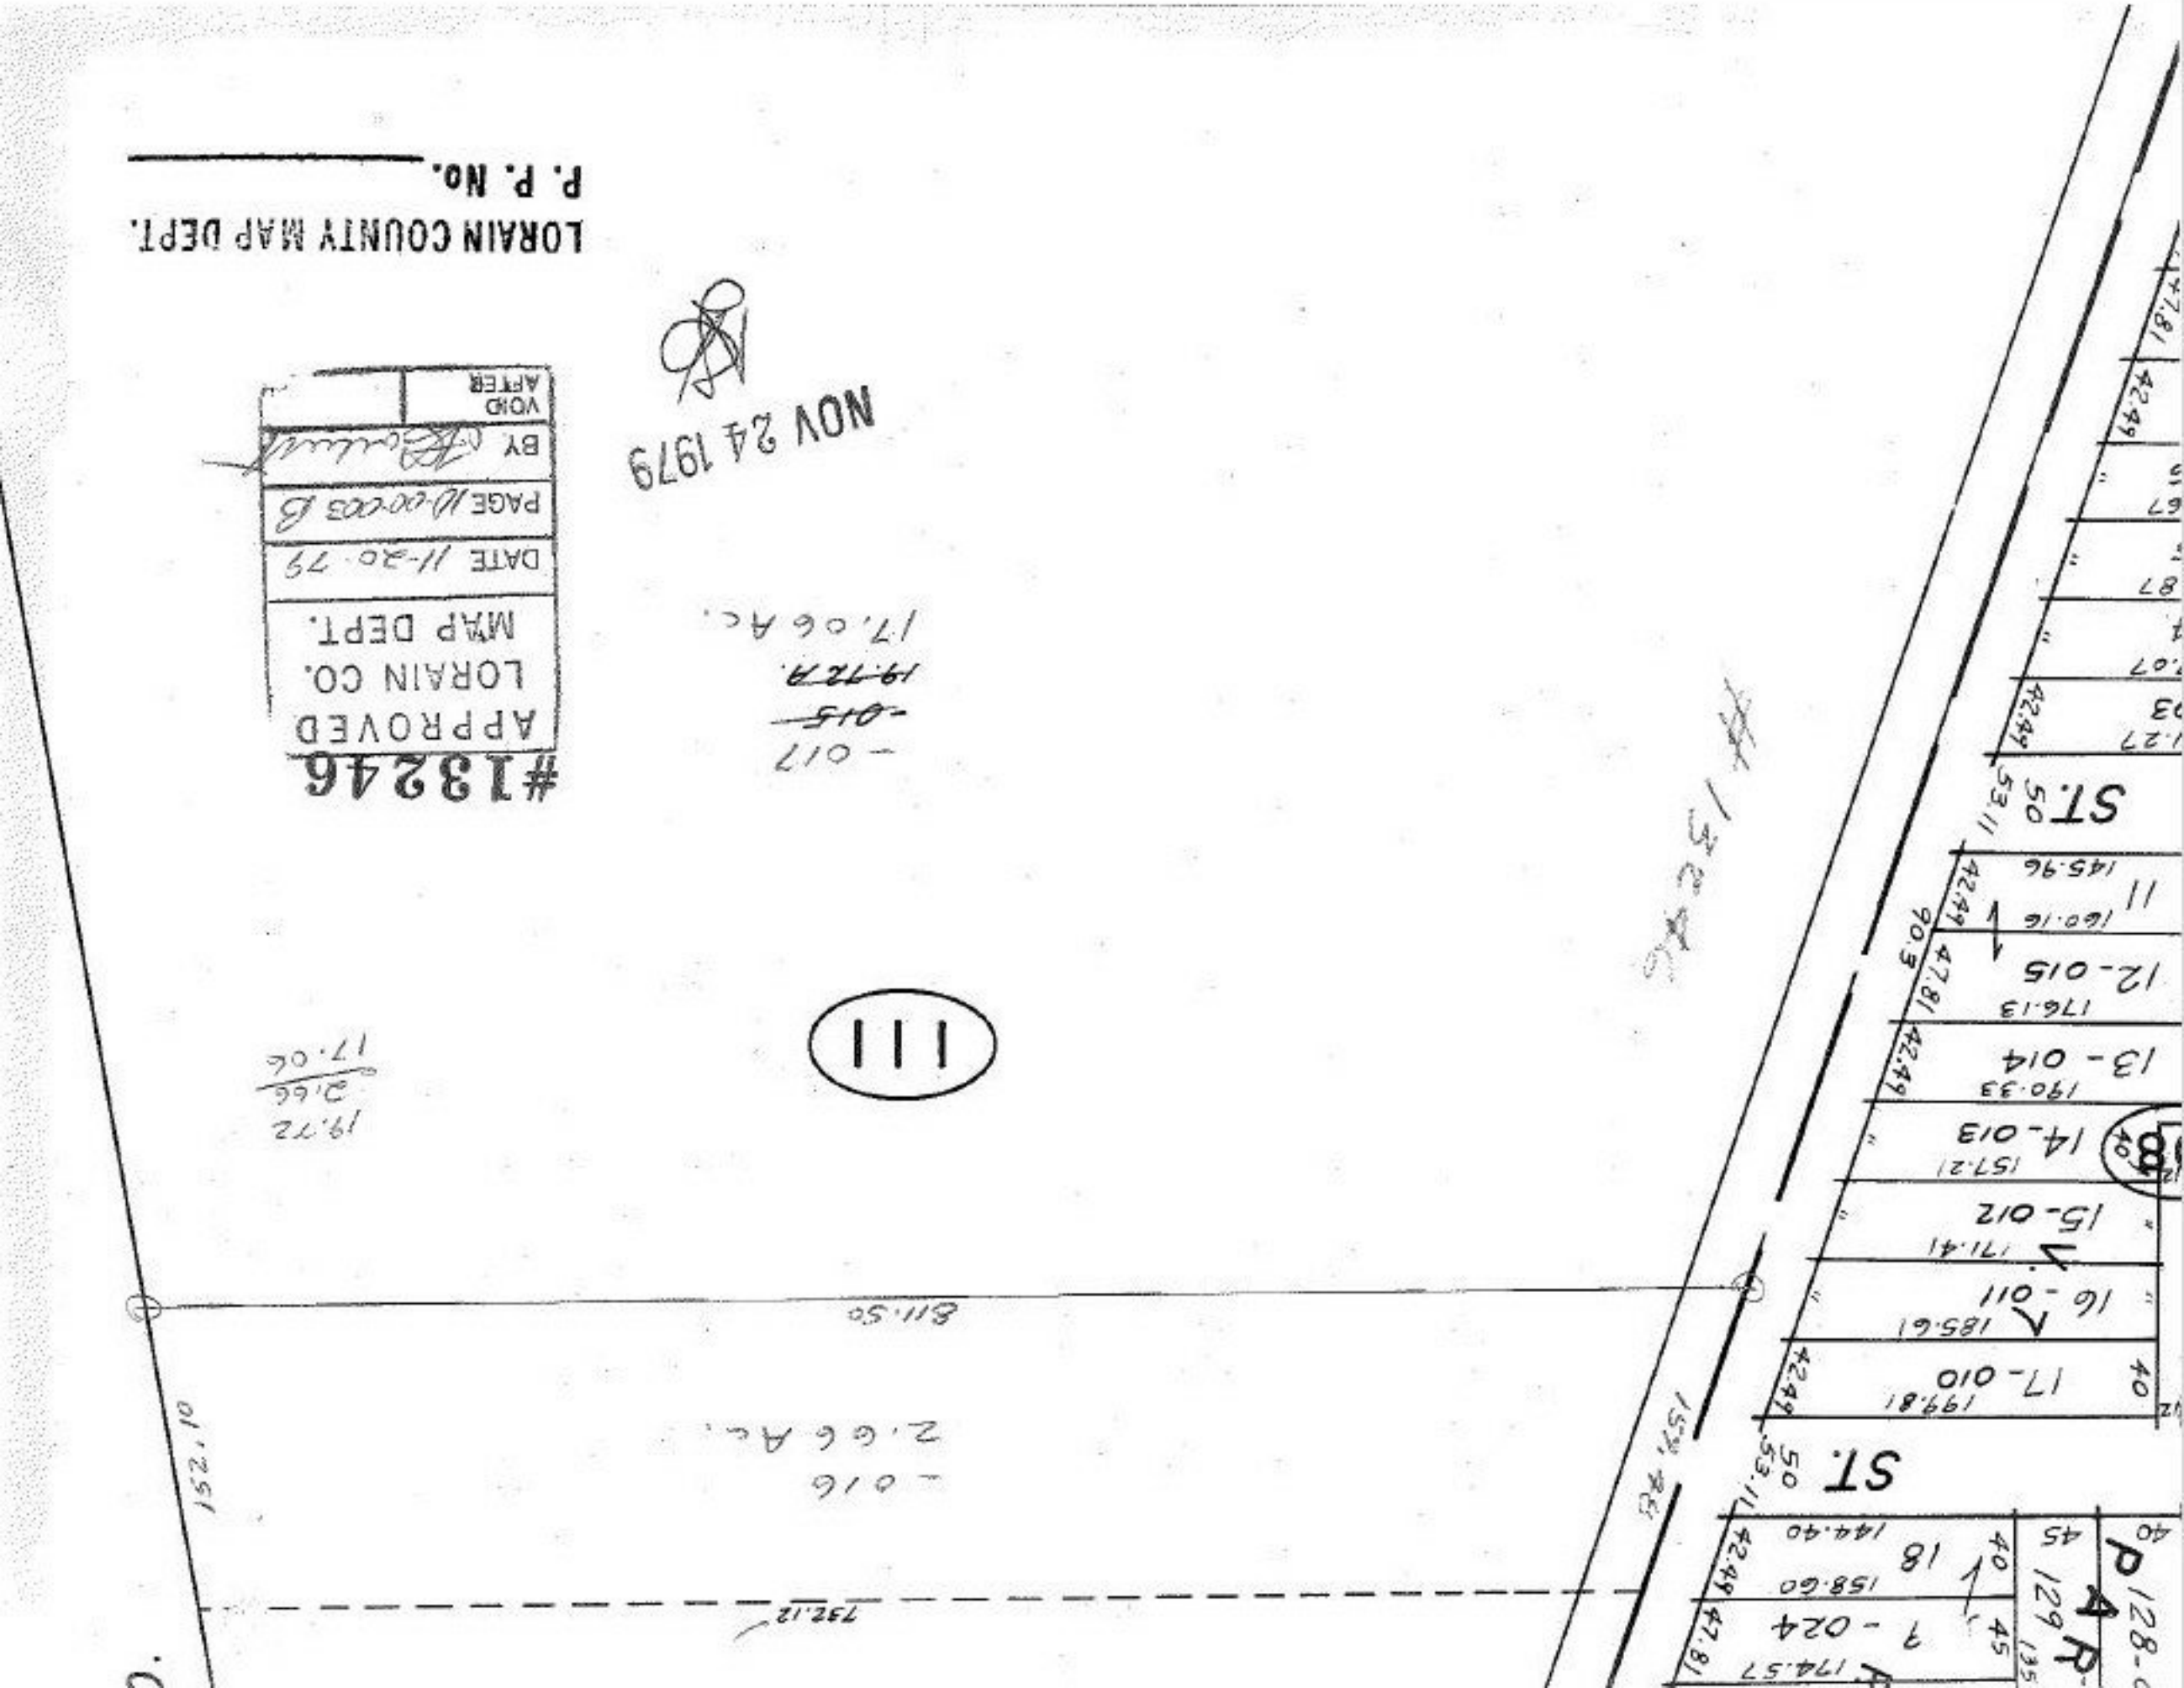

LORAIN COUNTY MAP DEPT.
P. P. No.
#13246
APPROVED
LORAIN CO.
MAP DEPT.
DATE 11-20-79
PAGE 10-00-003 B
BY
VOID AFTER
NOV 24 1979
-017
~~-015~~
~~19.72 A.~~
17.06 Ac.
111
19.72
2.66
17.06
811.50
-016
2.66 Ac.
152.10
732.12
159.48
#13246
ST.
ST.
PAR
12-015
13-014
14-013
15-012
16-011
17-010
18
9-024