#13252

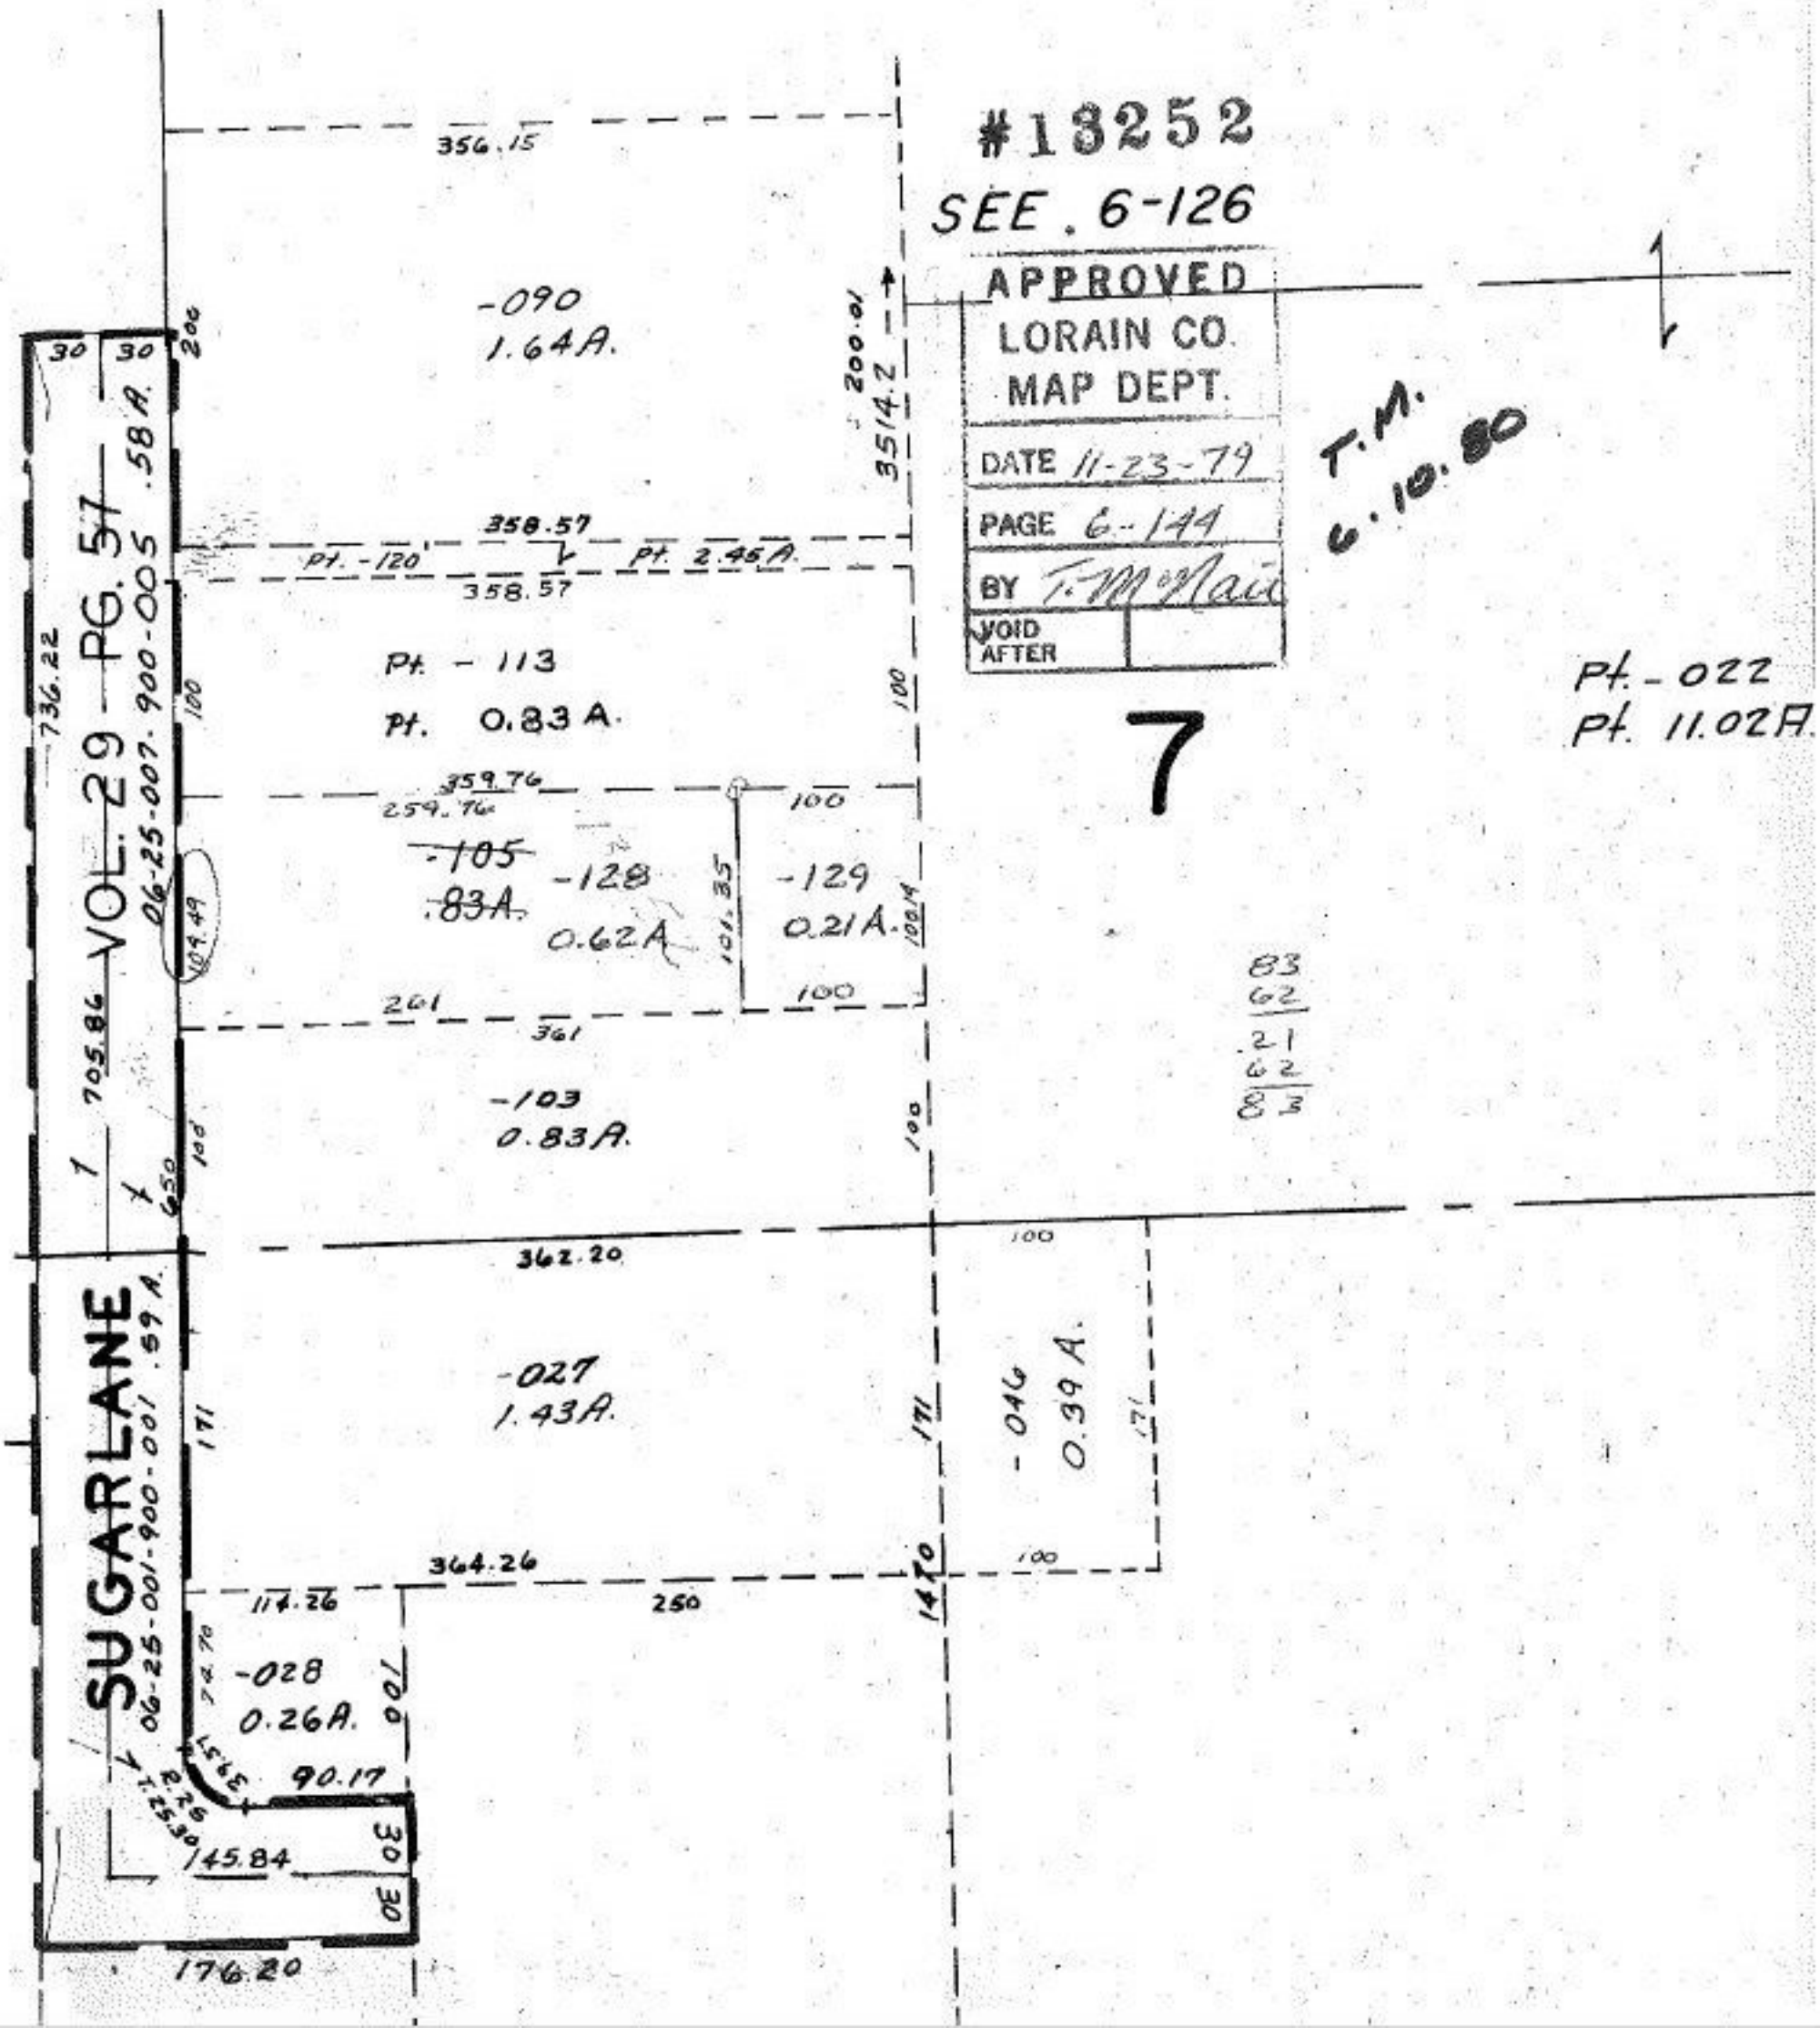

#13252
SEE. 6-126
APPROVED
LORAIN CO.
MAP DEPT.
DATE 11-23-79
PAGE 6-144
BY T. McNair
VOID AFTER
T.M.
6.10.80
7
Pt. - 022
Pt. 11.02A.
356.15
-090
1.64A.
200.01
3514.2
358.57
Pt. -120
Pt. 2.45A.
358.57
Pt. - 113
Pt. 0.83 A.
359.76
259.76
-105
.83A.
-128
0.62A
-129
0.21A.
101.35
100.14
261
361
-103
0.83A.
83
62
21
62
83
362.20
-027
1.43A.
-046
0.39 A.
364.26
114.26
250
1470
-028
0.26A.
90.17
145.84
176.20
736.22
705.86
VOL. 29 PG. 57
06-25-007-900-005 .58 A.
06-25-001-900-001 .59 A.
SUGARLANE