#13253

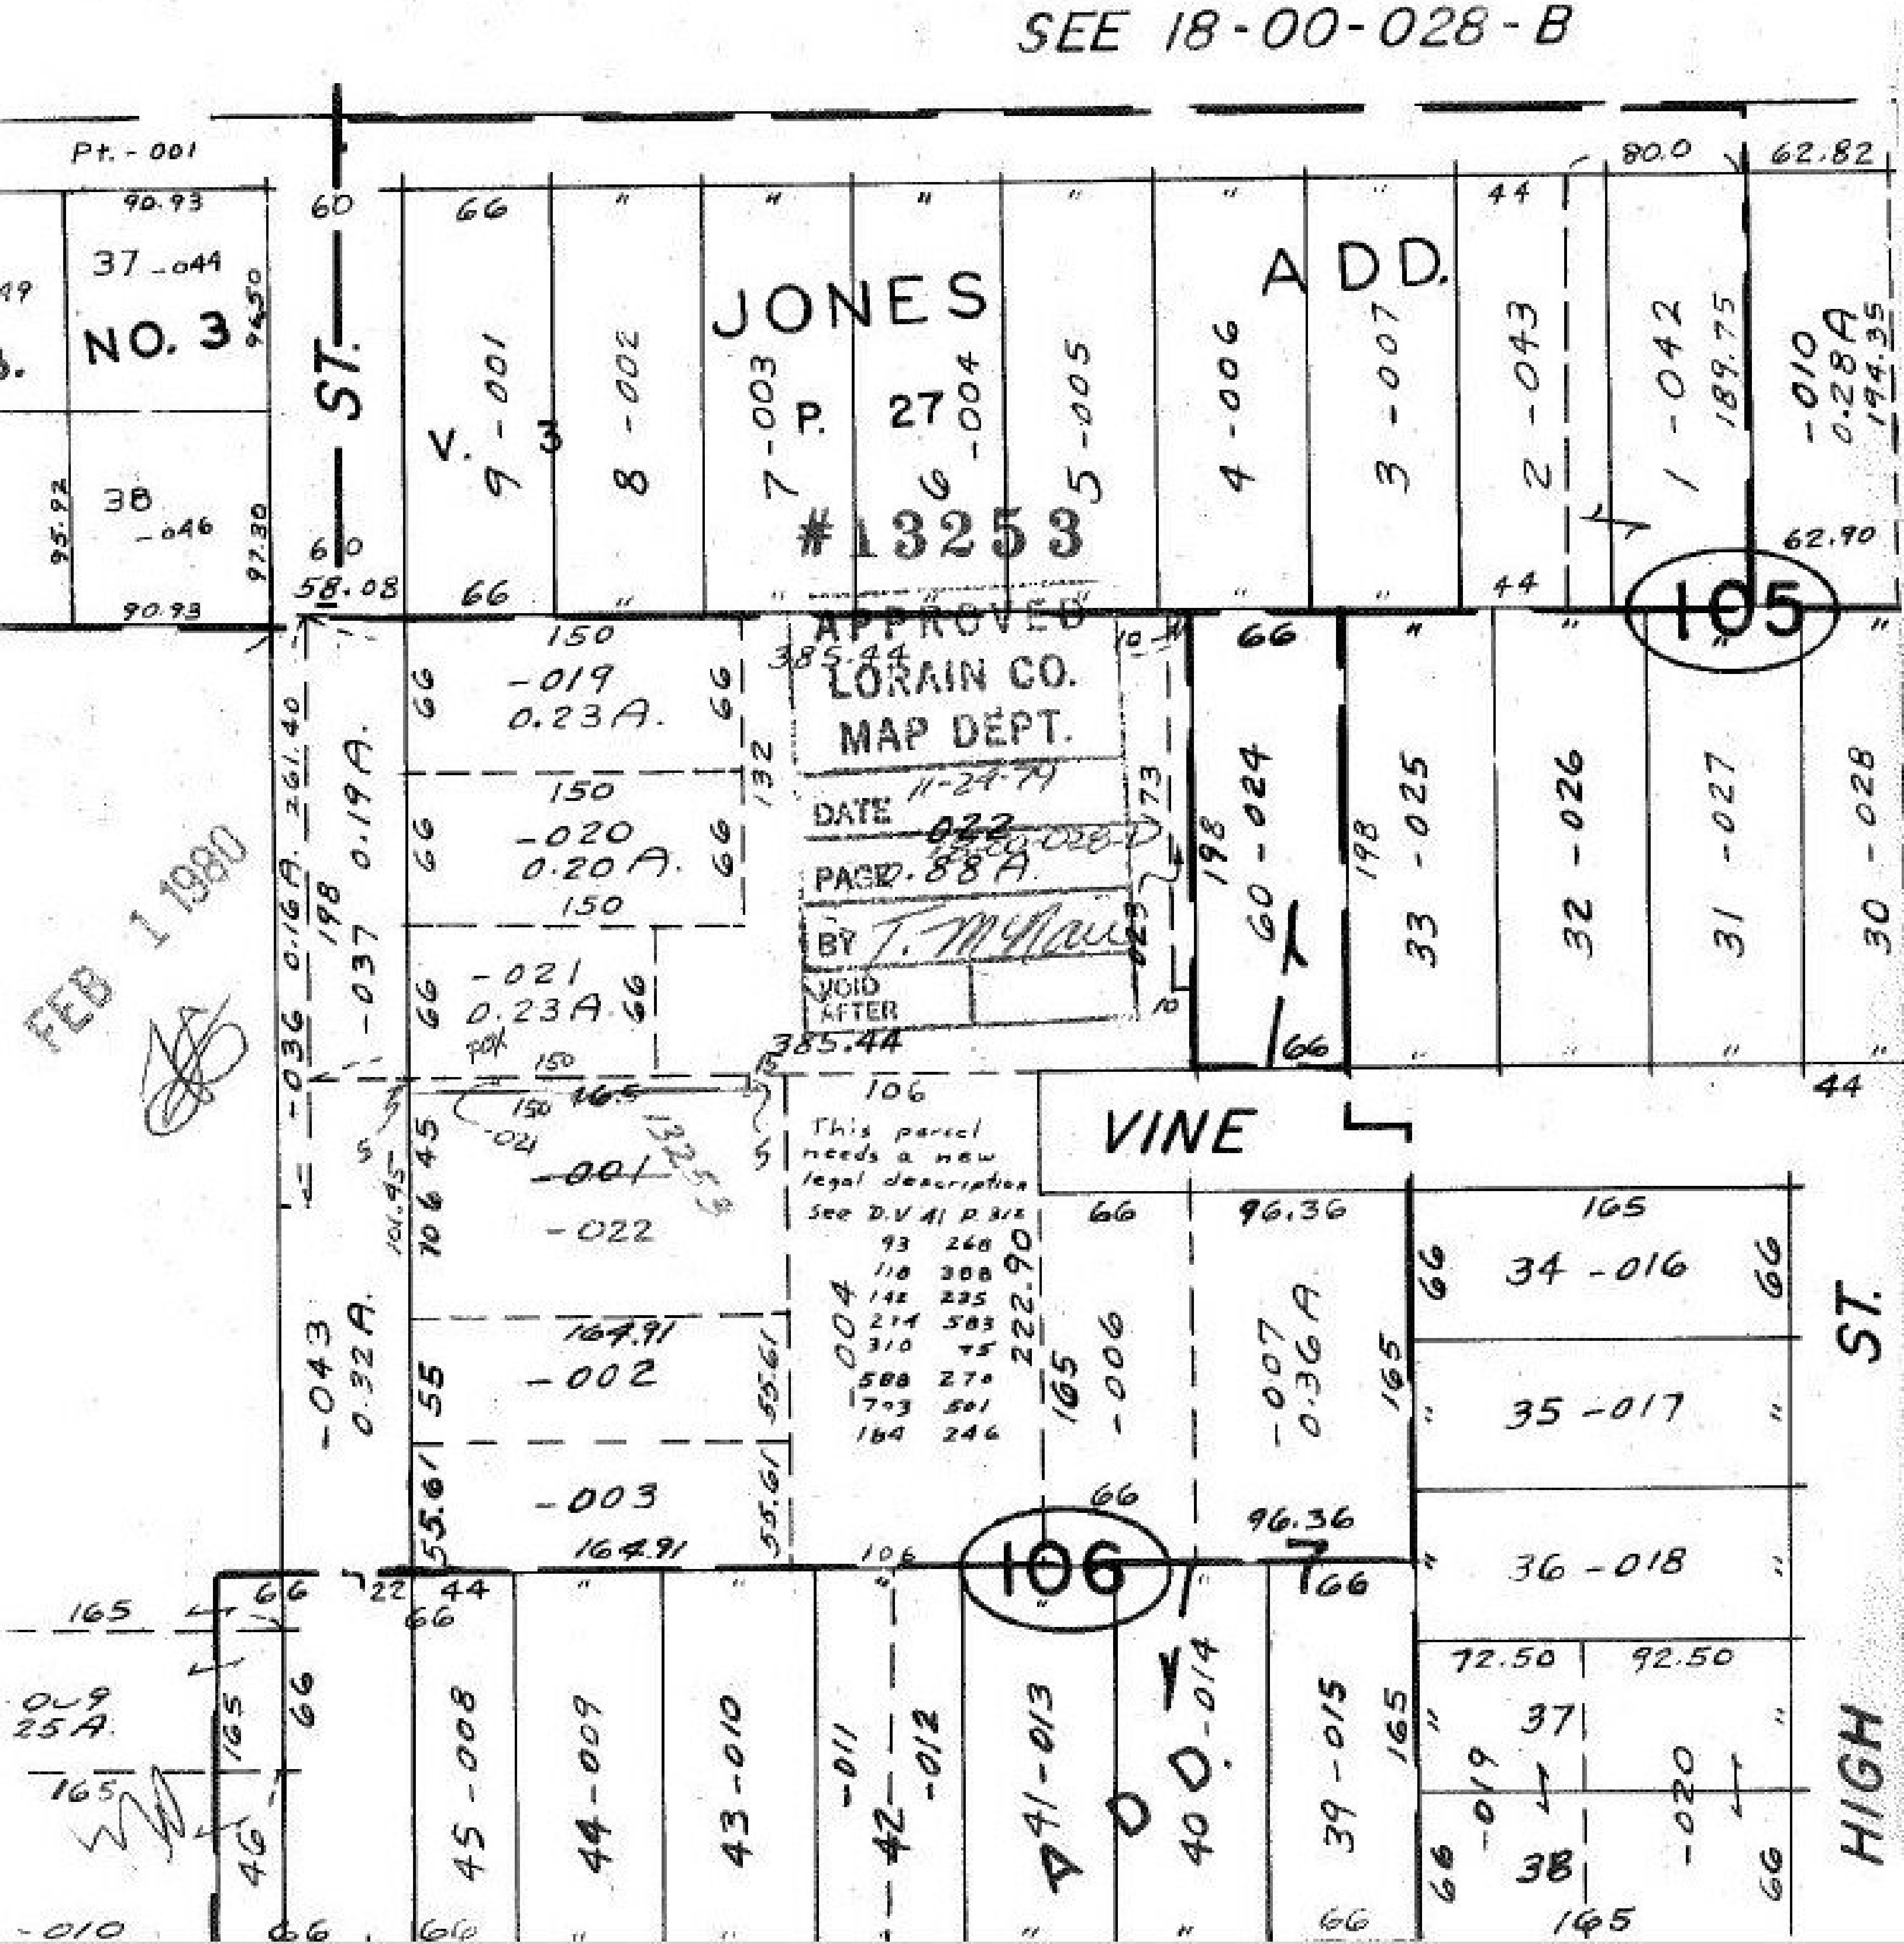

SEE 18-00-028-B
Pt. - 001
37 -044
NO. 3
38 -046
ST.
JONES ADD.
V. 3 P. 27
9 -001
8 -002
7 -003
6 -004
5 -005
4 -006
3 -007
2 -043
1 -042
-010 0.28A
#13253
APPROVED
LORAIN CO.
MAP DEPT.
DATE 11-24-79
PAGE 88A
BY T. McNair
VOID AFTER
385.44
105
-019 0.23A.
-020 0.20A.
-021 0.23A
-036 0.16A.
-037 0.19A.
60 -024
33 -025
32 -026
31 -027
30 -028
VINE
106
This parcel needs a new legal description
See D.V 41 P. 312
-001
-022
-002
-003
-004
-043 0.32A.
-006
-007 0.36A
34 -016
35 -017
36 -018
37 -019
38 -020
HIGH ST.
45 -008
44 -009
43 -010
-011
42 -012
41 -013
40 -014
39 -015
ADD.
-009 .25A.
FEB 1 1980