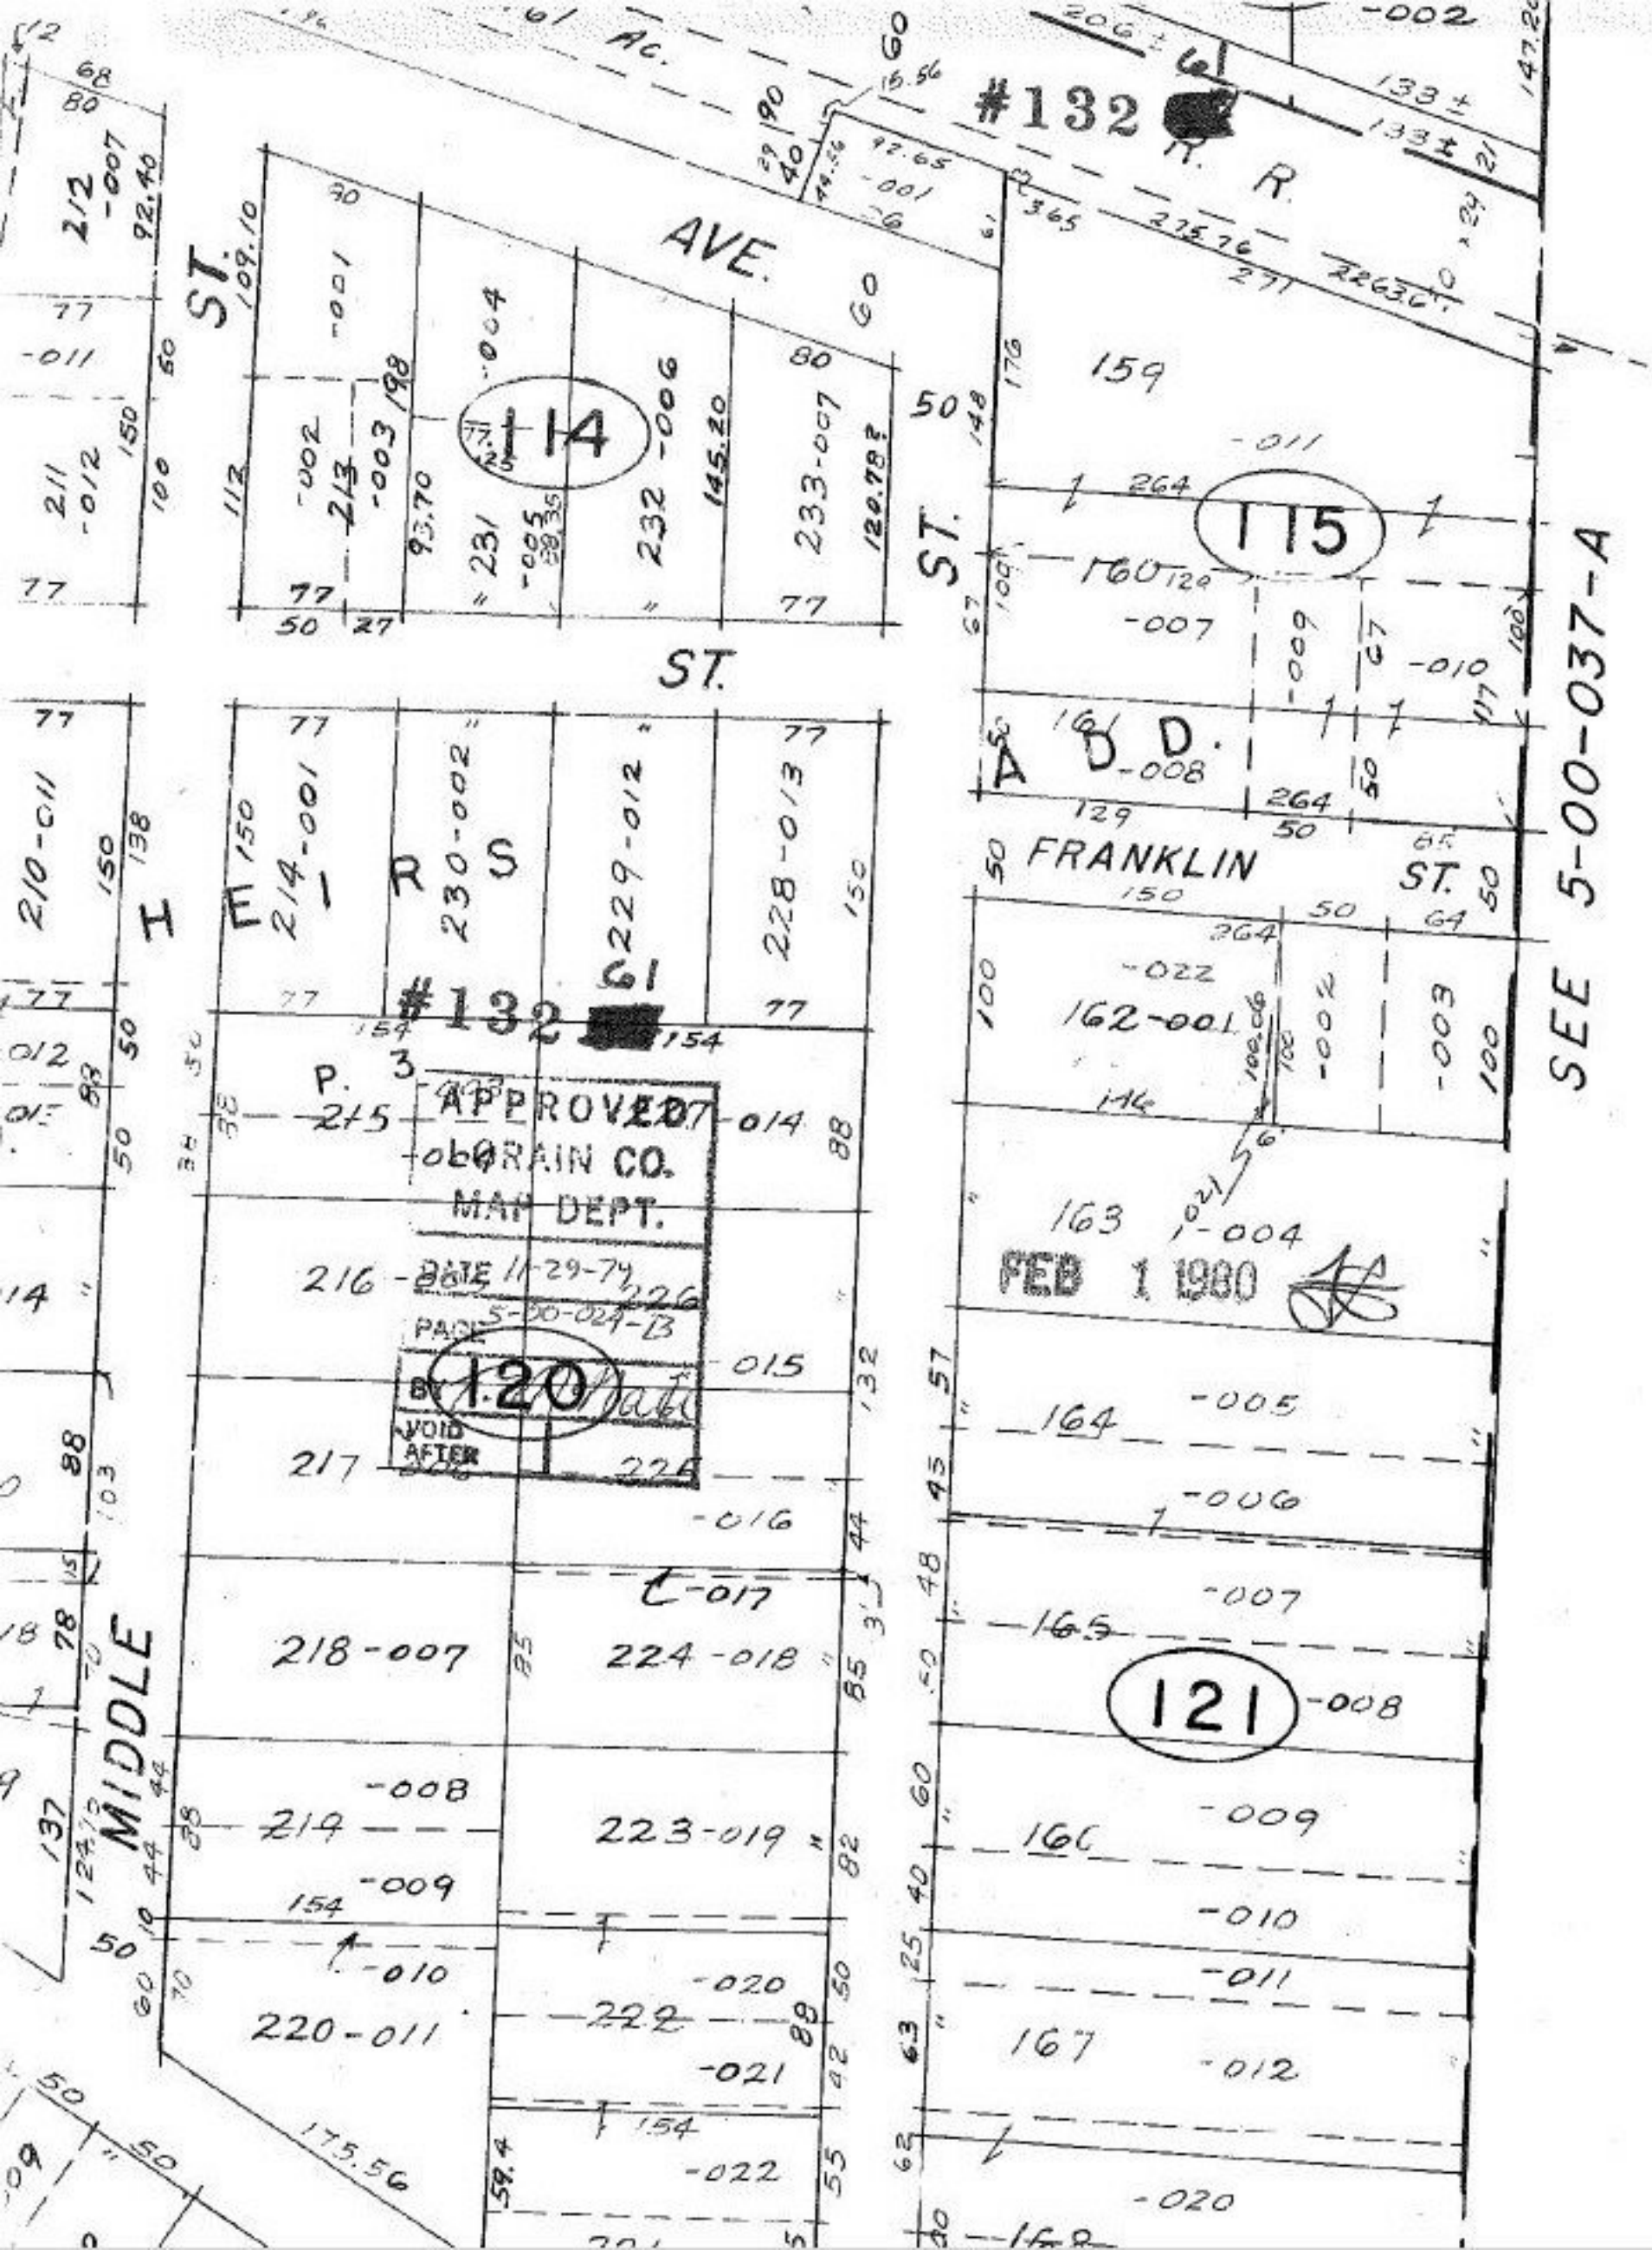

#132
R. R.
AVE.
ST.
114
115
ADD.
FRANKLIN ST.
HEIRS
#132
61
P. 3
APPROVED
LORAIN CO.
MAP DEPT.
DATE 11-29-74
PAGE 5-00-024-B
BY
VOID AFTER
120
121
MIDDLE
SEE 5-00-037-A
FEB 1 1980