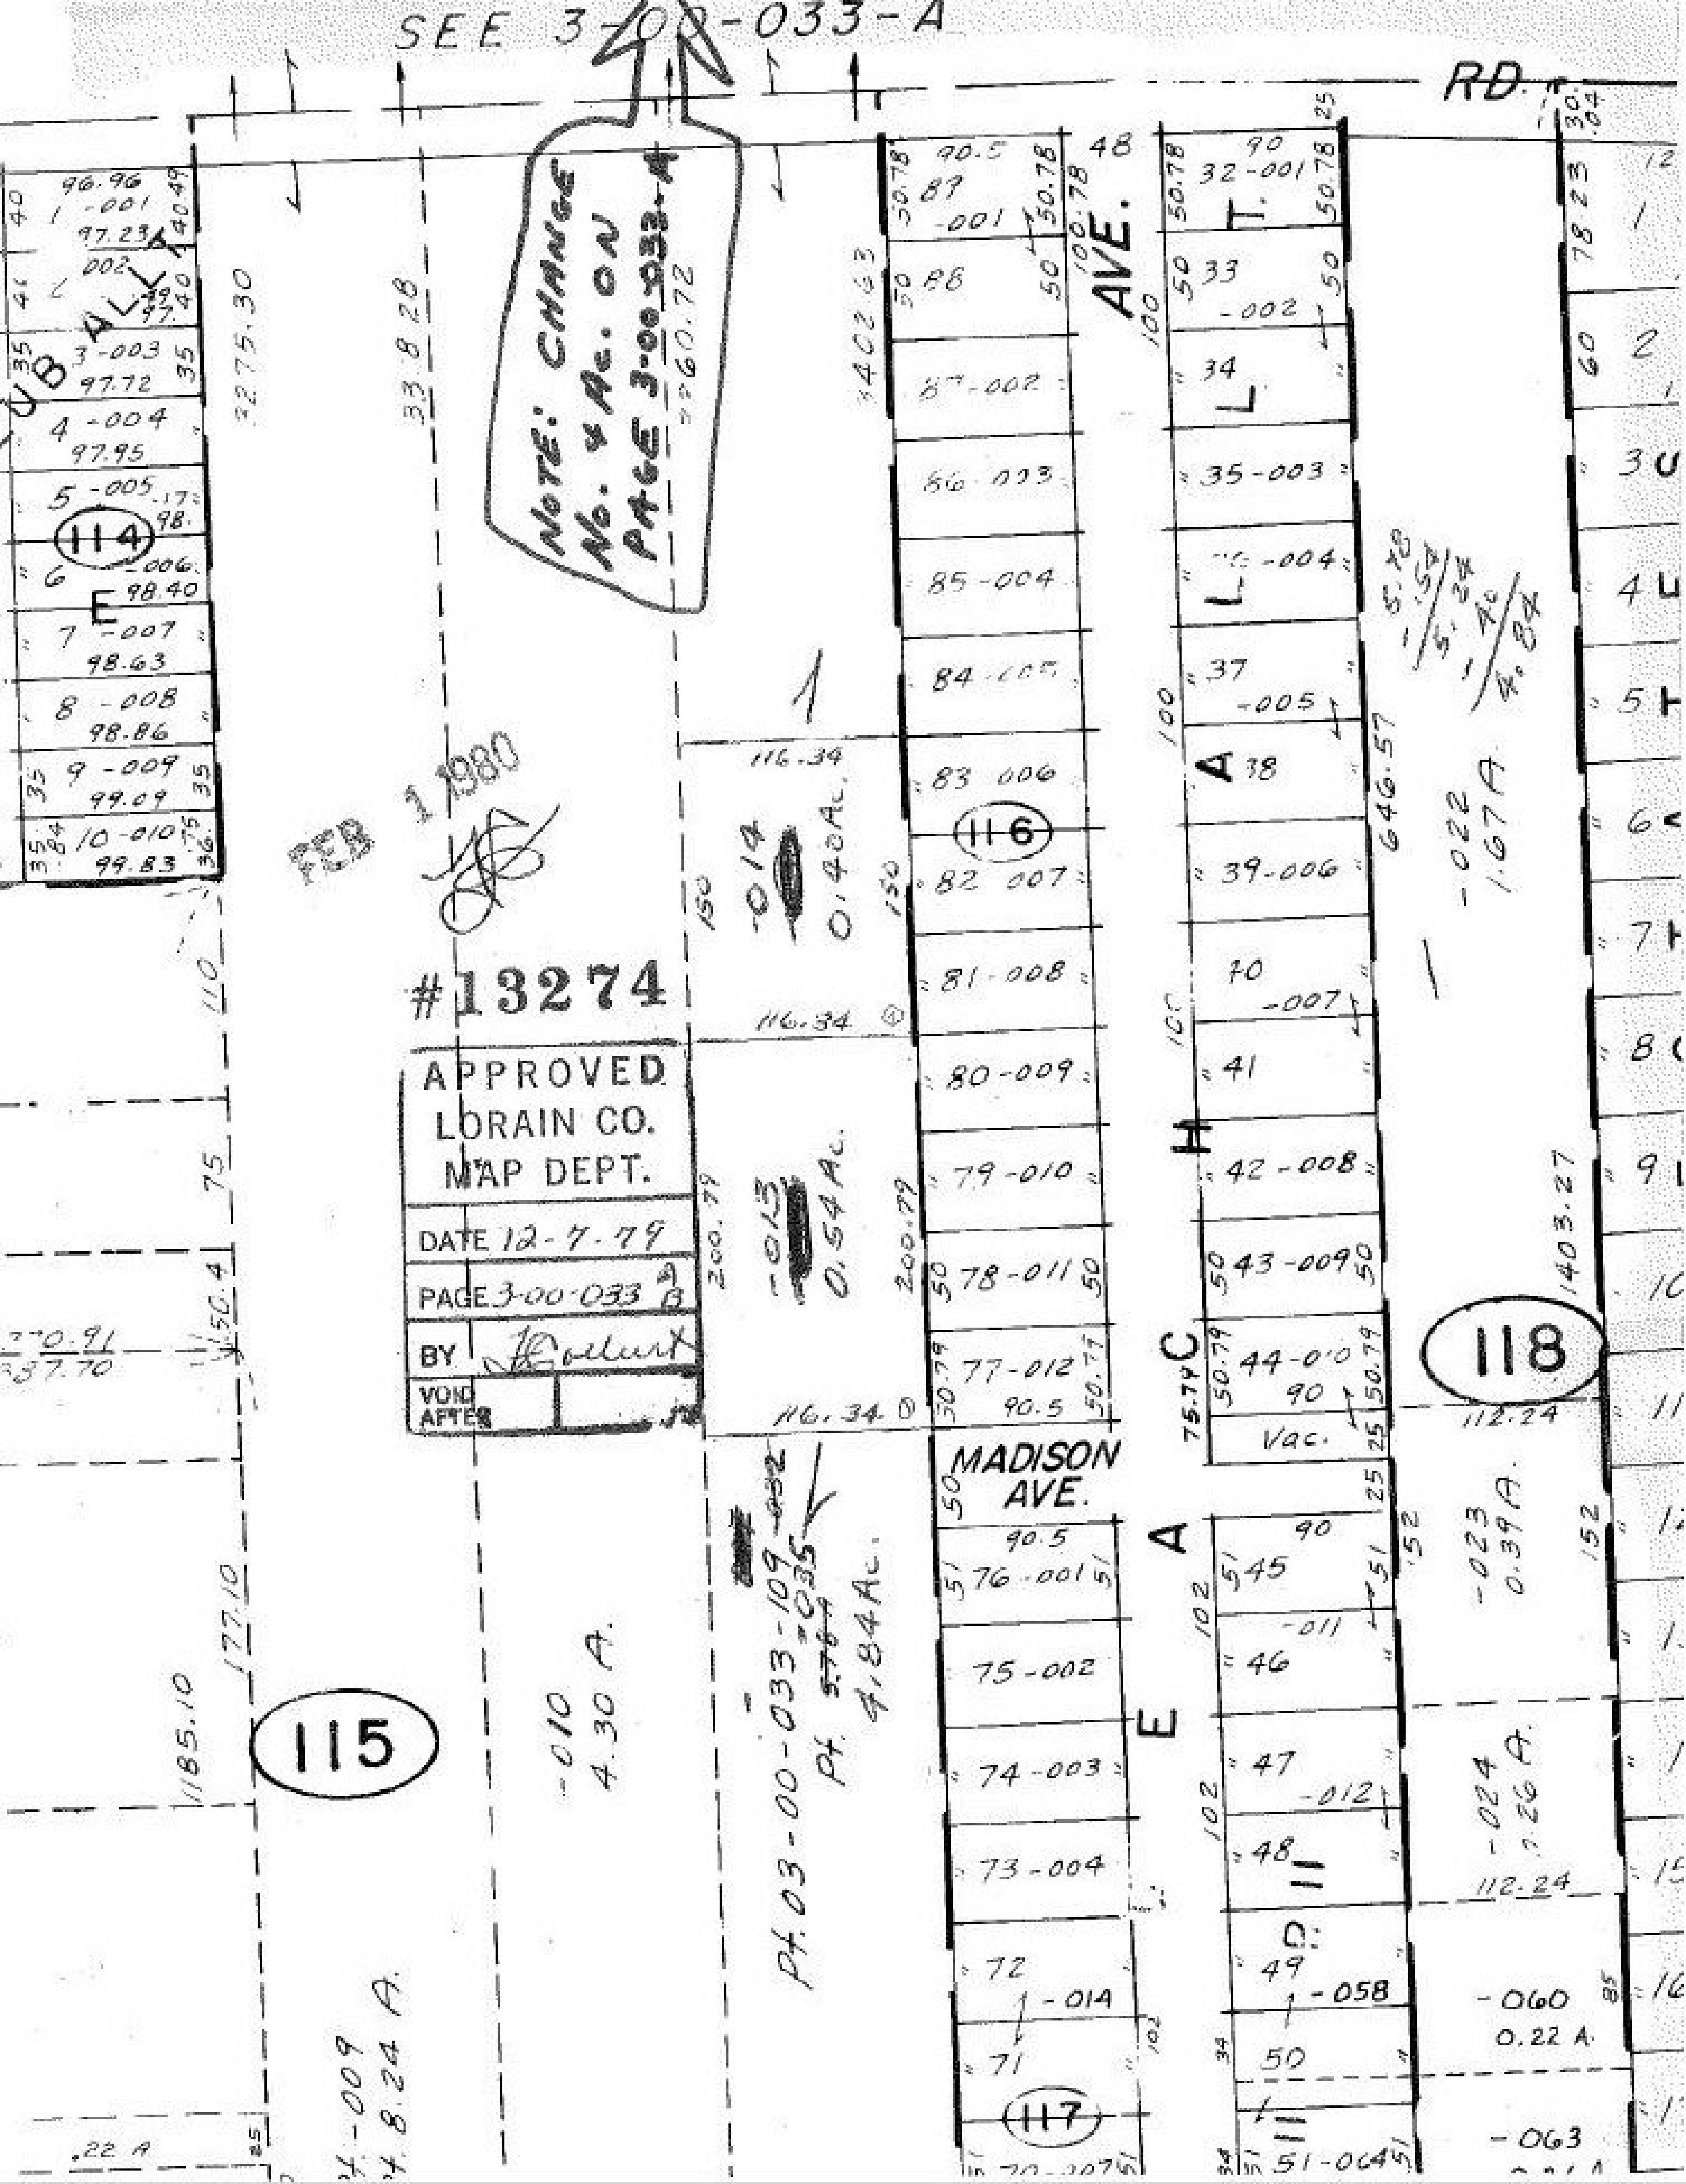
SEE 3-00-033-A
RD.
NOTE: CHANGE No. & Ac. ON PAGE 3-00-033-A
AVE.
MADISON AVE.
SUBALLEY
CHALLEEAEST
114
115
116
117
118
FEB 1 1980
#13274
APPROVED
LORAIN CO.
MAP DEPT.
DATE 12-7-79
PAGE 3-00-033 A B
BY
VOID AFTER
-014 0.40 Ac.
-013 0.54 Ac.
-010 4.30 A.
-009 8.24 A.
Pt. 03-00-033-109
Pt. 4.84 Ac.
-022 1.67 A.
-023 0.39 A.
-024 0.26 A.
-058
-060 0.22 A.
-063
1403.27
646.57
Vac.