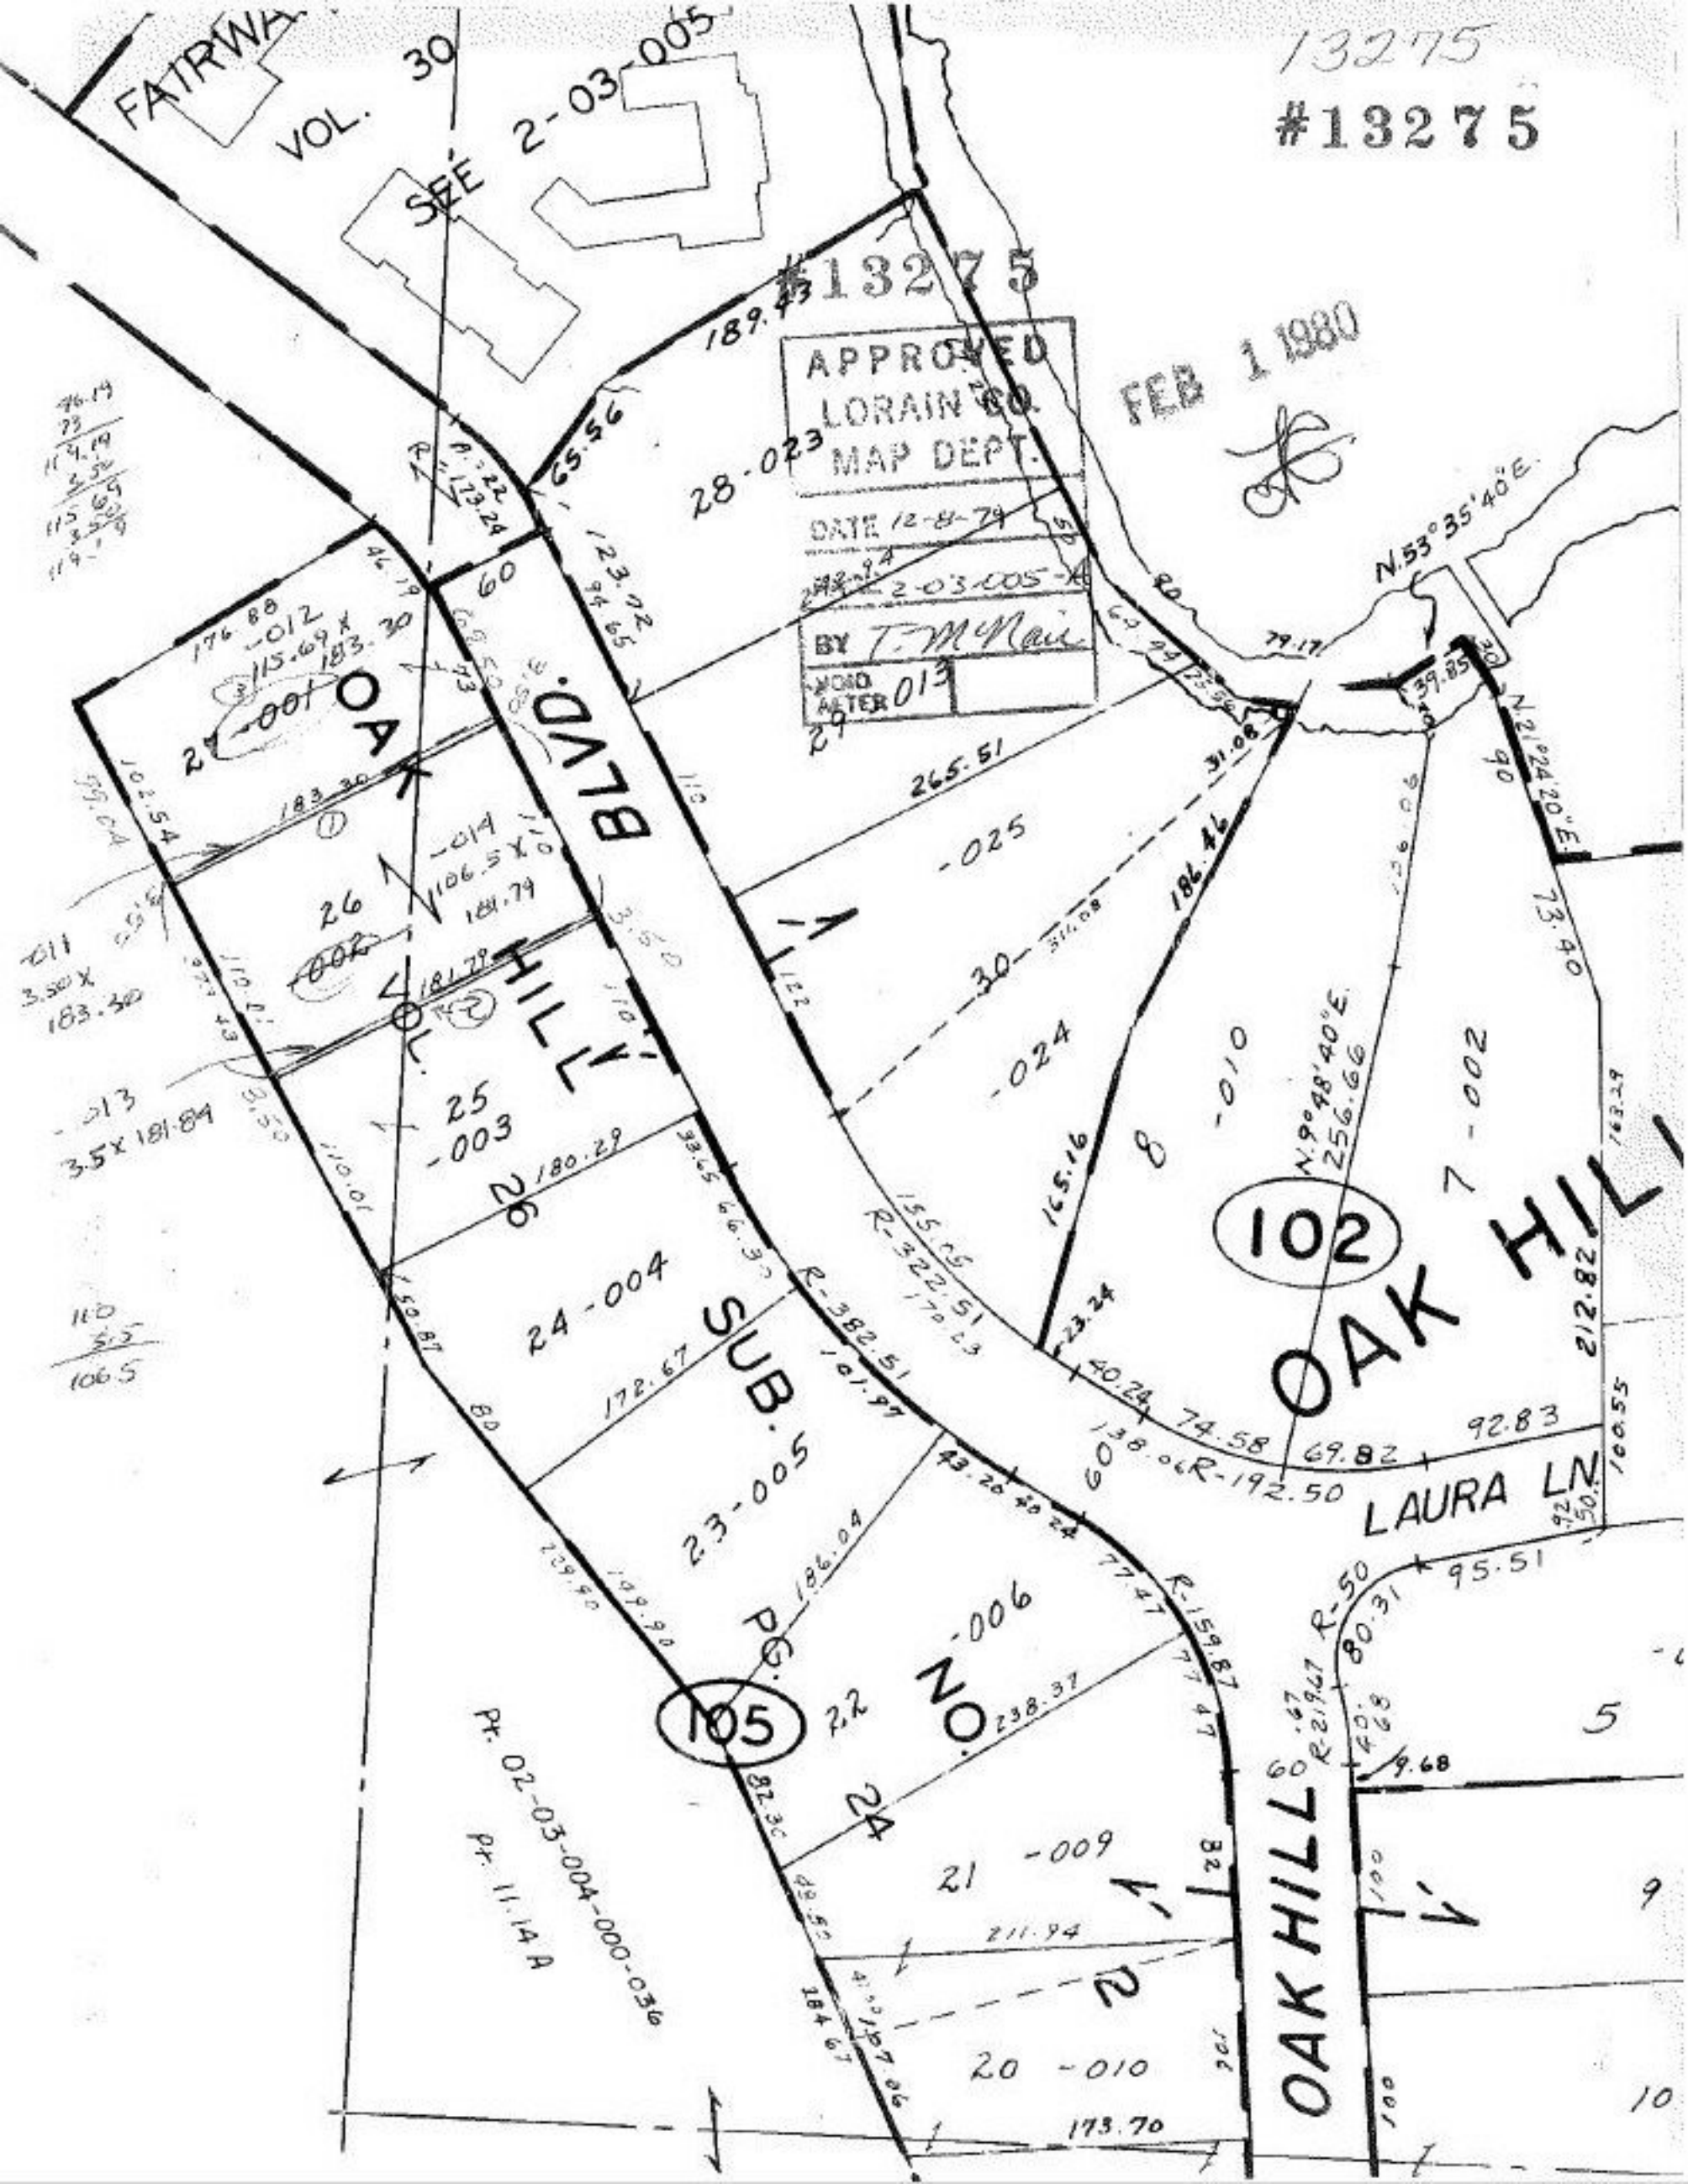

13275
#13275
#13275
APPROVED
LORAIN CO.
MAP DEPT.
DATE 12-8-79
2-03-005-A
BY T. McNair
VOID AFTER 013
FEB 1 1980
FAIRWA
VOL. 30
SEE 2-03-005
OAK HILL BLVD.
VOL. 26
SUB. NO. 24
PG. 22
OAK HILL
LAURA LN.
102
105
28-023
27-001
26-002
25-003
24-004
23-005
21-009
20-010
-025
-024
-010
-006
N.53°35'40"E.
N.21°24'20"E.
N.90°48'40"E.
Pt. 02-03-004-000-036
Pt. 11.14 A