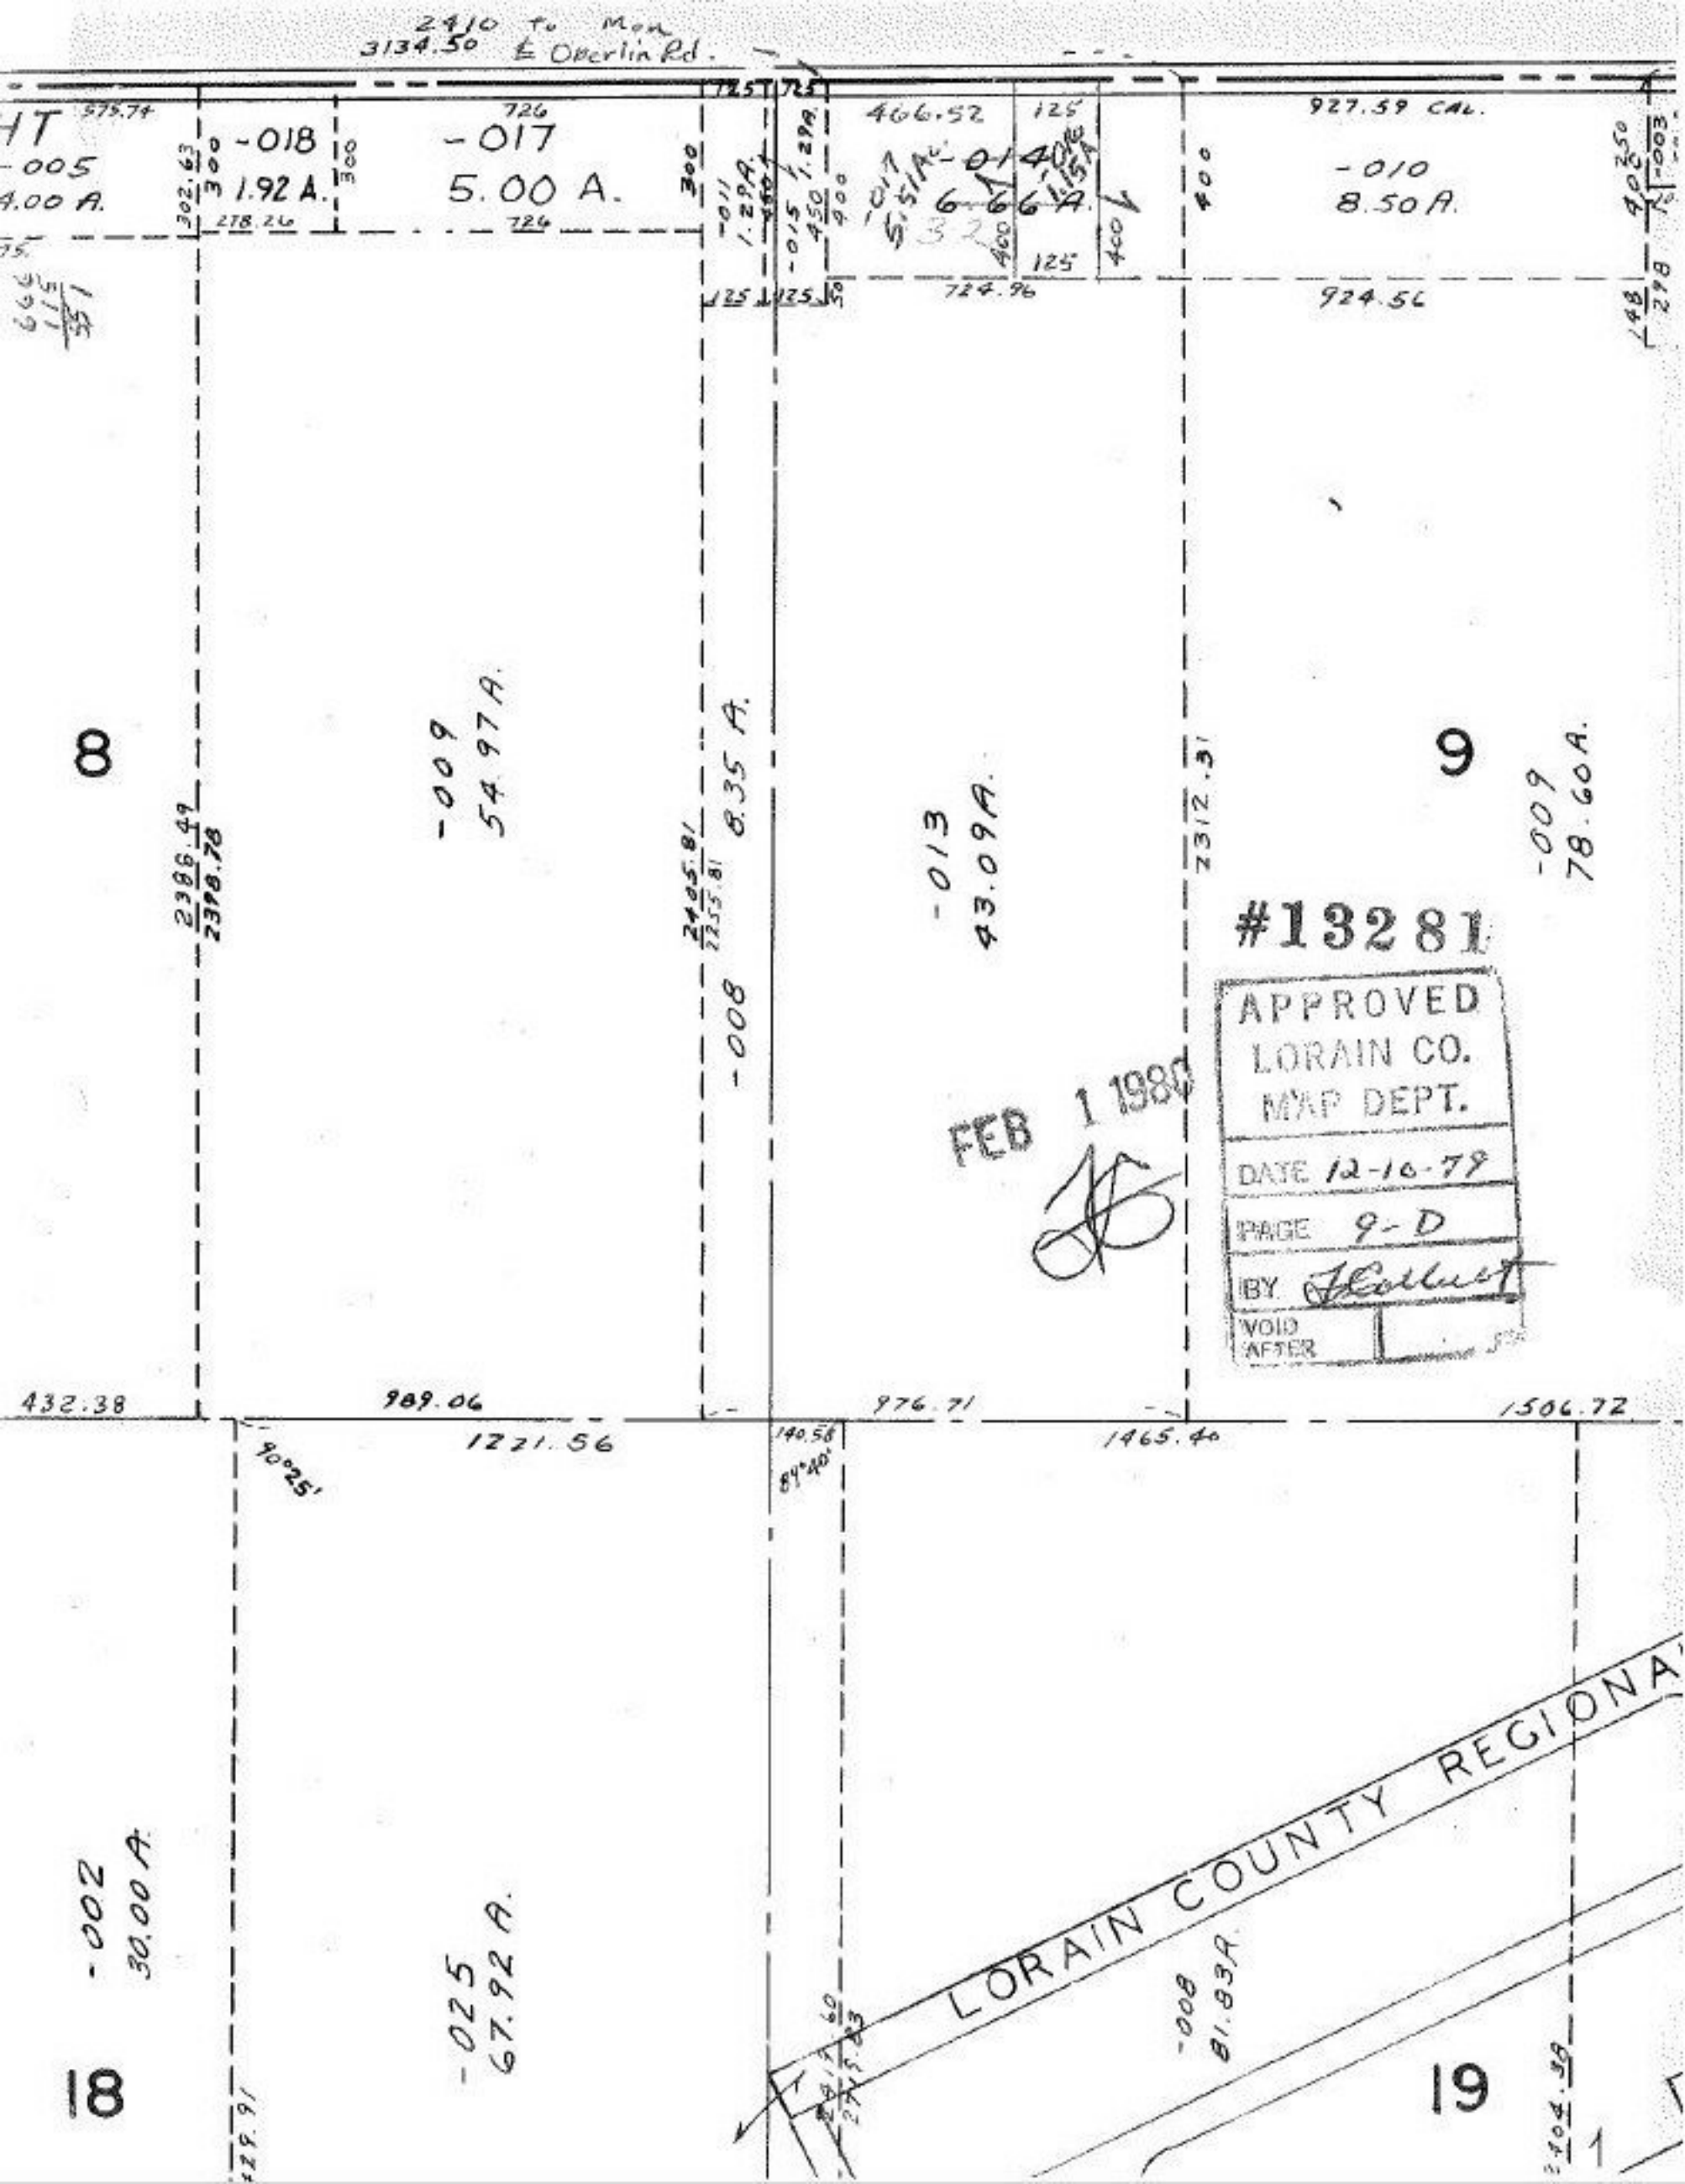
2410 to Mon
3134.50 ℄ Oberlin Rd.
-005
4.00 A.
-018
1.92 A.
-017
5.00 A.
-014
6.66 A.
-010
8.50 A.
927.59 CAL.
924.56
724.96
8
9
-009
54.97 A.
-008
8.35 A.
-013
43.09 A.
-009
78.60 A.
2386.49
2398.78
2405.81
2255.81
2312.31
432.38
989.06
976.71
1506.72
1221.56
1465.40
90°25'
140.58
84°40'
LORAIN COUNTY REGIONA
-002
30.00 A.
-025
67.92 A.
-008
81.83 A.
18
19
#13281
APPROVED
LORAIN CO.
MAP DEPT.
DATE 12-10-79
PAGE 9-D
BY
VOID AFTER
FEB 1 1980