


HOMewood

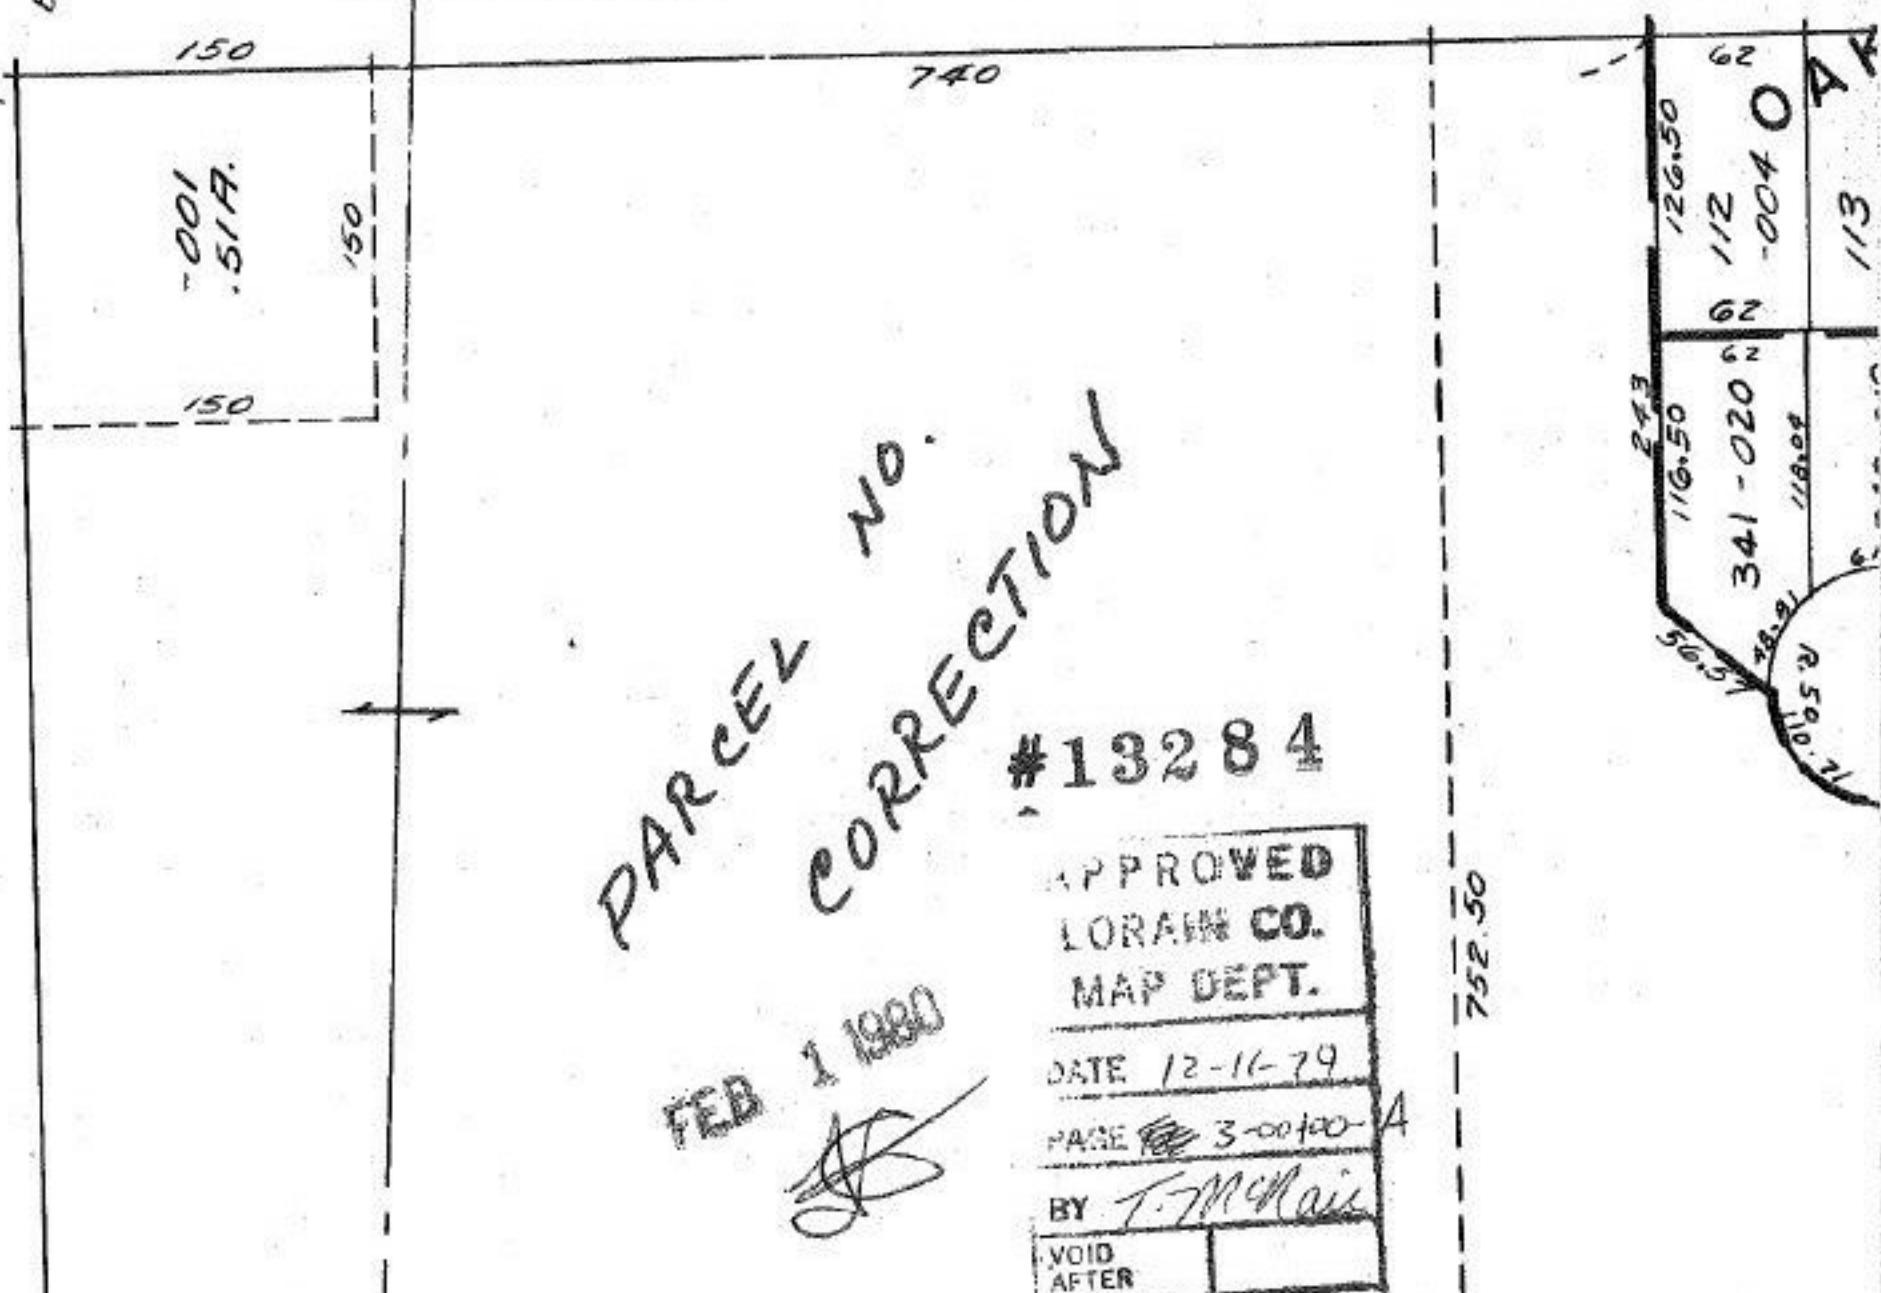

-033
16.12 A

351.70