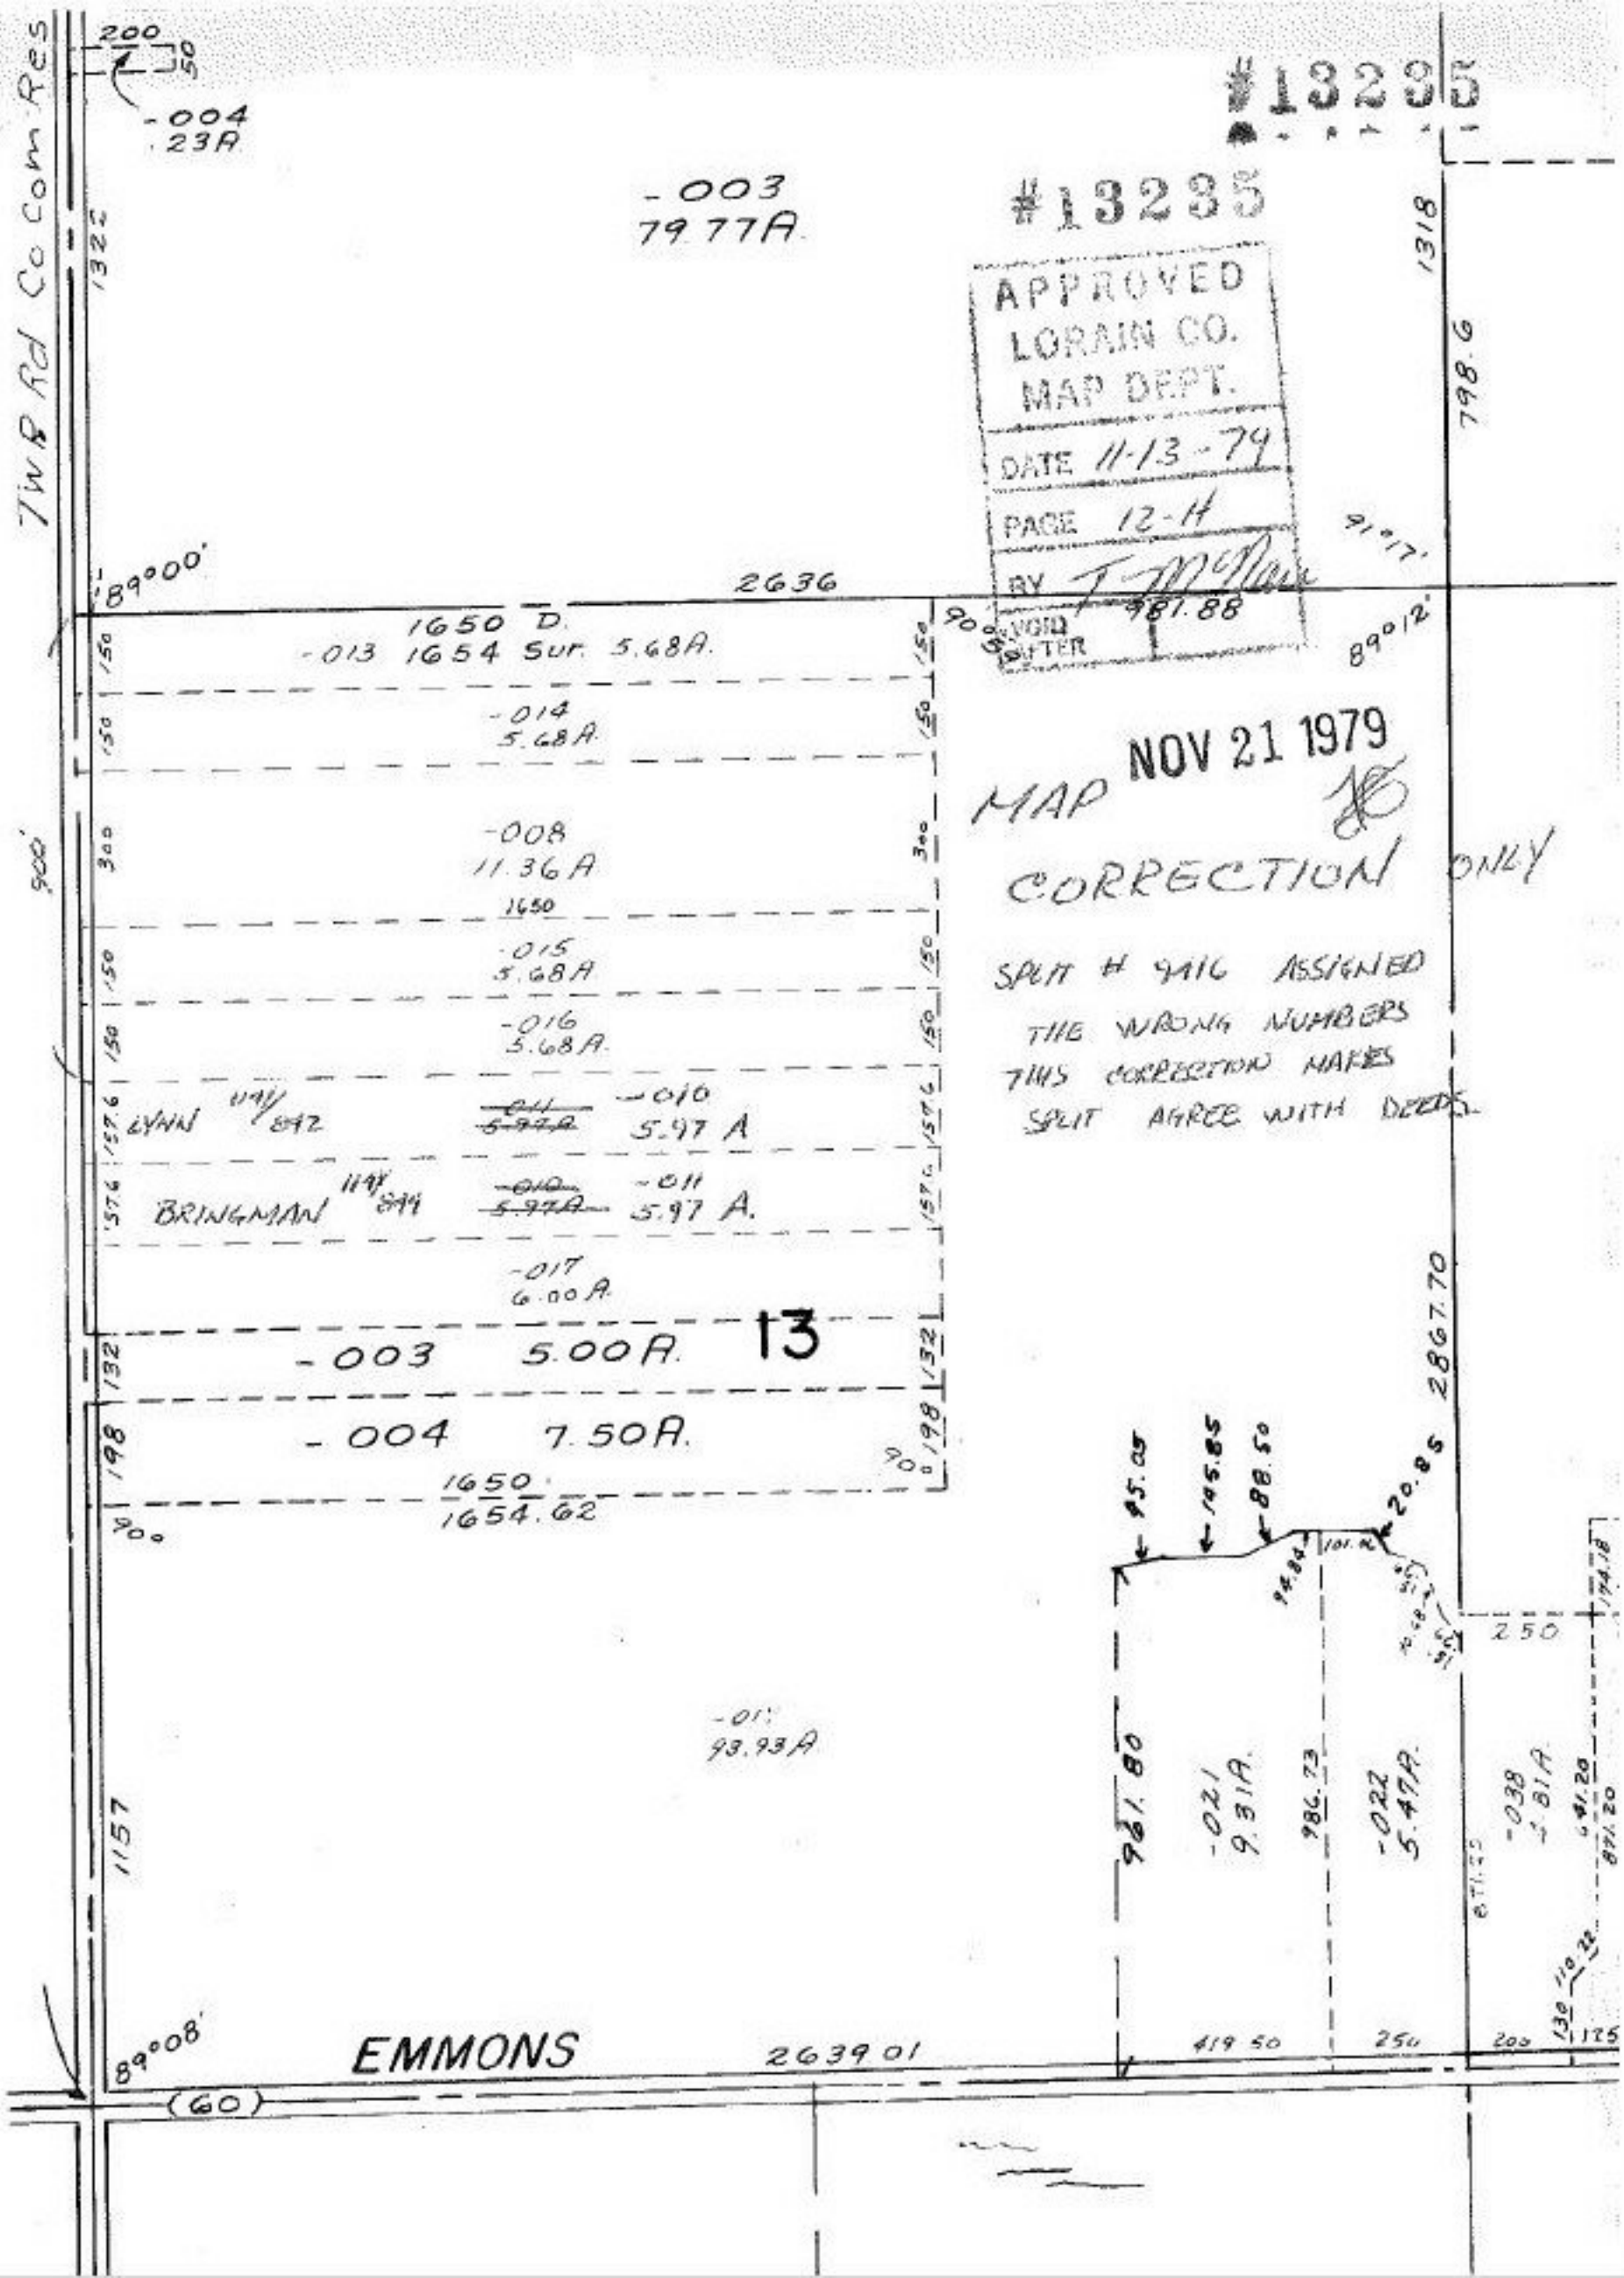

#13235
#13235
APPROVED
LORAIN CO.
MAP DEPT.
DATE 11-13-79
PAGE 12-H
BY
VOID AFTER
NOV 21 1979
MAP CORRECTION ONLY
SPLIT # 9416 ASSIGNED THE WRONG NUMBERS THIS CORRECTION MAKES SPLIT AGREE WITH DEEDS.
TWP Rd Co Com Res
-004 .23A
-003 79.77A
1322
1318
798.6
89°00'
2636
1650 D.
-013 1654 Sur. 5.68A.
-014 5.68A
-008 11.36A
1650
-015 5.68A
-016 5.68A
LYNN 1141/842
-010 5.97 A
BRINGMAN 1141/844
-011 5.97 A.
-017 6.00A
-003 5.00A.
13
-004 7.50A.
1650
1654.62
-011 93.93A
1157
2867.70
95.05
145.85
88.50
20.85
961.80
-021 9.31A.
986.73
-022 5.47A.
-038 1.81A
250
89°08'
EMMONS
2639.01
419.50
250
200
(60)