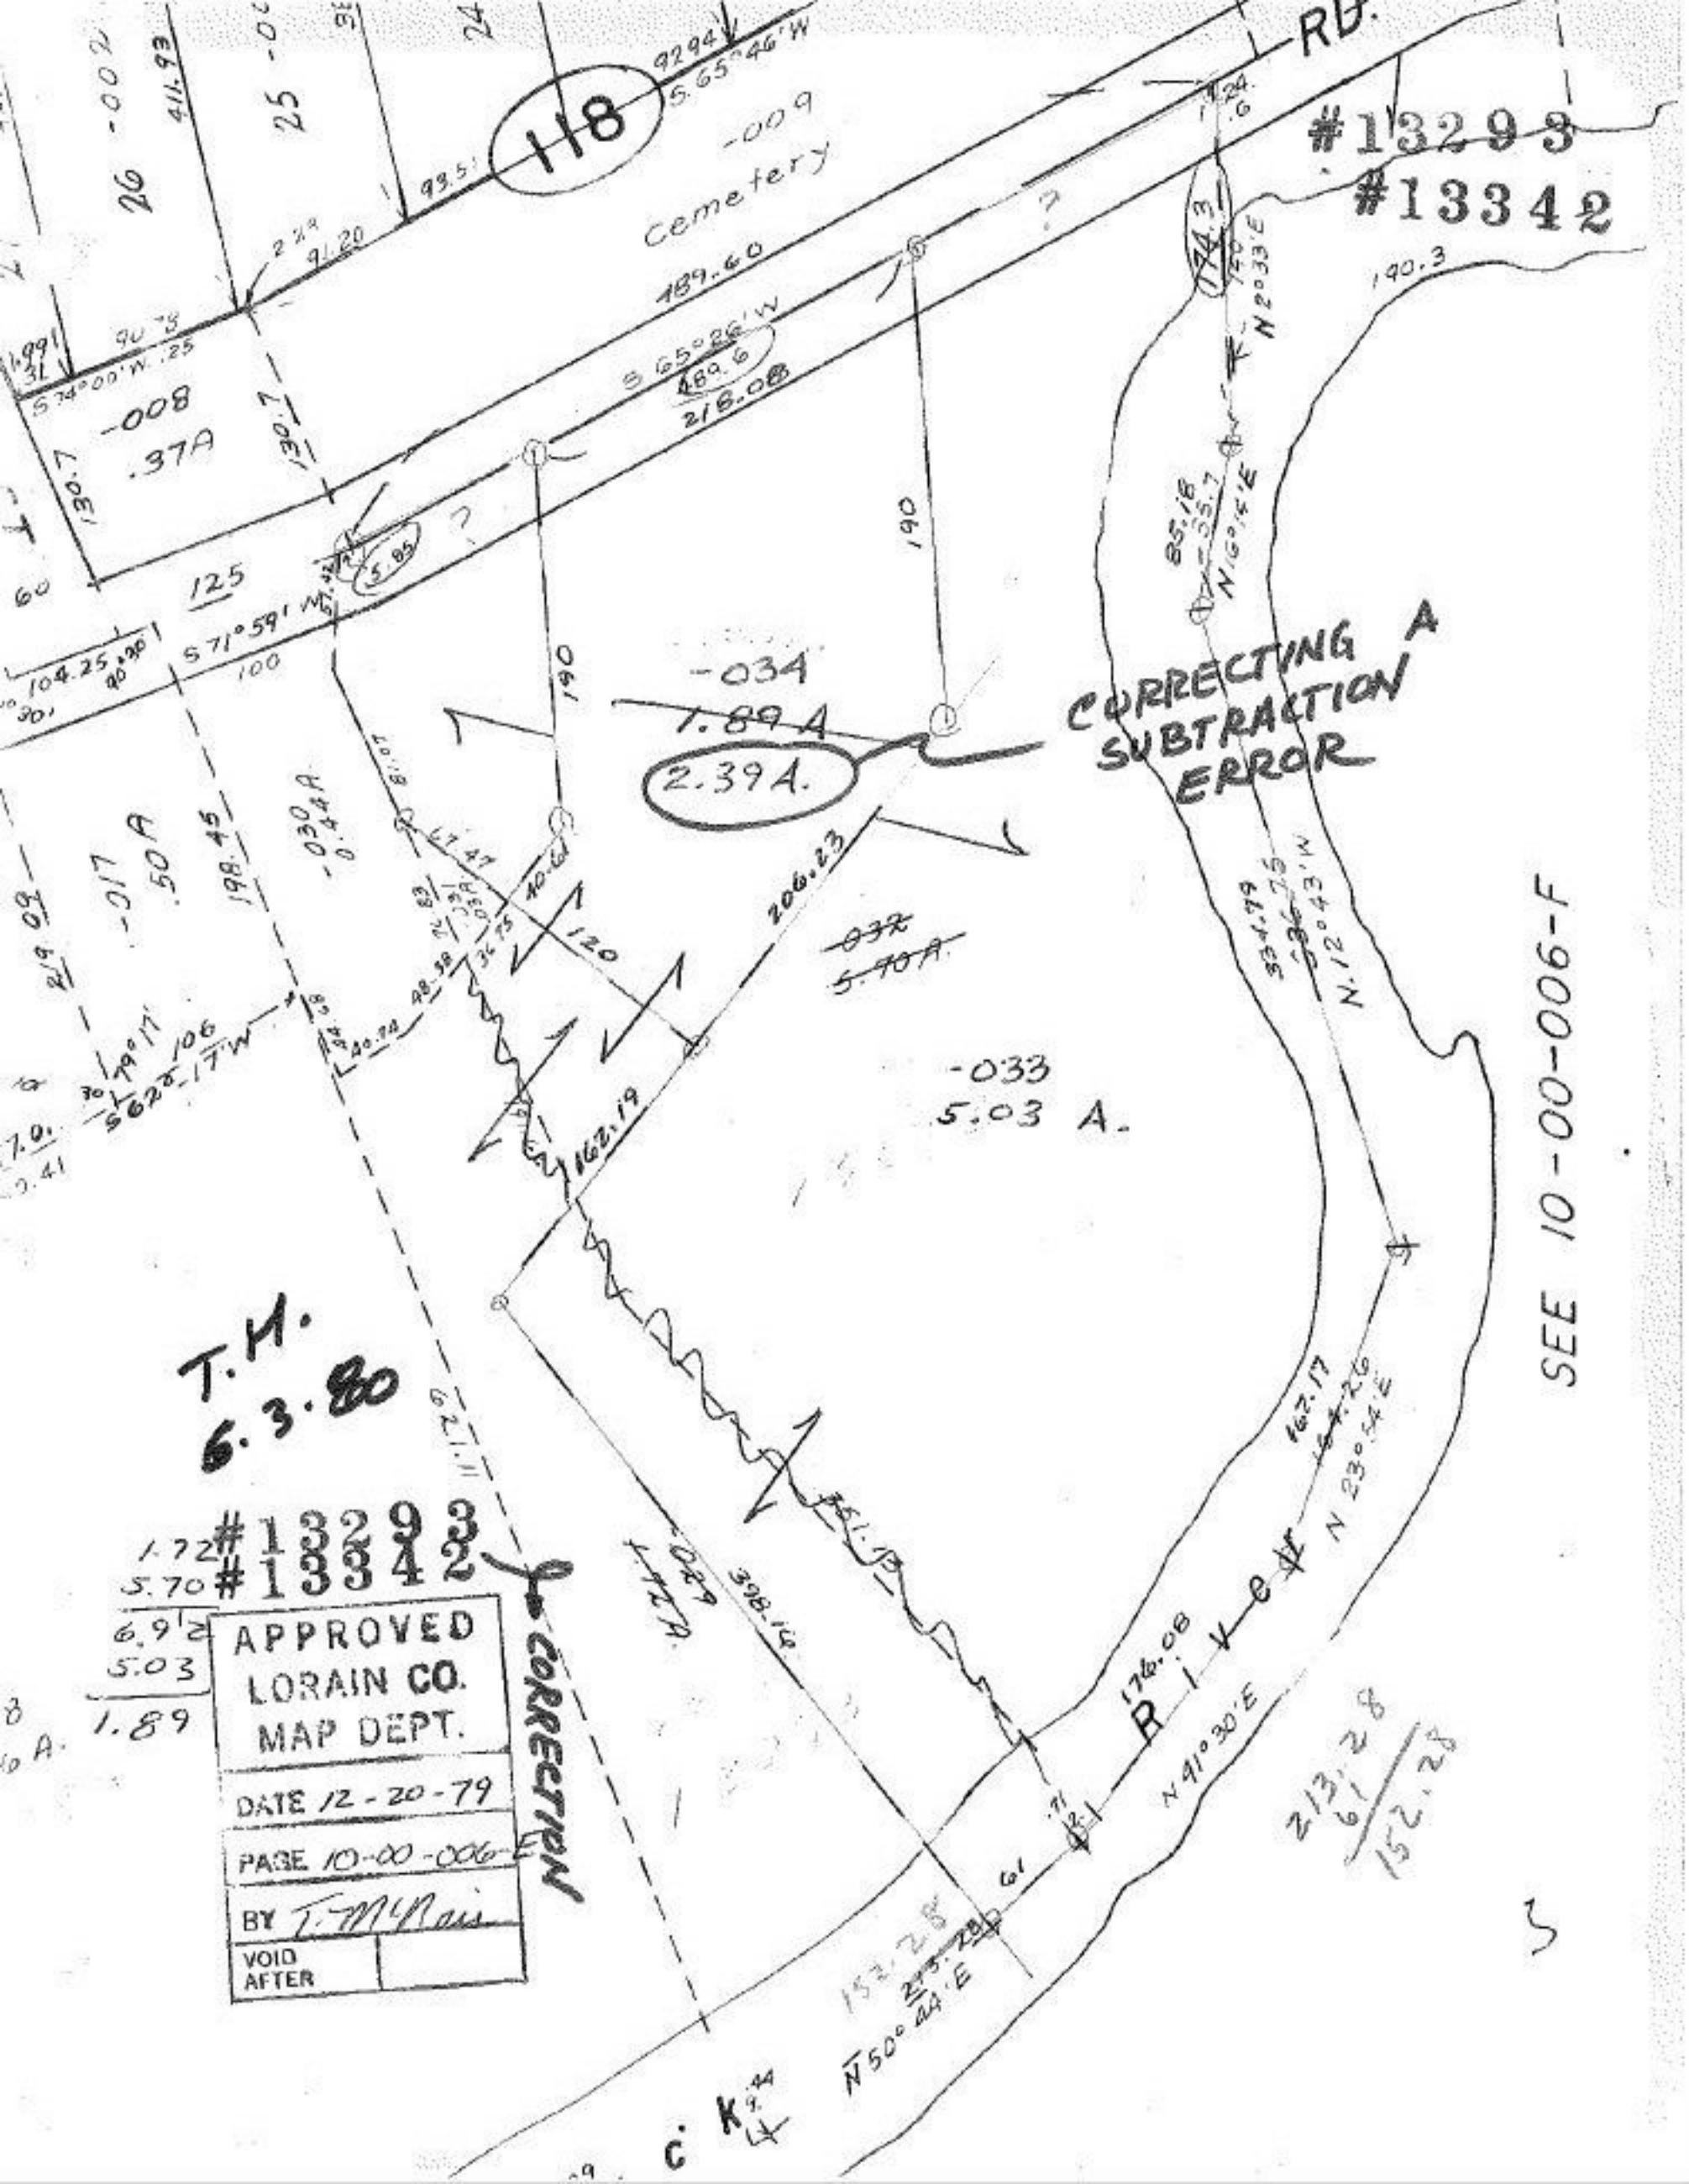

118
RD.
#13293
#13342
Cemetery
-009
489.60
S 65°26'W
489.6
218.08
-008
.37A
125
S 71°59'W
-034
1.89 A
2.39 A.
CORRECTING A SUBTRACTION ERROR
-017
.50 A
198.45
-030
0.44 A
206.23
-032
5.70 A
-033
5.03 A.
162.19
SEE 10-00-006-F
T.H.
6.3.80
#13293
#13342
1.72
5.70
6.92
5.03
1.89
APPROVED
LORAIN CO.
MAP DEPT.
DATE 12-20-79
PAGE 10-00-006-E
BY T. McNair
VOID AFTER
CORRECTION
RIVER
N 41°30'E
N 50°44'E
N 23°54'E
N 12°43'W
N 16°14'E
N 2°33'E
213.28
61
152.28