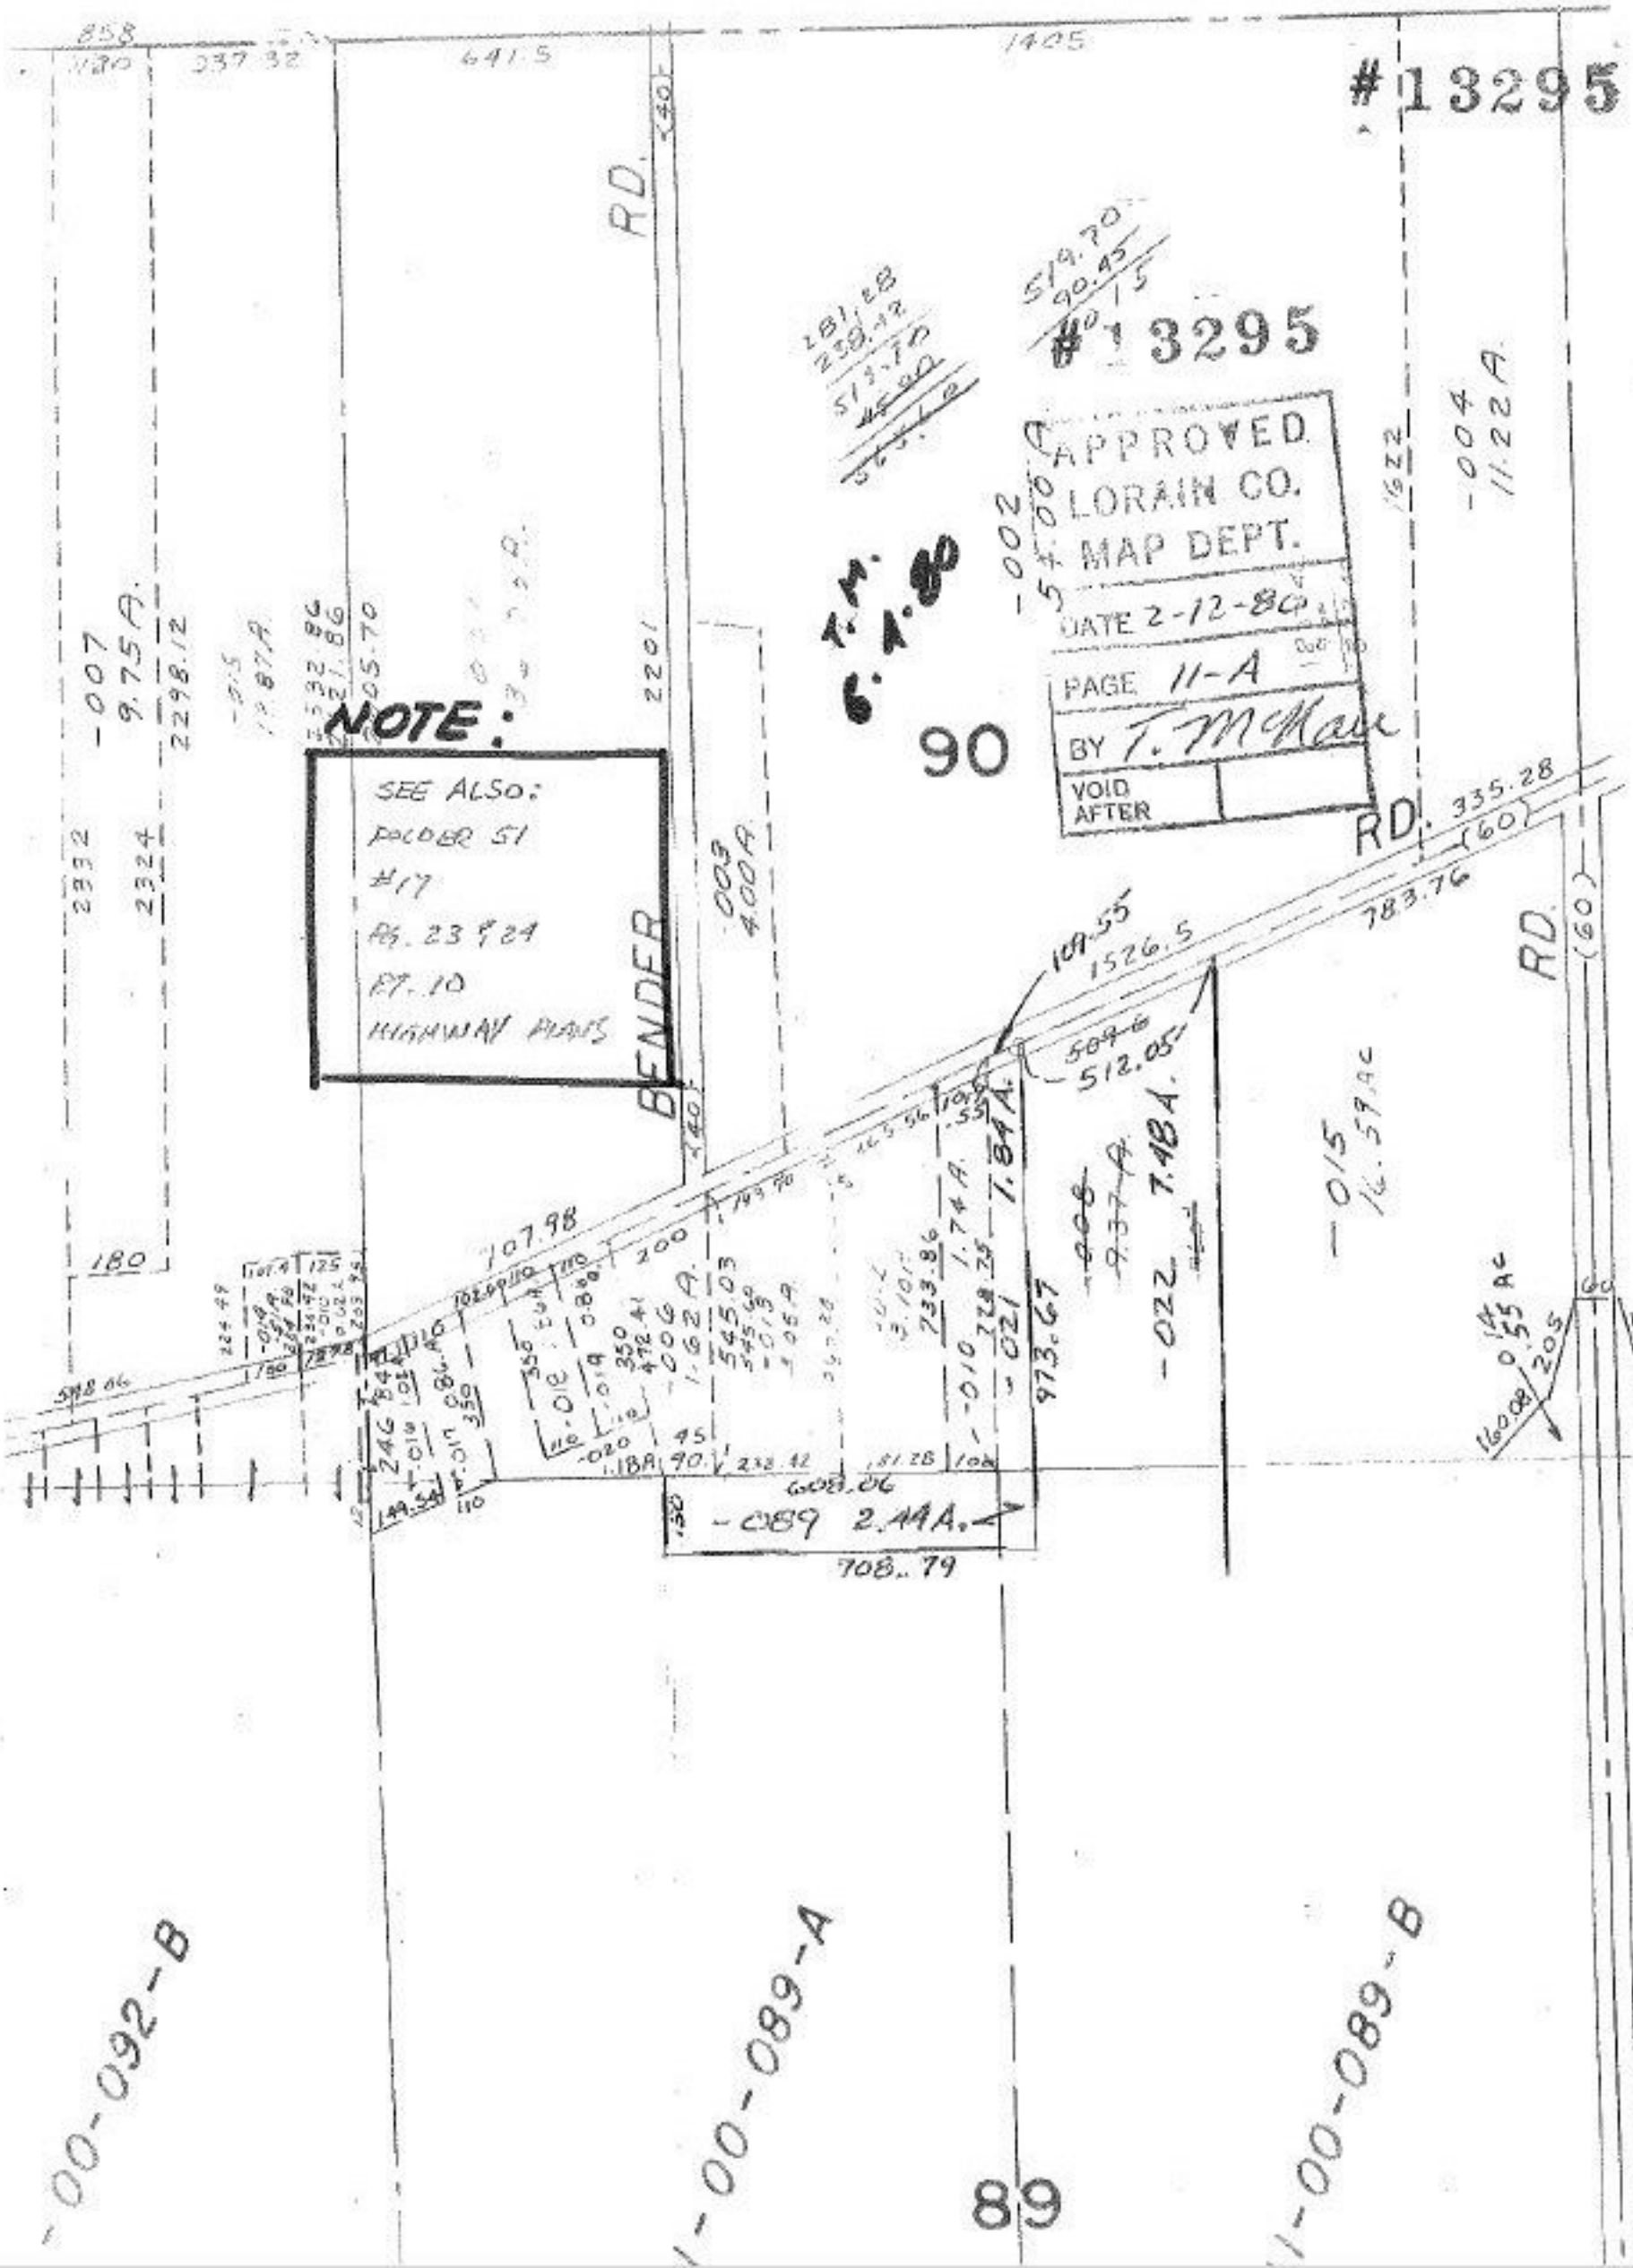

#13295
#13295
APPROVED
LORAIN CO.
MAP DEPT.
DATE 2-12-80
PAGE 11-A
BY T. McKaw
VOID AFTER
NOTE:
SEE ALSO:
FOLDER 51
#17
PG. 23 & 24
RT. 10
HIGHWAY PLANS
BENDER RD.
RD.
RD.
90
89
-00-092-B
-00-089-A
-00-089-B