#13296

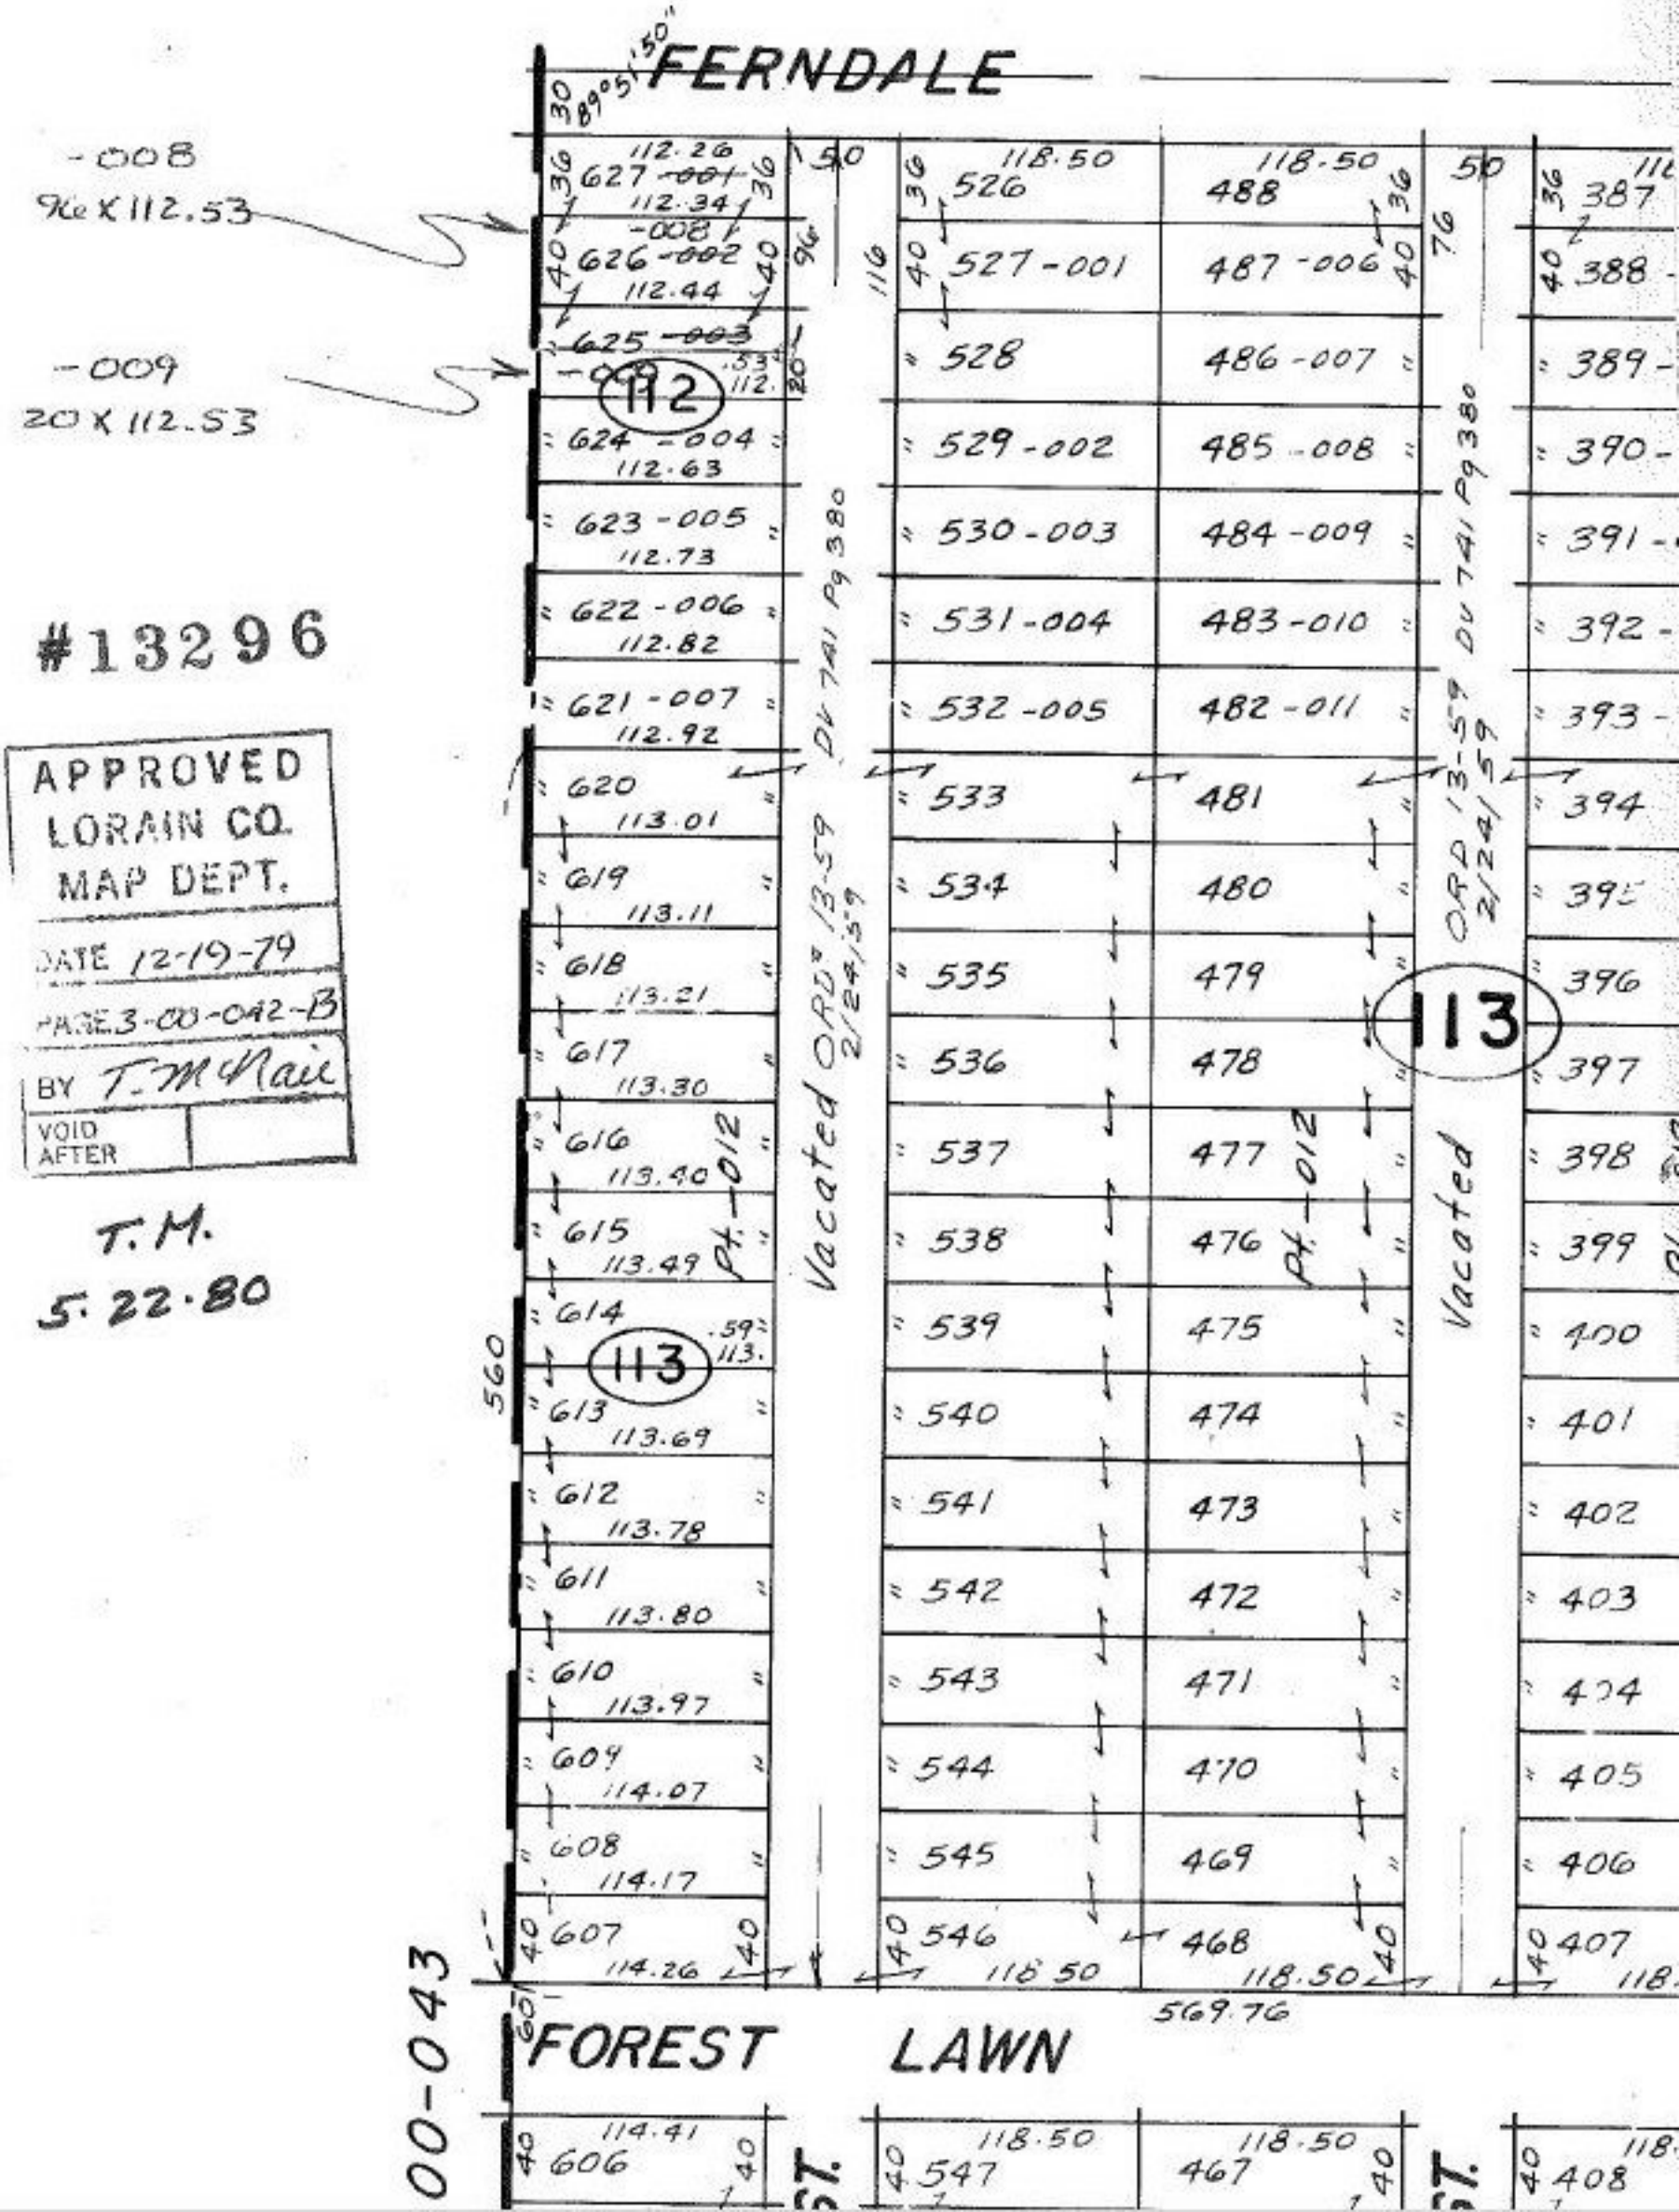

#13296

APPROVED
LORAIN CO.
MAP DEPT.
DATE 12-19-79
PAGE 3-00-042-B
BY T. McNair
VOID AFTER

T.M.
5.22.80