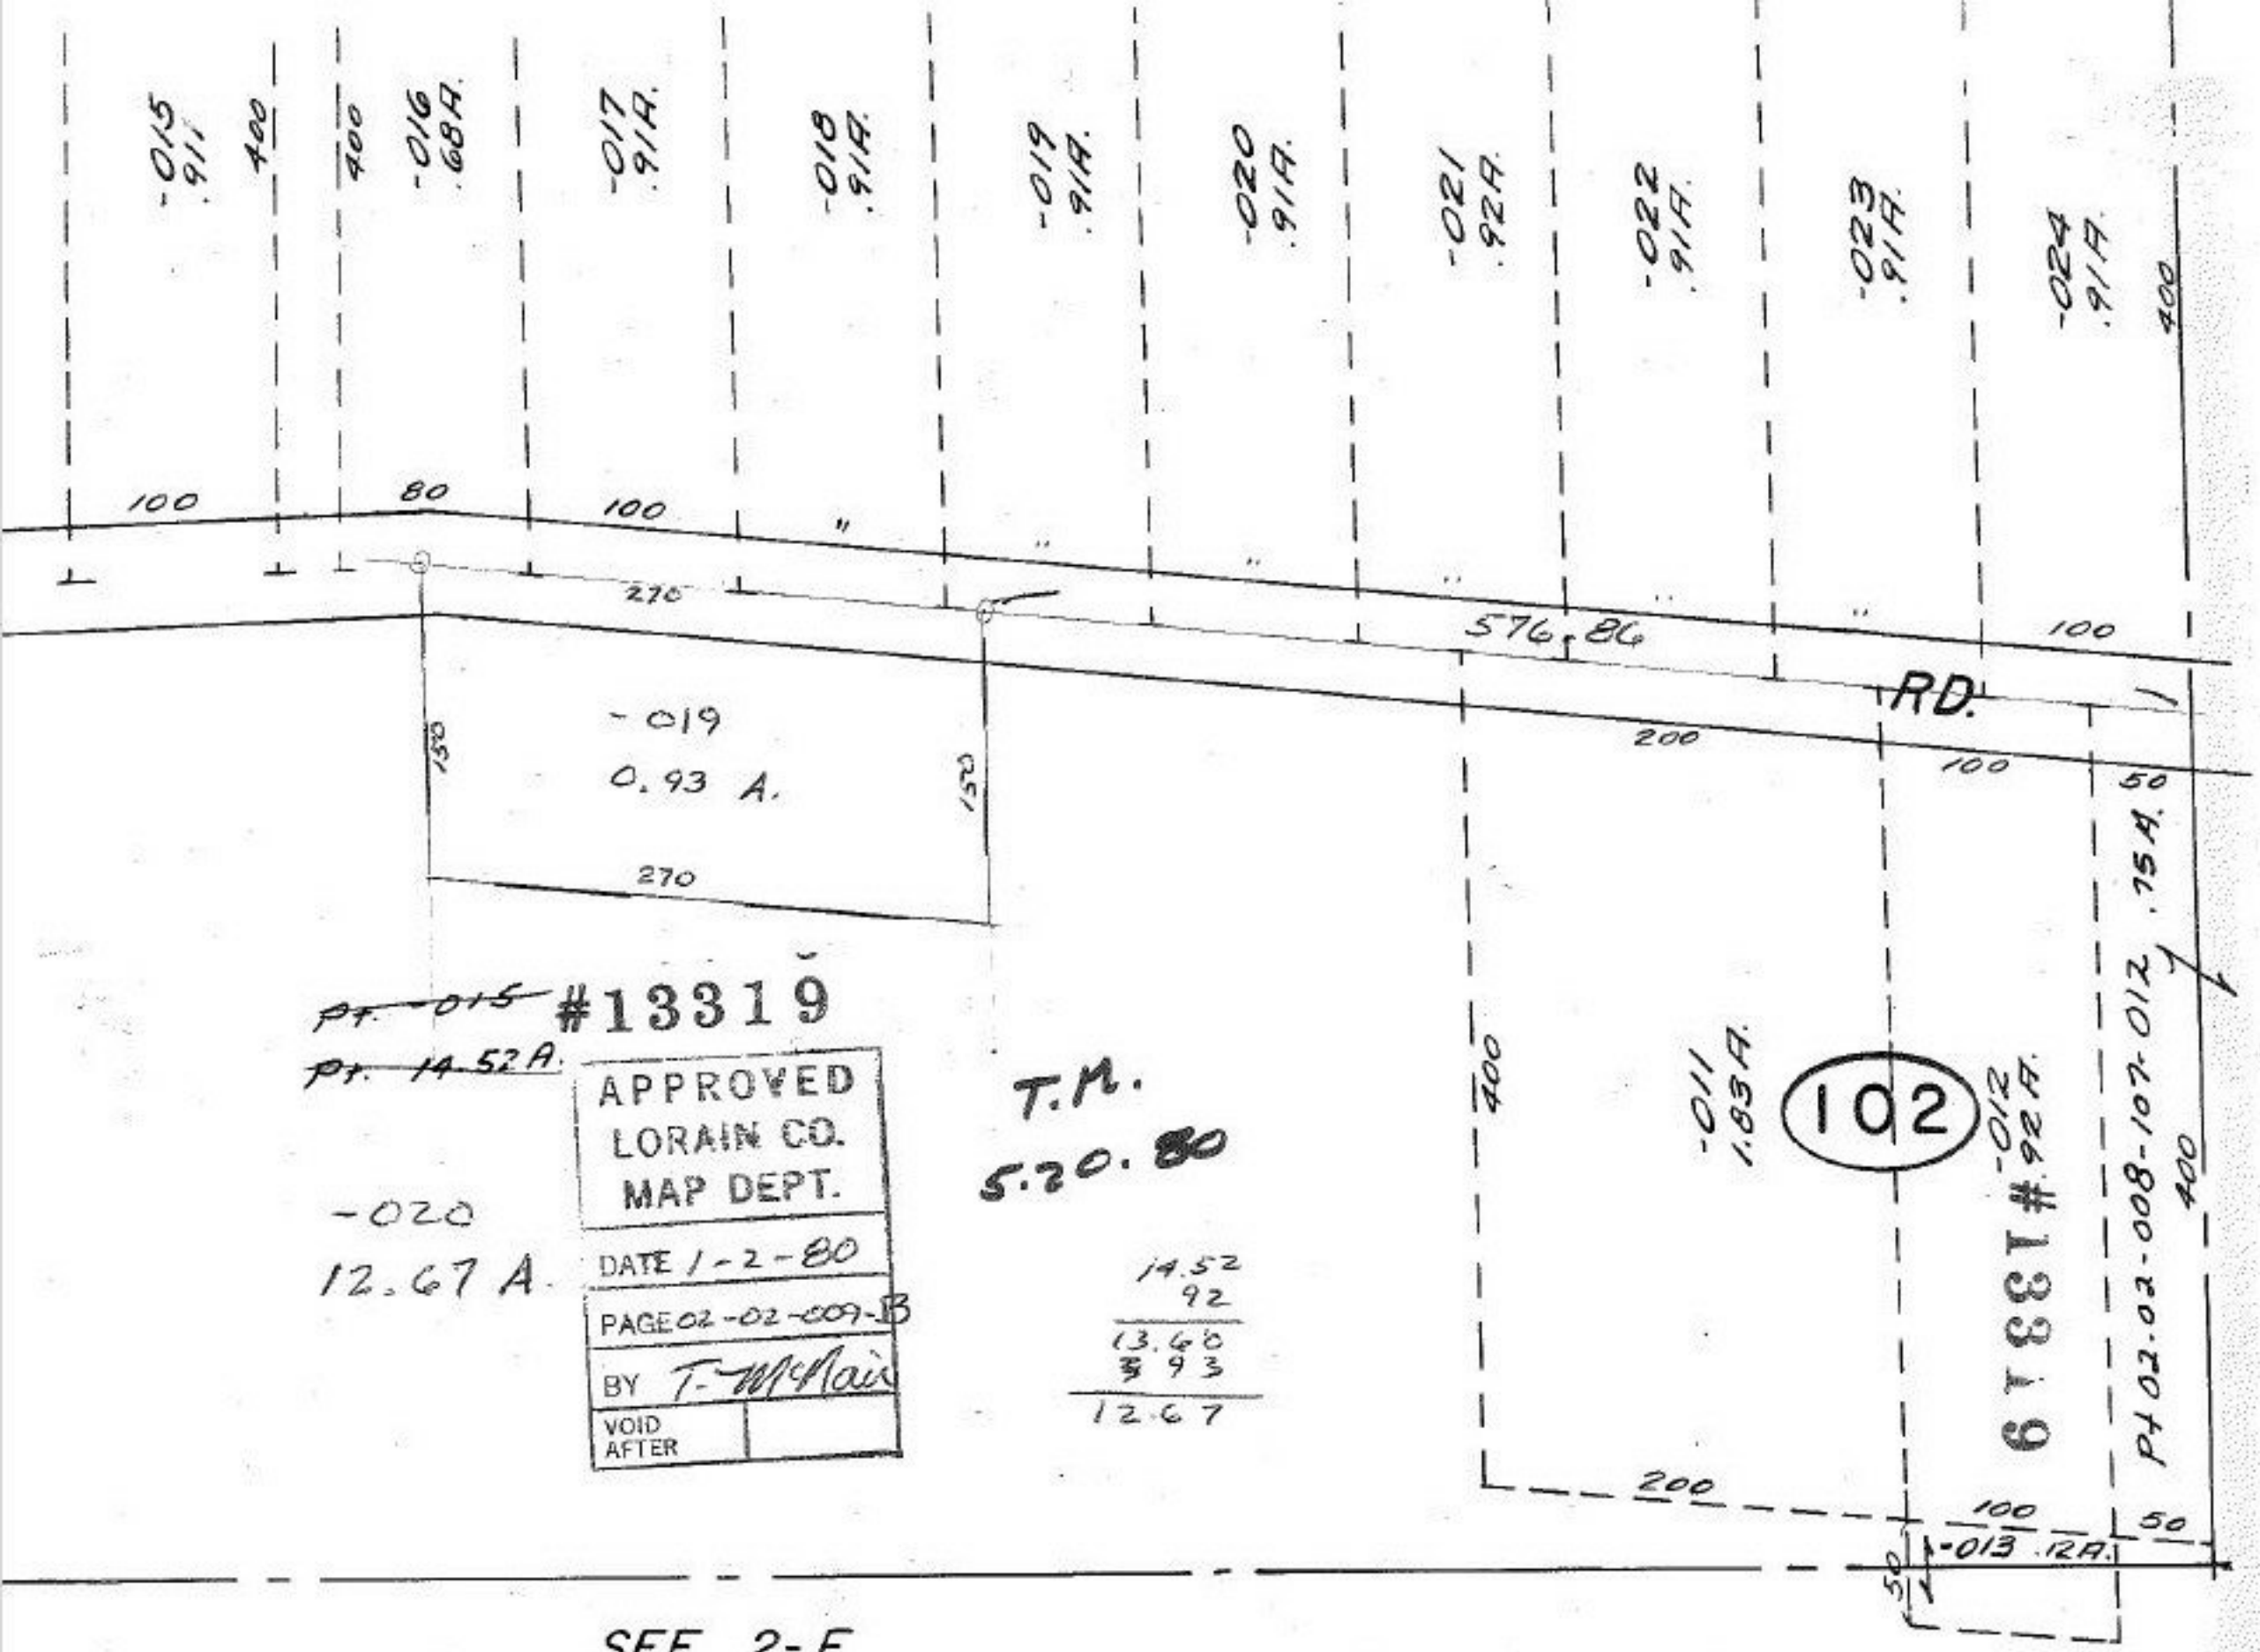
-015 .91
400
400
-016 .68A.
-017 .91A.
-018 .91A.
-019 .91A.
-020 .91A.
-021 .92A.
-022 .91A.
-023 .91A.
-024 .91A.
400
100
80
100
270
576.86
100
RD.
200
100
50
-019
0.93 A.
150
150
270
.75A.
Pt. -015 #13319
Pt. 14.52A.
APPROVED
LORAIN CO.
MAP DEPT.
DATE 1-2-80
PAGE 02-02-009-B
BY T. McNair
VOID AFTER
T.M.
5.20.80
-020
12.67 A.
14.52
92
13.60
3 93
12.67
400
-011
1.83A.
102
-012
.92A.
#13319
Pt 02-02-008-107-012
400
200
100
50
-013 .12A.
50
SEE 2-F