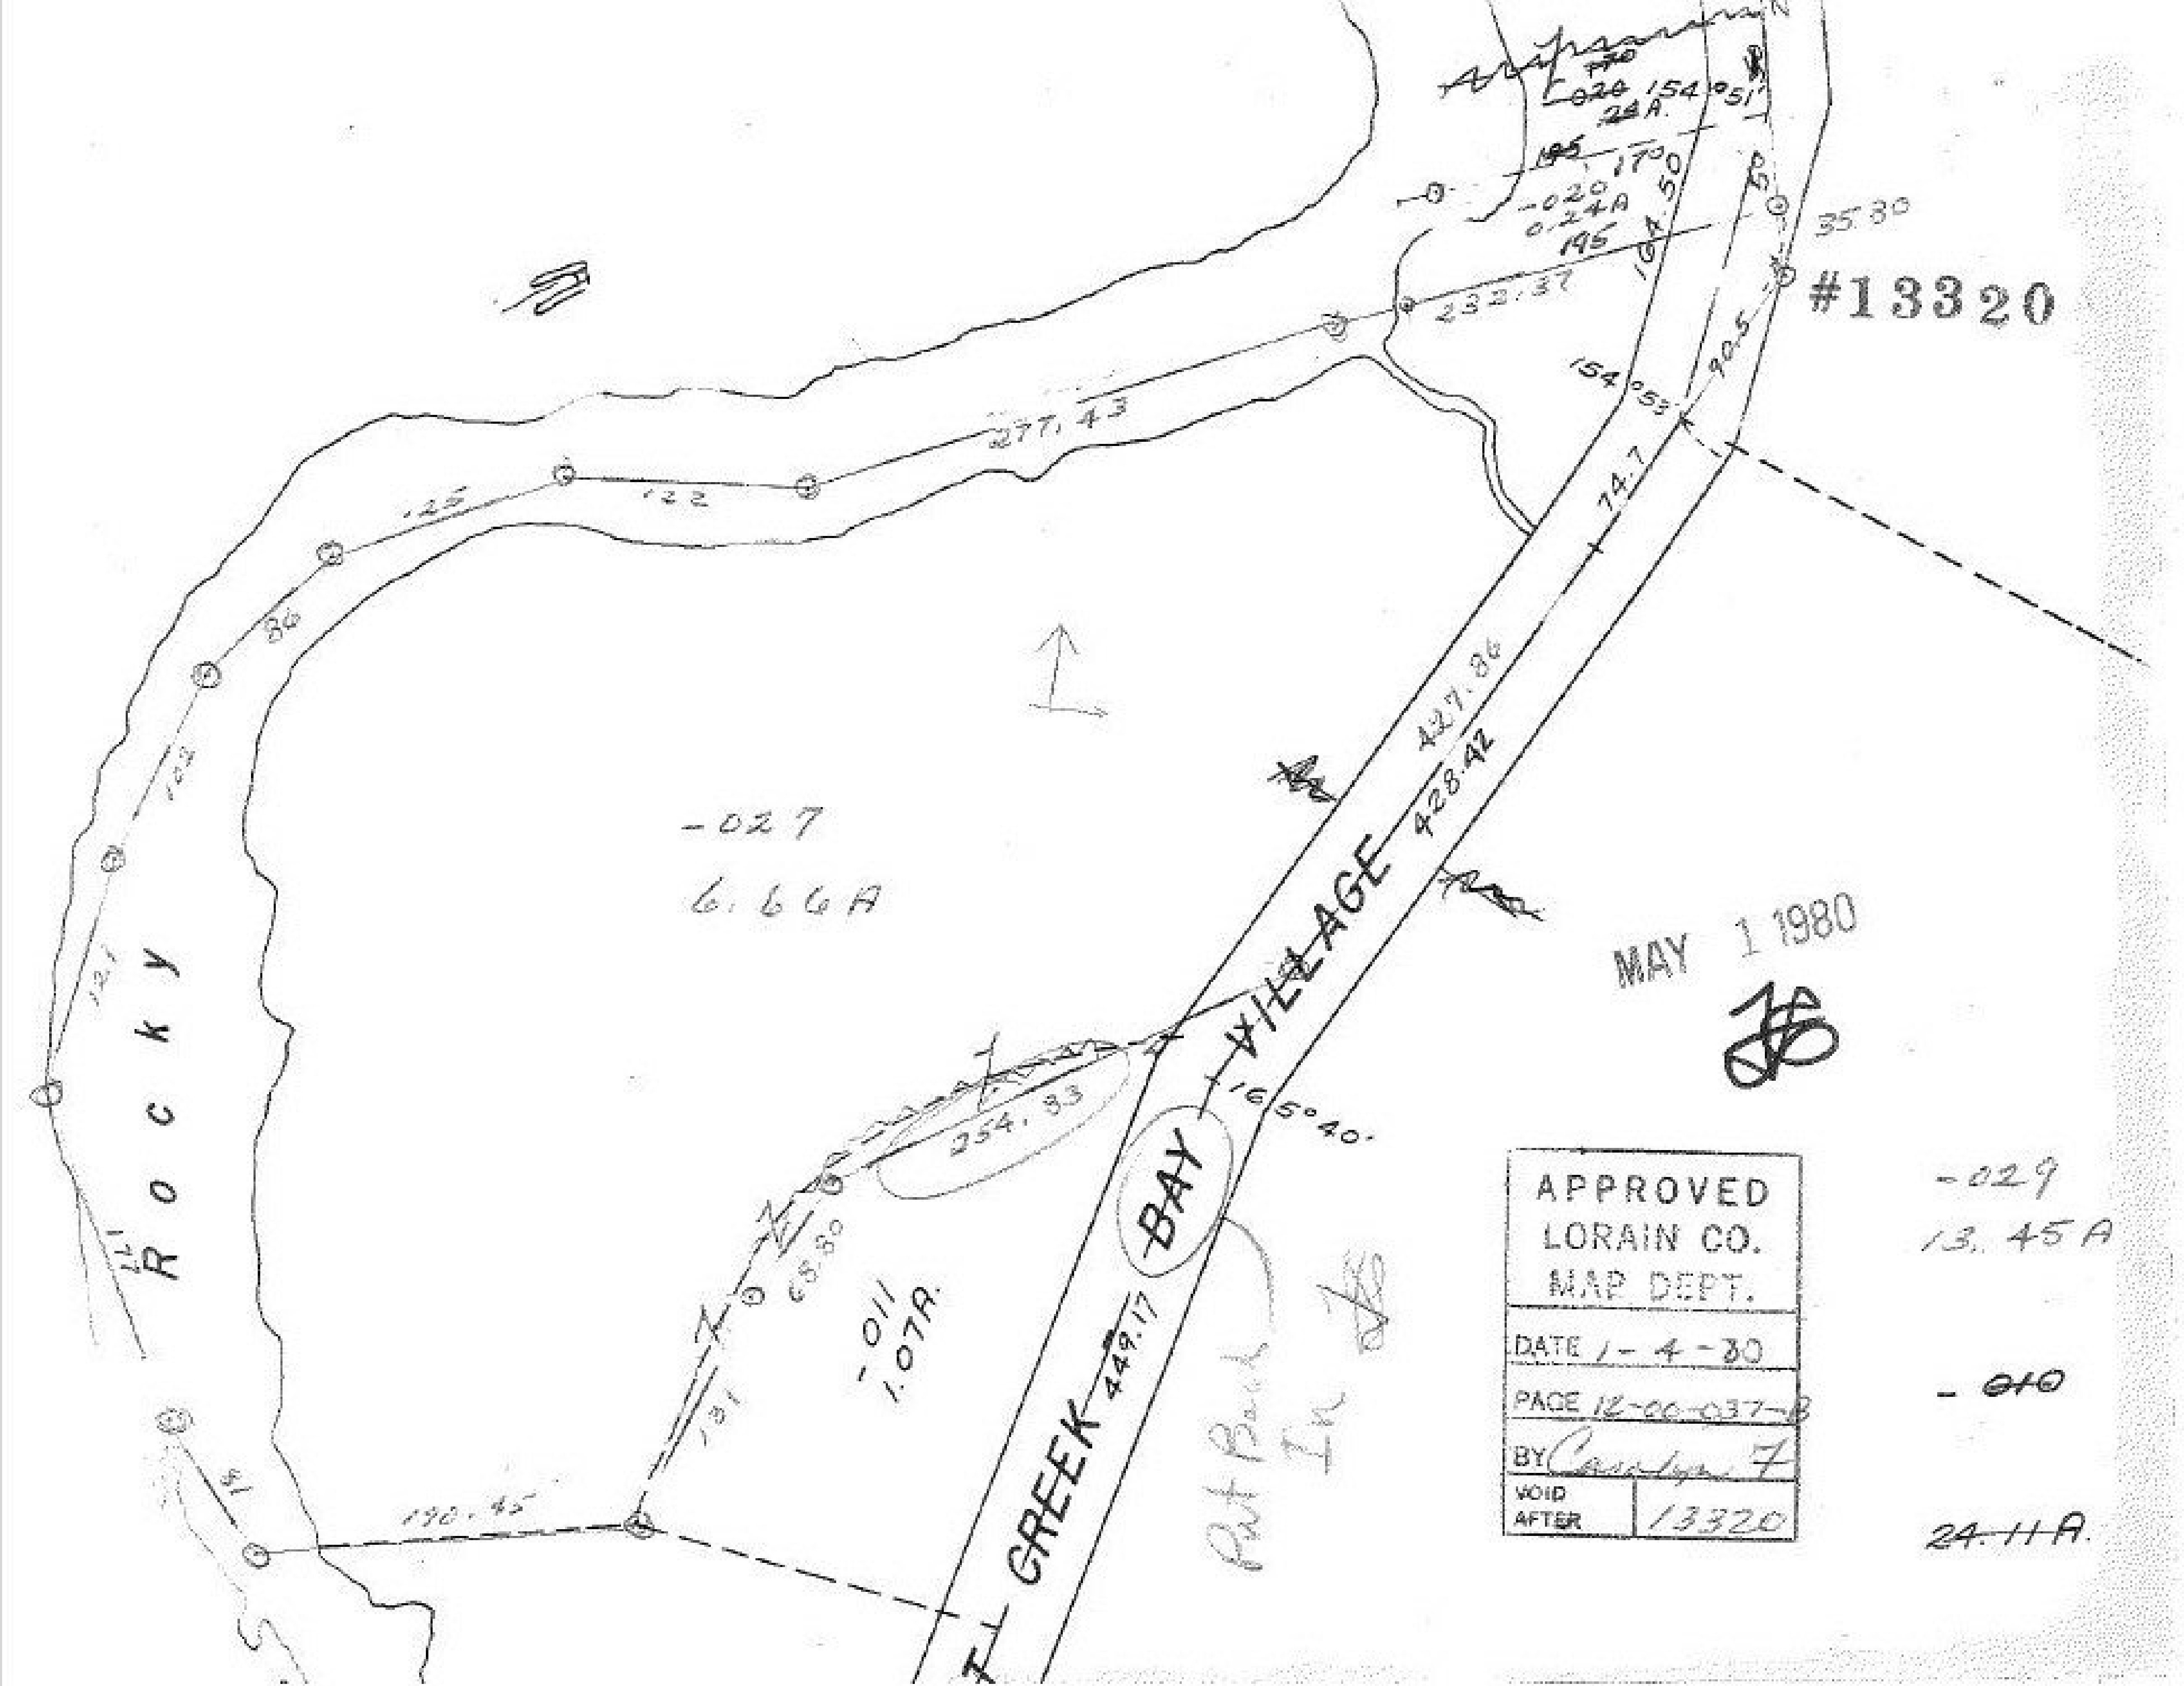
#13320
Rocky
GREEK
BAY
VILLAGE
-027
6.66A
-011
1.07A.
-020
0.24A
-029
13.45A
- 010
24.11A.
277.43
232.37
427.86
428.42
449.17
254.83
190.45
165°40'
154°53'
154°51'
35°30'
104.50
14.7
90.5
65.80
131
125
122
121
177
86
18
MAY 1 1980
APPROVED
LORAIN CO.
MAP DEPT.
DATE 1-4-80
PAGE 12-00-037-B
BY Carolyn F
VOID AFTER 13320
Put Back In