#13321

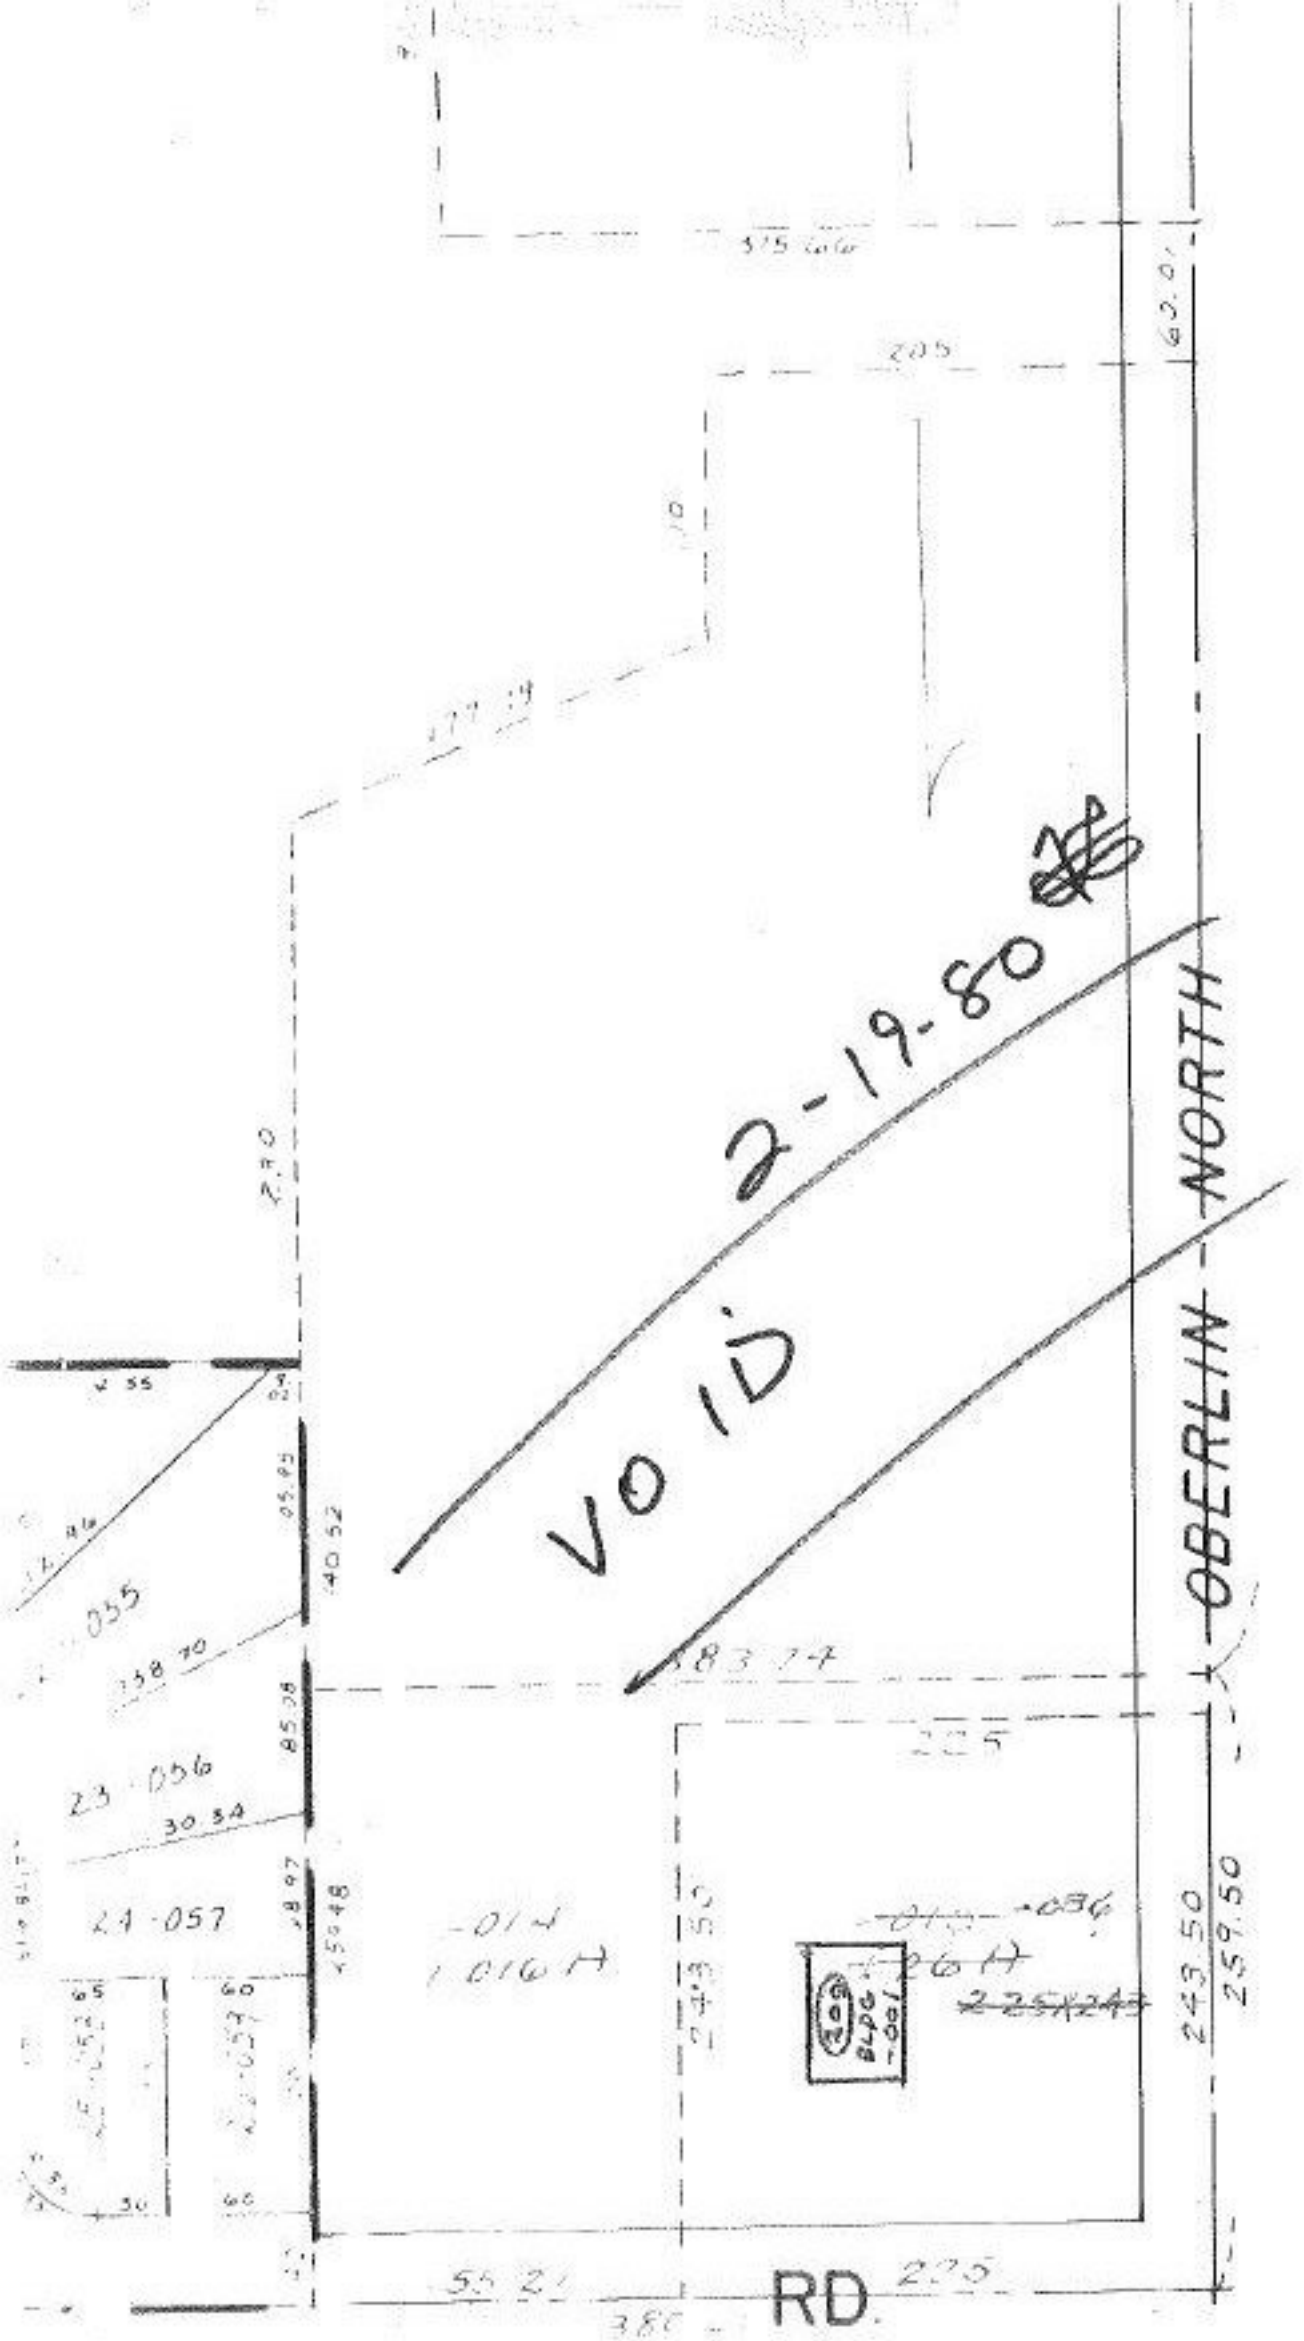

02-02-018-000-086

02-02-018-200-001
Bldg only

#13321

APPROVED
LORAIN CO.
MAP DEPT.
DATE 1-10-80
PAGE 02-02-018-B
BY Carolyn M
VOID AFTER 13321

2-02-018-B