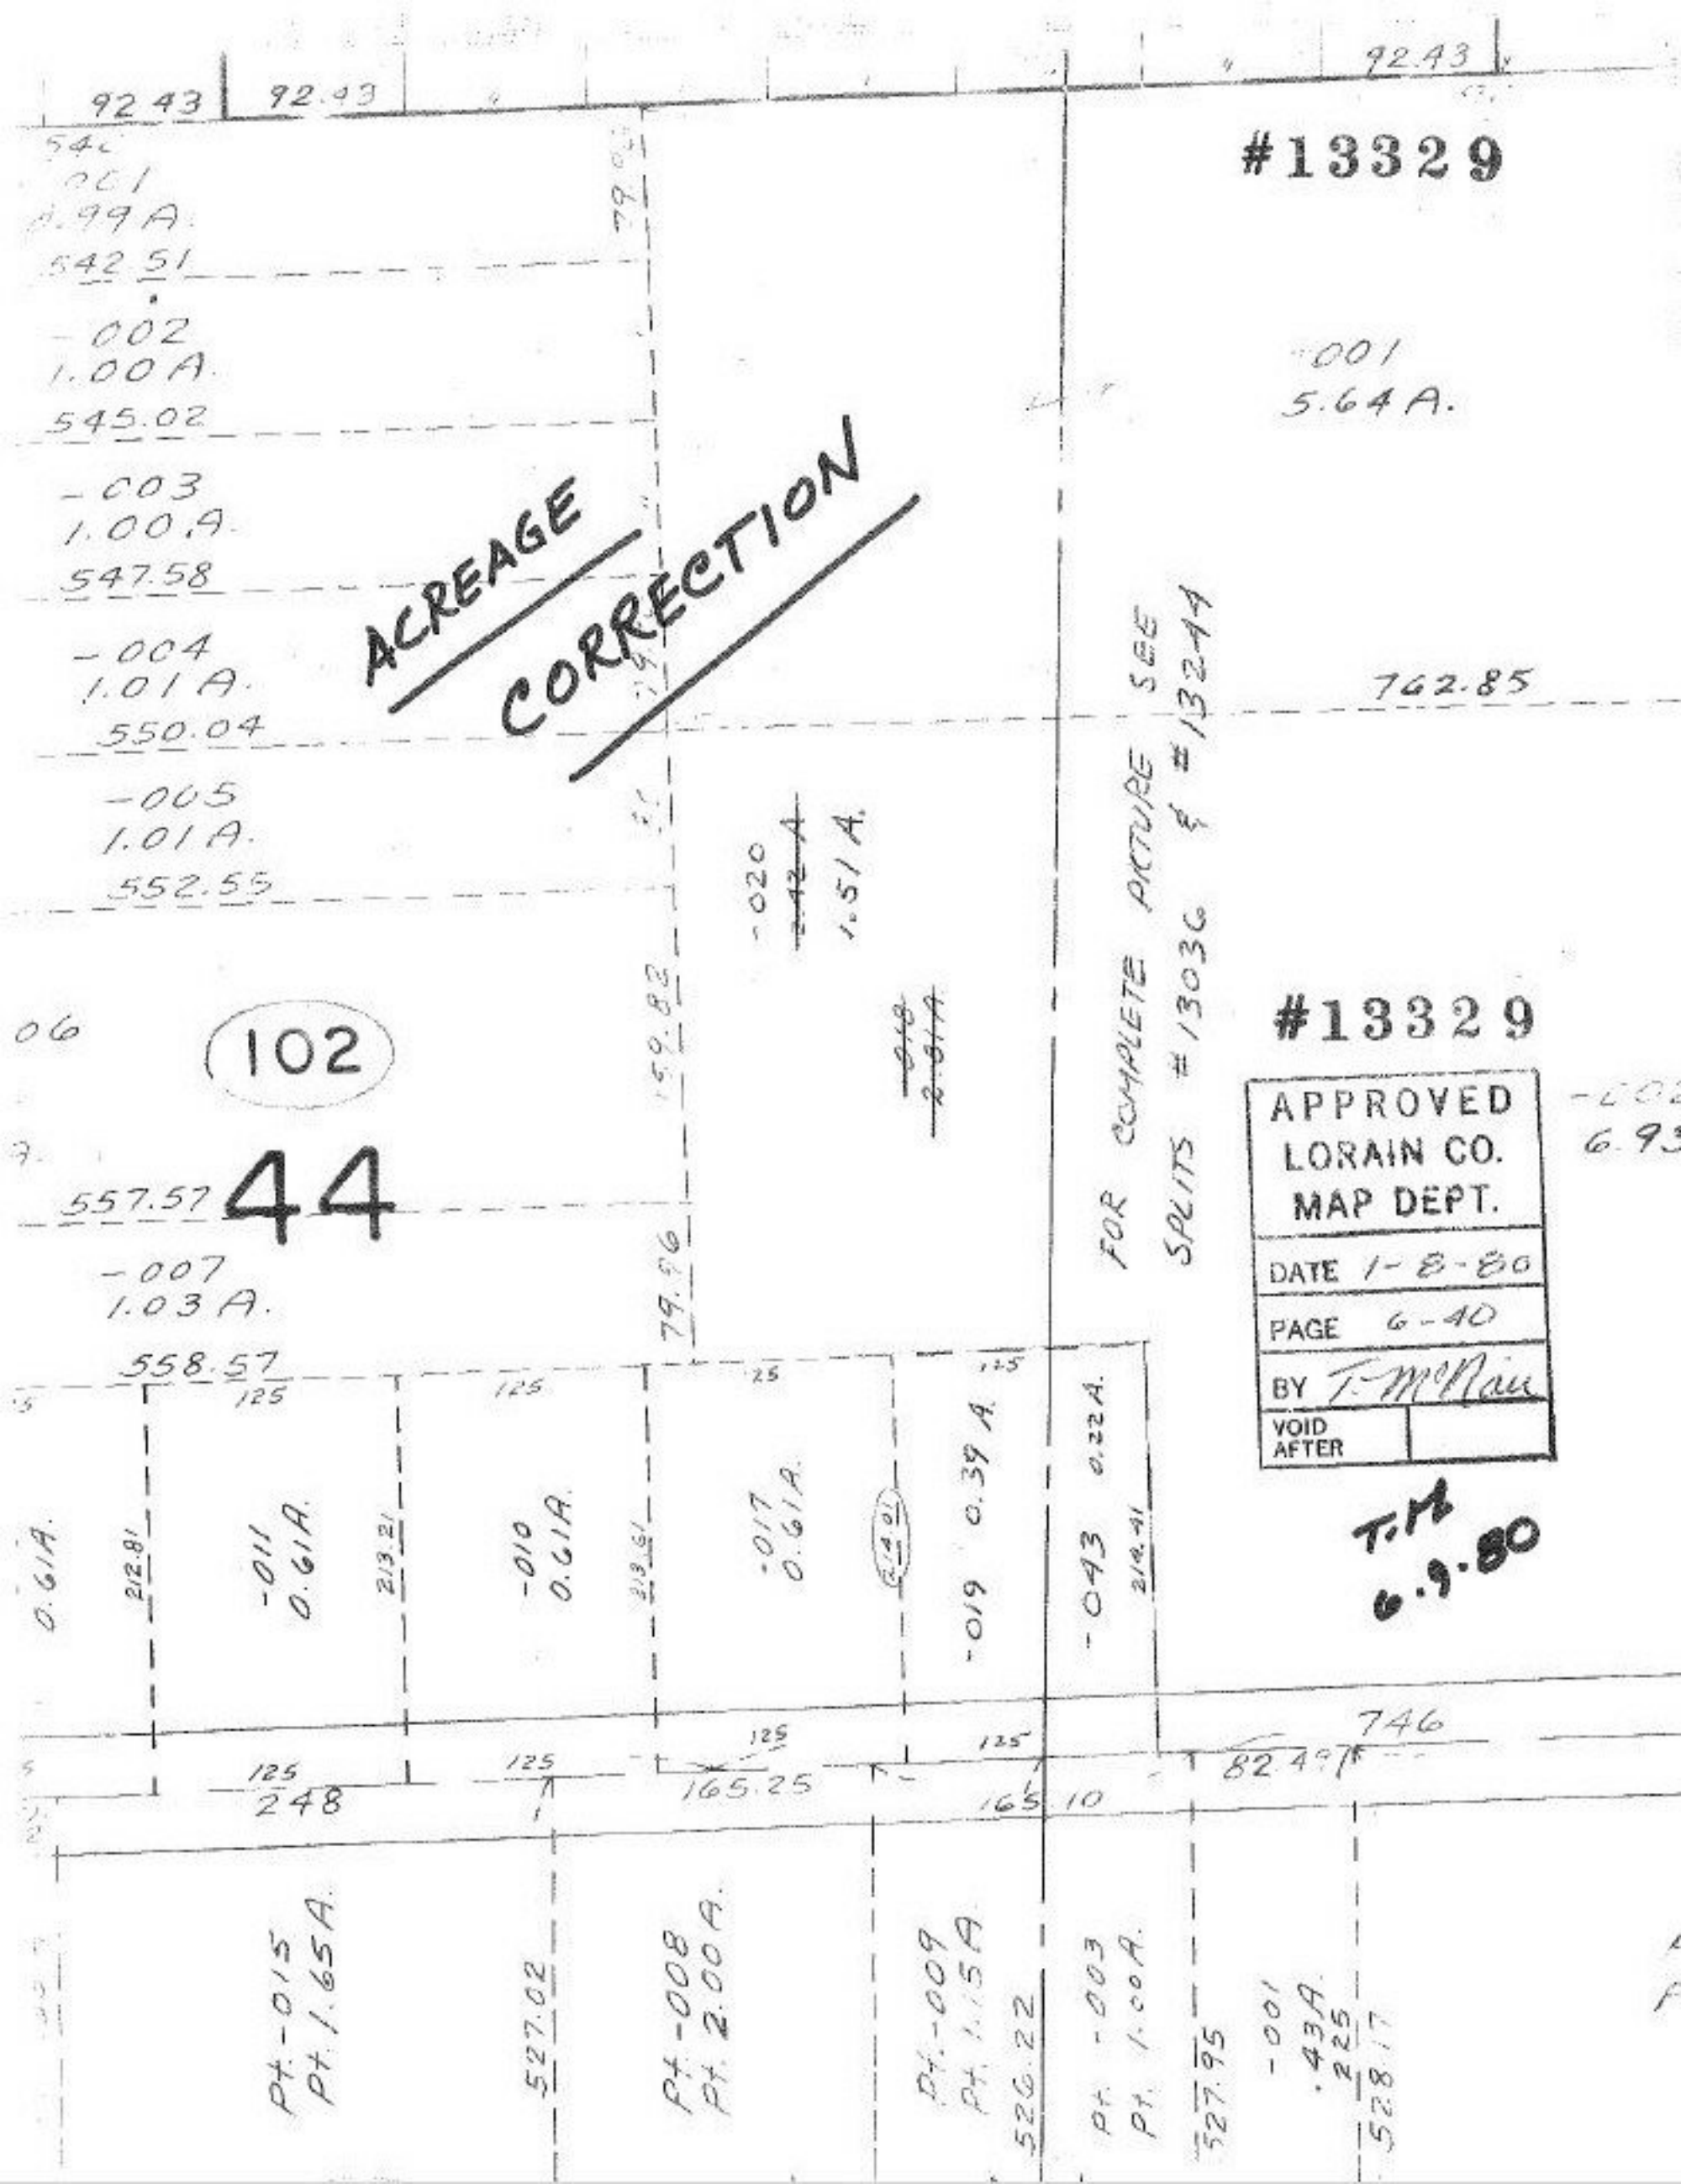

#13329
92.43
92.43
92.43
542.51
-002
1.00 A.
545.02
-003
1.00 A.
547.58
-004
1.01 A.
550.04
-005
1.01 A.
552.55
ACREAGE CORRECTION
-001
5.64 A.
762.85
-020
1.51 A.
FOR COMPLETE PICTURE SEE SPLITS #13036 & #13244
#13329
102
44
557.57
-007
1.03 A.
558.57
79.96
APPROVED
LORAIN CO.
MAP DEPT.
DATE 1-8-80
PAGE 6-40
BY T. McNair
VOID AFTER
T.M.
6.9.80
-011
0.61 A.
-010
0.61 A.
-017
0.61 A.
-019 0.39 A.
-043 0.22 A.
212.81
213.21
213.61
214.01
214.41
125
746
82.49
248
165.25
165.10
Pt. -015
Pt. 1.65 A.
527.02
Pt. -008
Pt. 2.00 A.
Pt. -009
Pt. 1.15 A.
526.22
Pt. -003
Pt. 1.00 A.
527.95
-001
.43 A.
225
528.17