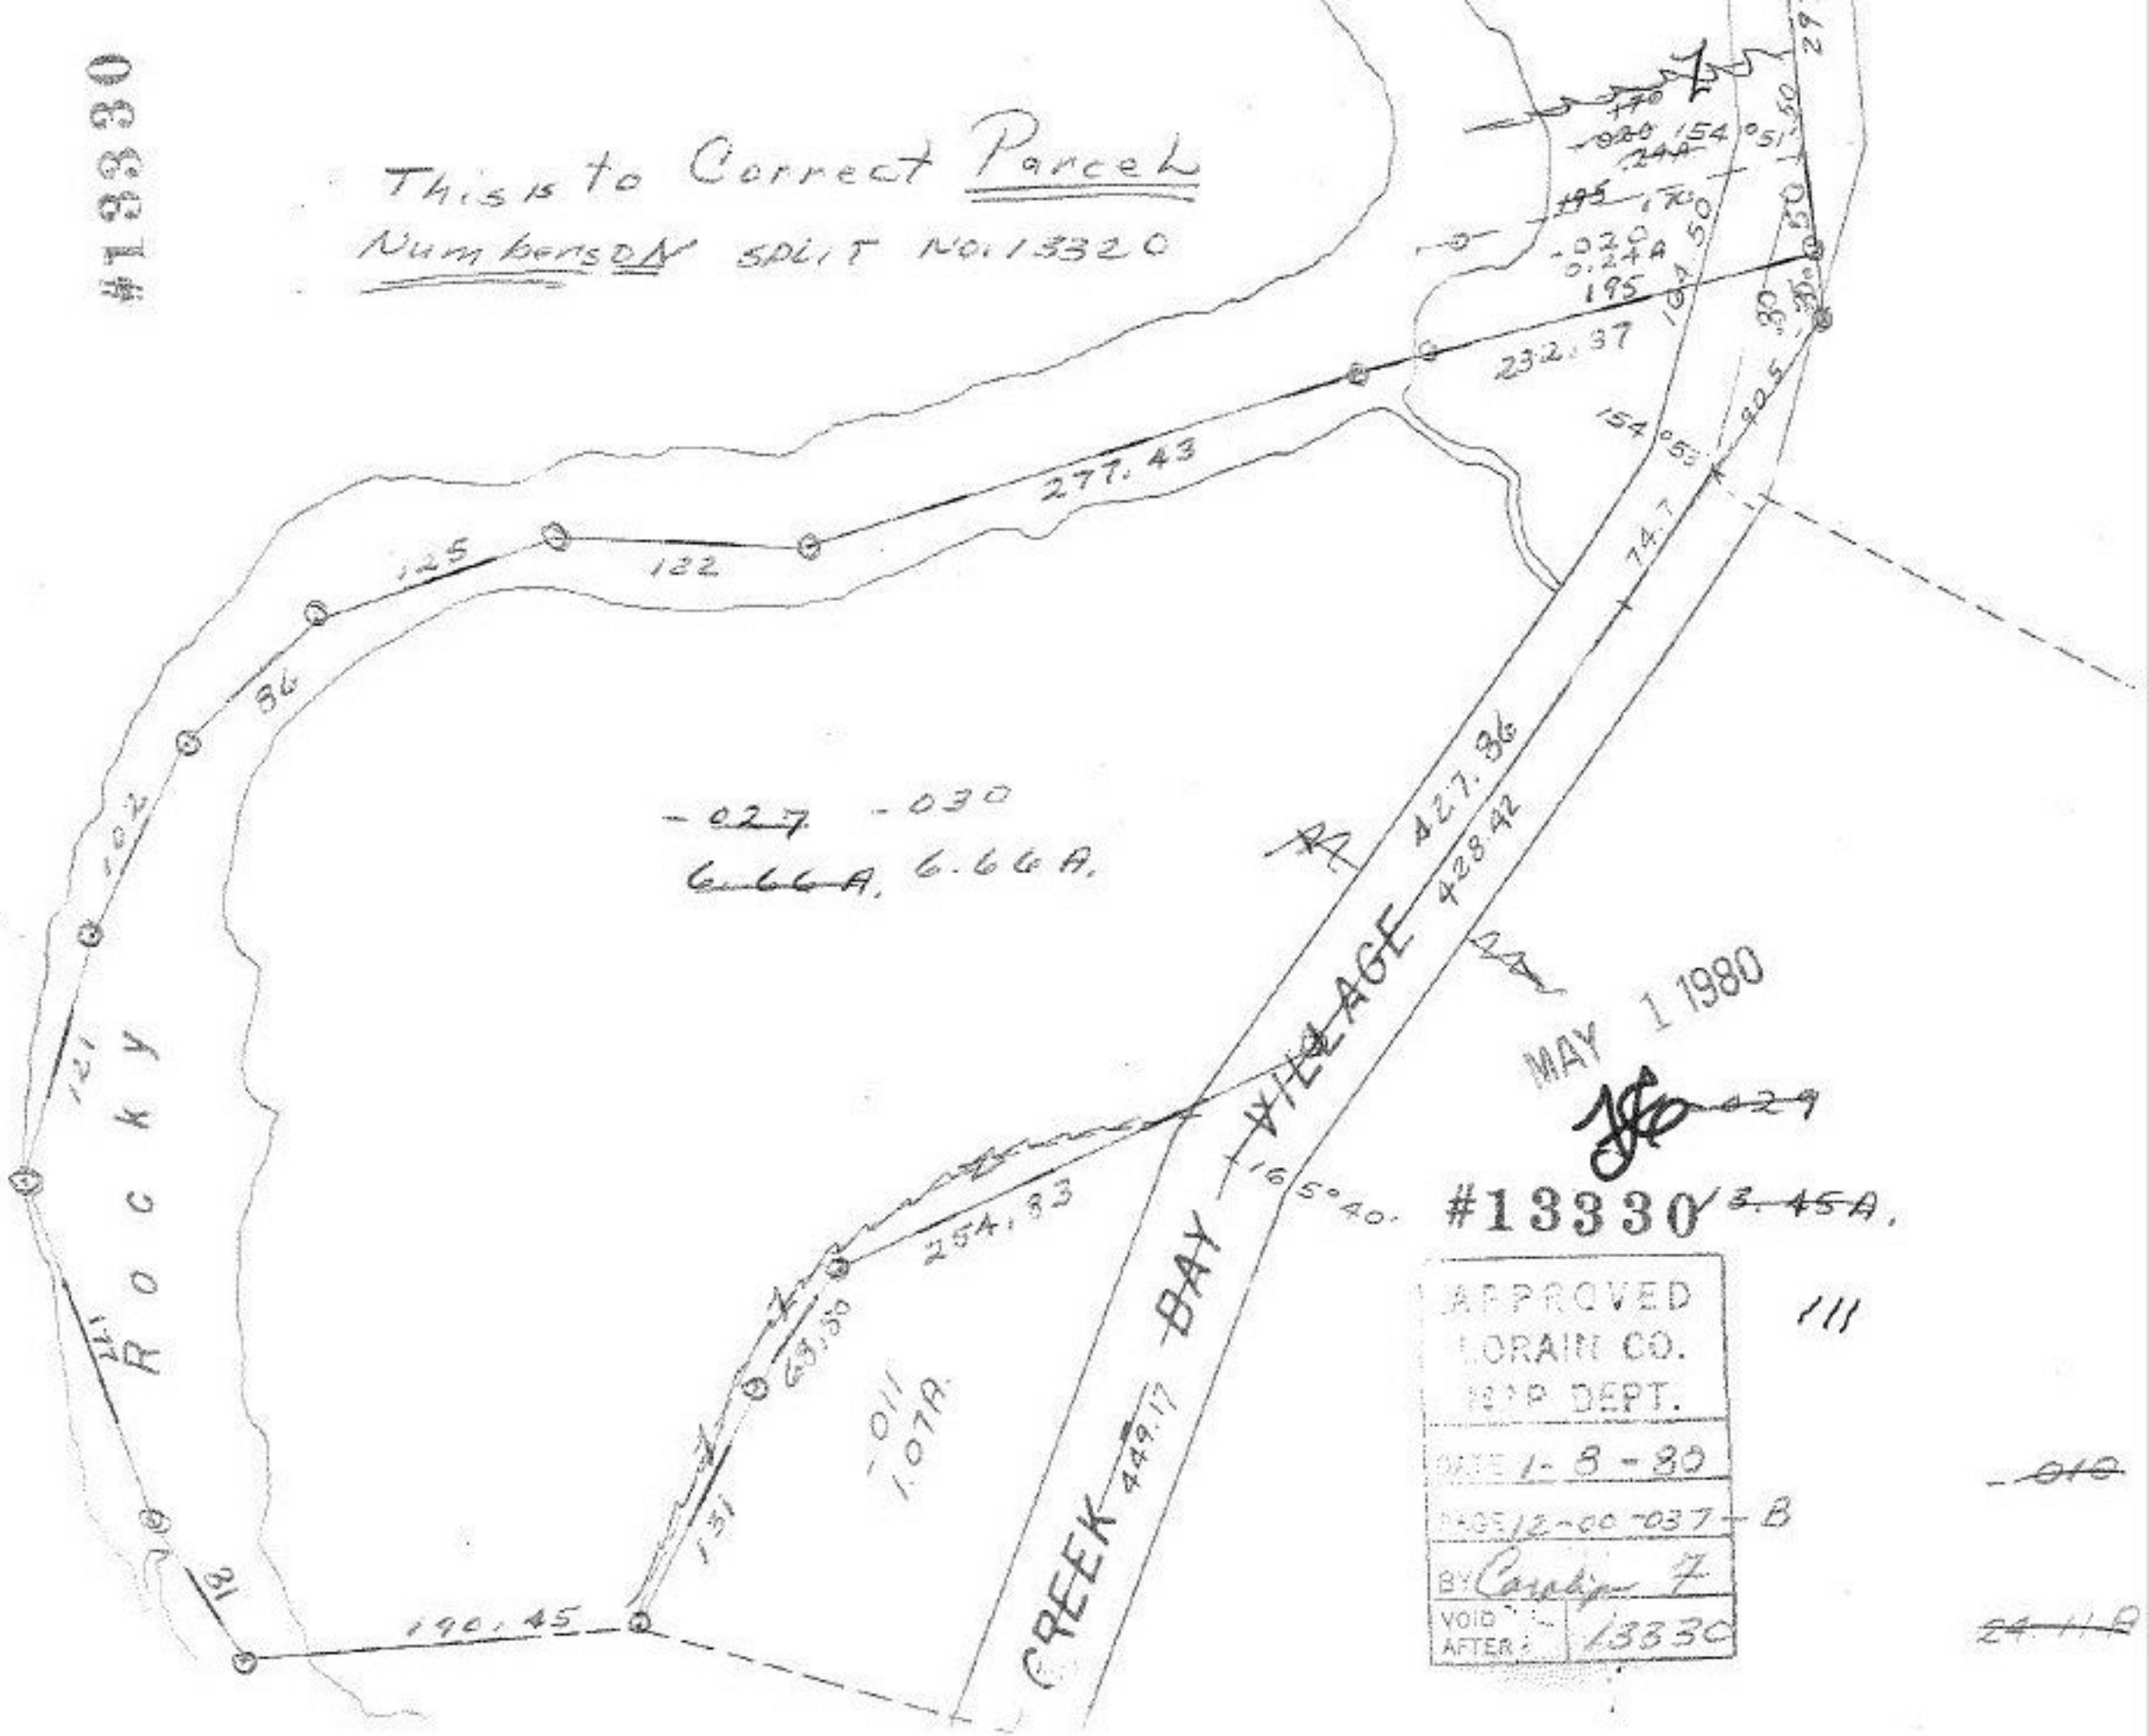

#13330
This is to Correct Parcel
Numbers ON SPLIT NO. 13320
-027 -030
6.66A. 6.66A.
-020
0.24A
195
232.37
277.43
122
125
86
102
121
ROCKY
31
190.45
131
68.80
254.83
-011
1.07A.
CREEK BAY VILLAGE
449.17
427.86
428.42
165°40'
154°51'
154°53'
74.7
90.5
MAY 1 1980
#13330
APPROVED
LORAIN CO.
MAP DEPT.
DATE 1-8-80
PAGE 12-00-037-B
BY Carolyn F
VOID AFTER 13330