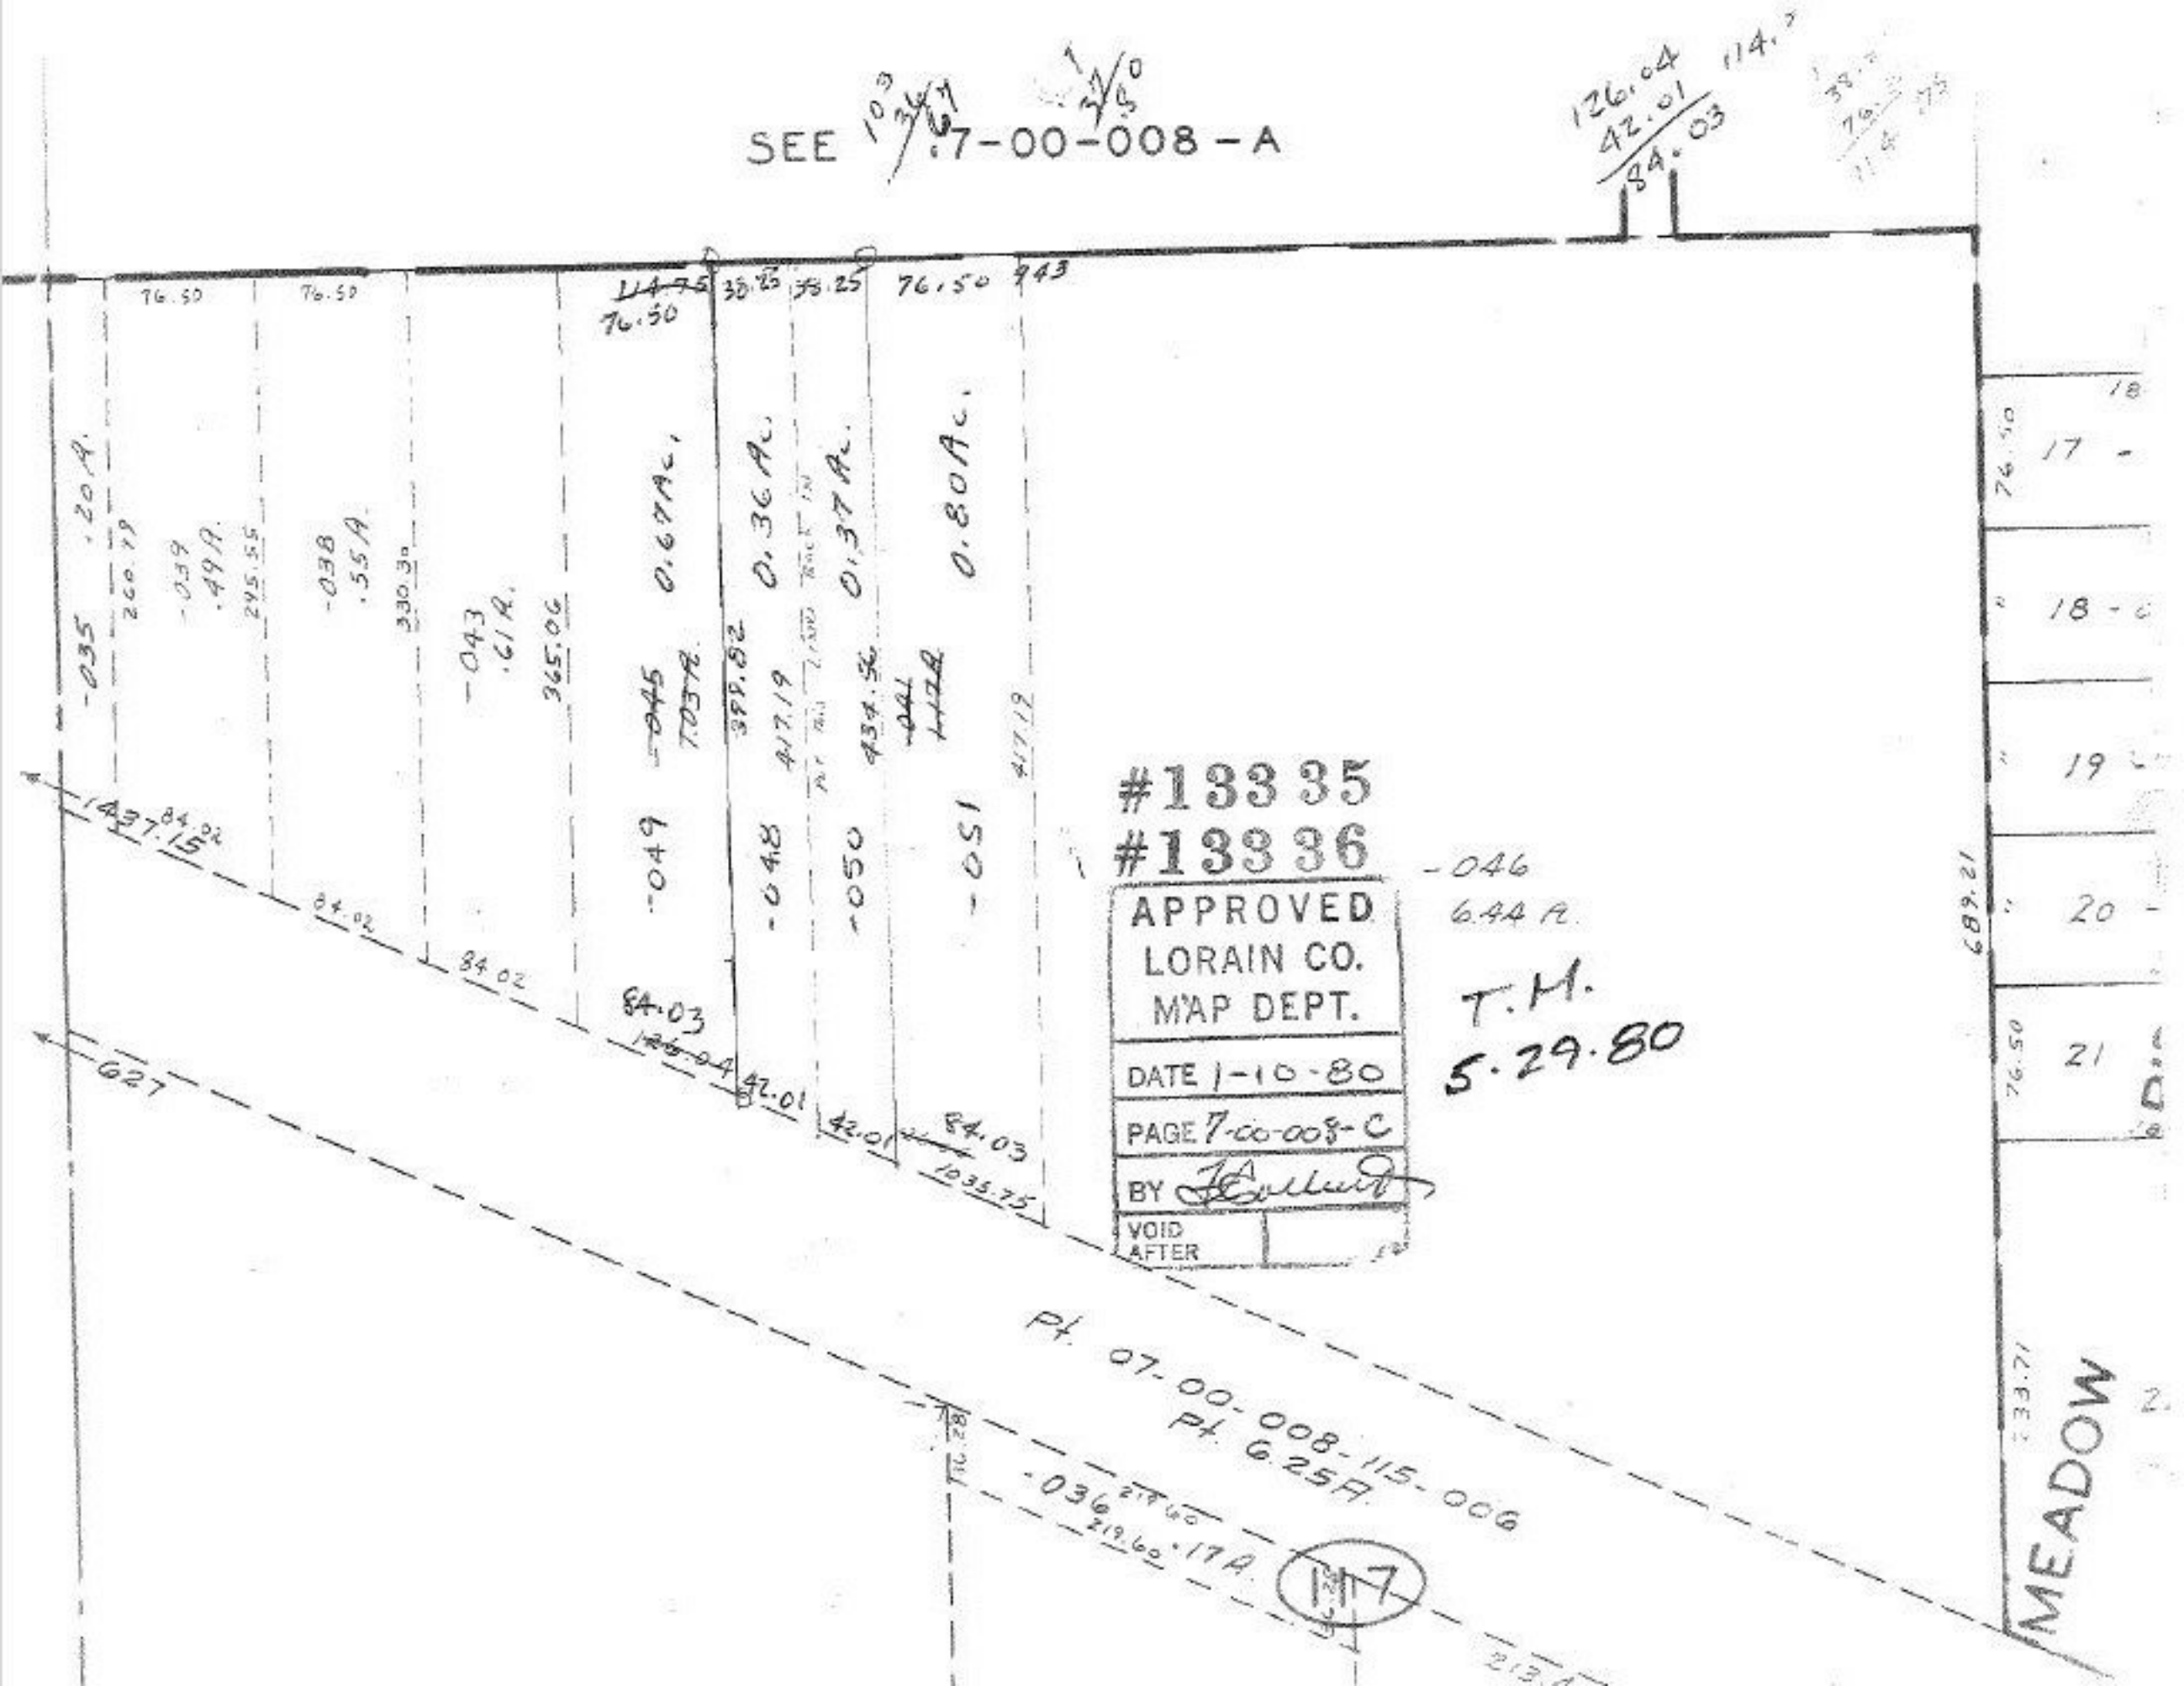
SEE 7-00-008-A
126.04
42.01
84.03
76.50
76.50
76.50
38.25
38.25
76.50
943
-035 .20A.
260.79
-039 .49A.
295.55
-038 .55A.
330.30
-043 .61A.
365.06
0.67Ac.
0.36Ac.
0.37Ac.
0.80Ac.
399.82
417.19
434.56
417.19
-049
-048
-050
-051
1437.15
84.02
84.02
84.02
84.03
42.01
42.01
84.03
1035.75
627
#13335
#13336
APPROVED
LORAIN CO.
MAP DEPT.
DATE 1-10-80
PAGE 7-00-008-C
BY
VOID AFTER
-046
6.44 A.
T.H.
5.29.80
Pt. 07-00-008-115-006
Pt. 6.25A.
-036
219.60
219.60
.17A.
117
17
18
19
20
21
MEADOW