#13345

Tom Draw This One On Too. Was Drawn on Page 4-5

-130
12.68 A.

~~-044~~
~~14.34 A~~
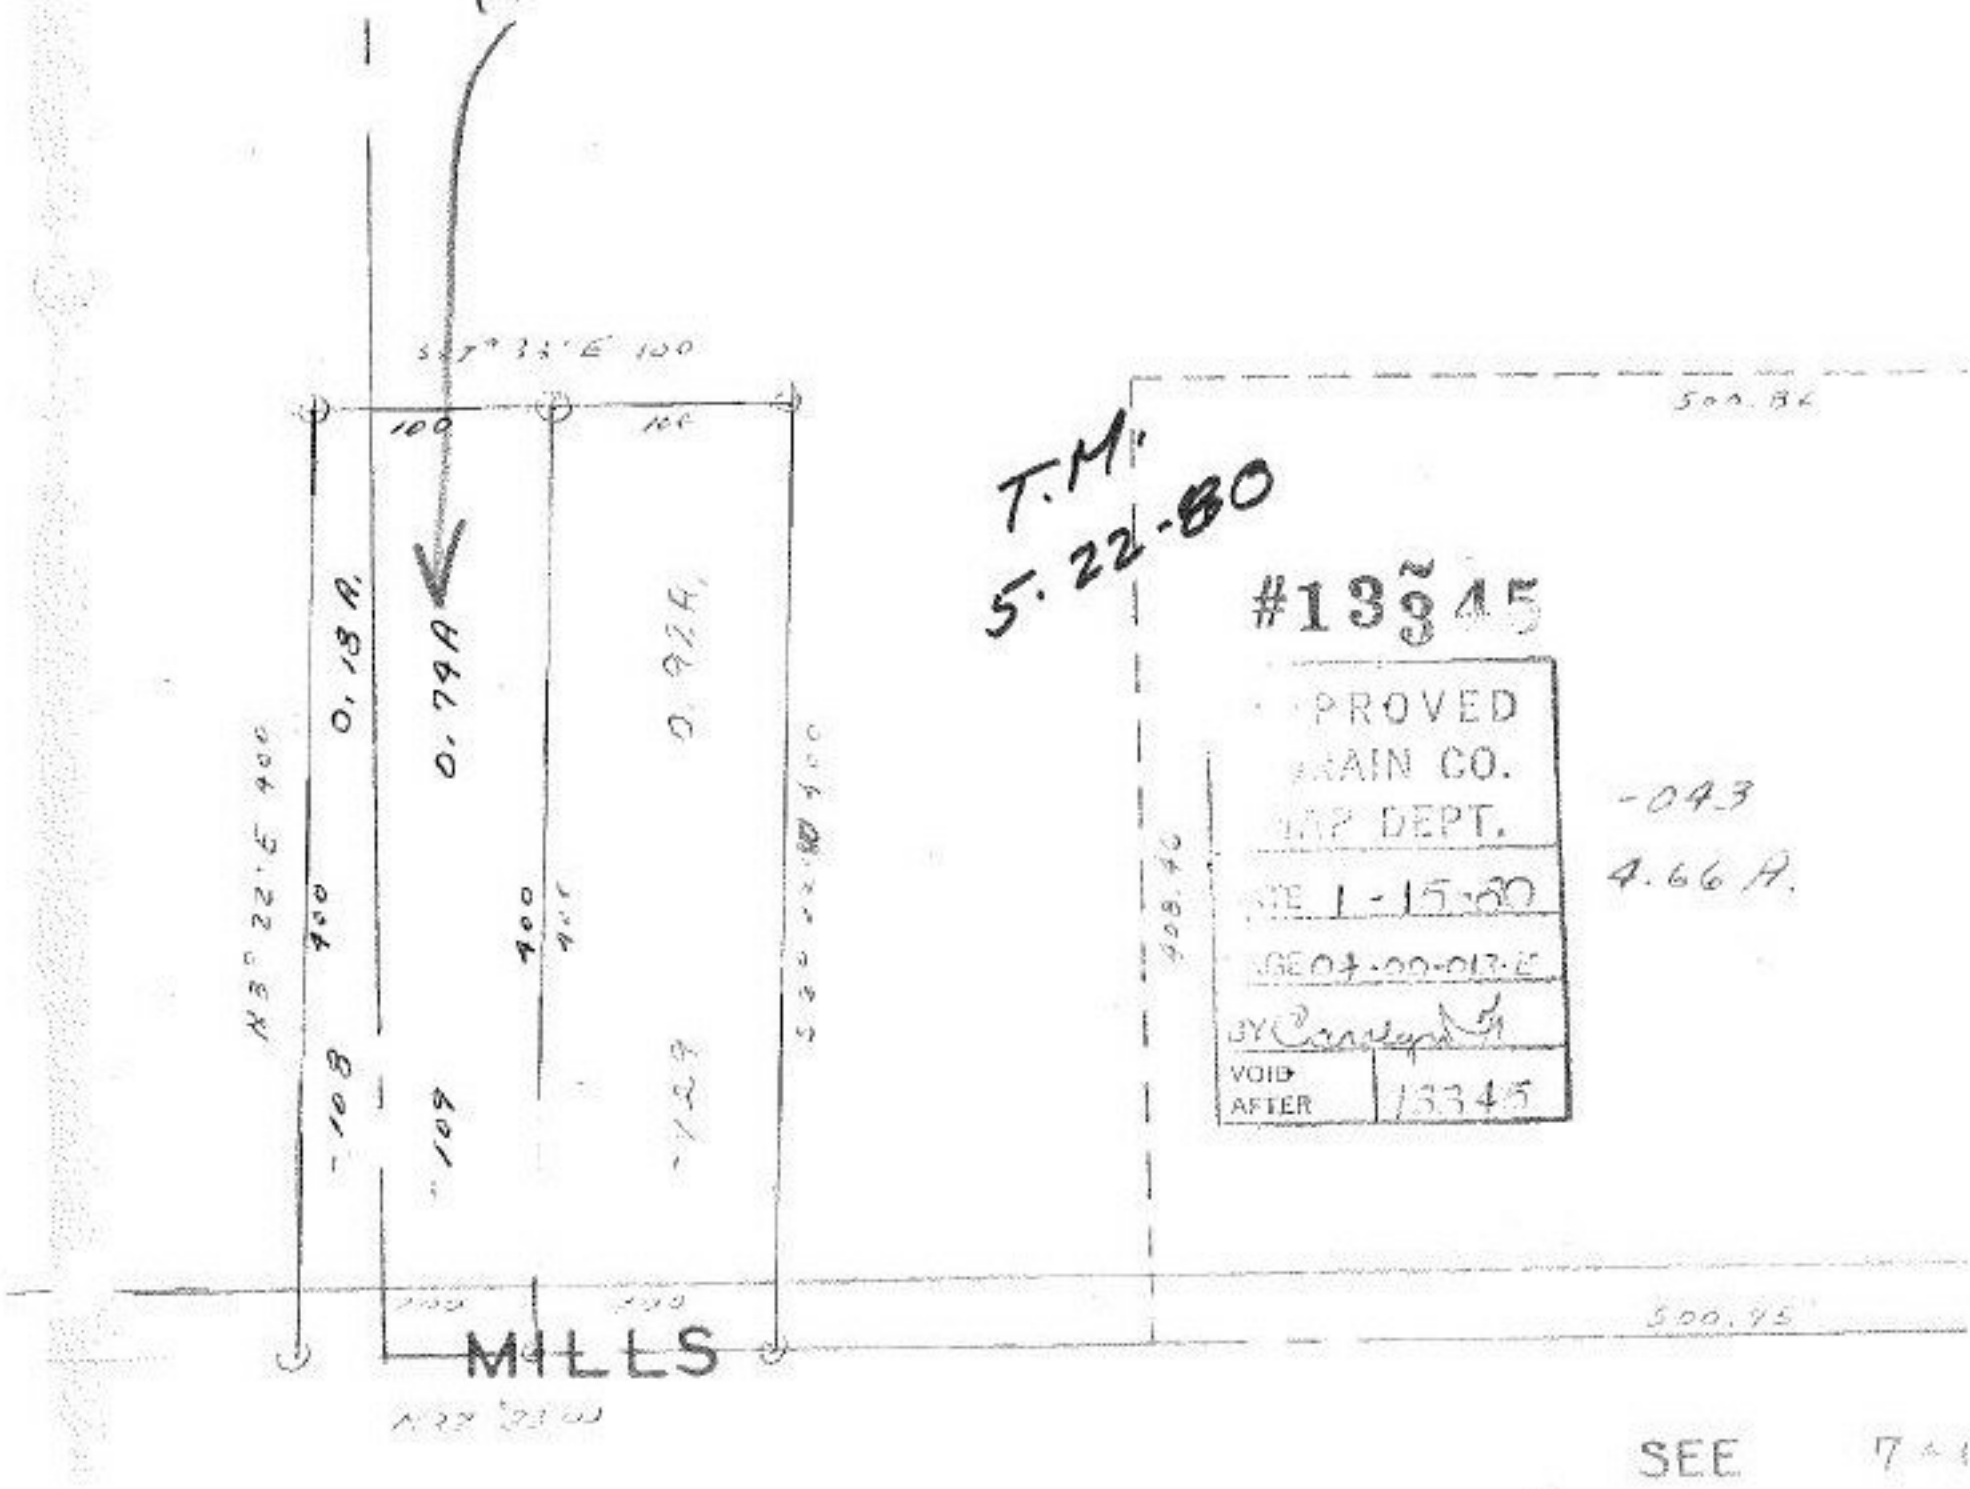
-110
13.60 A.