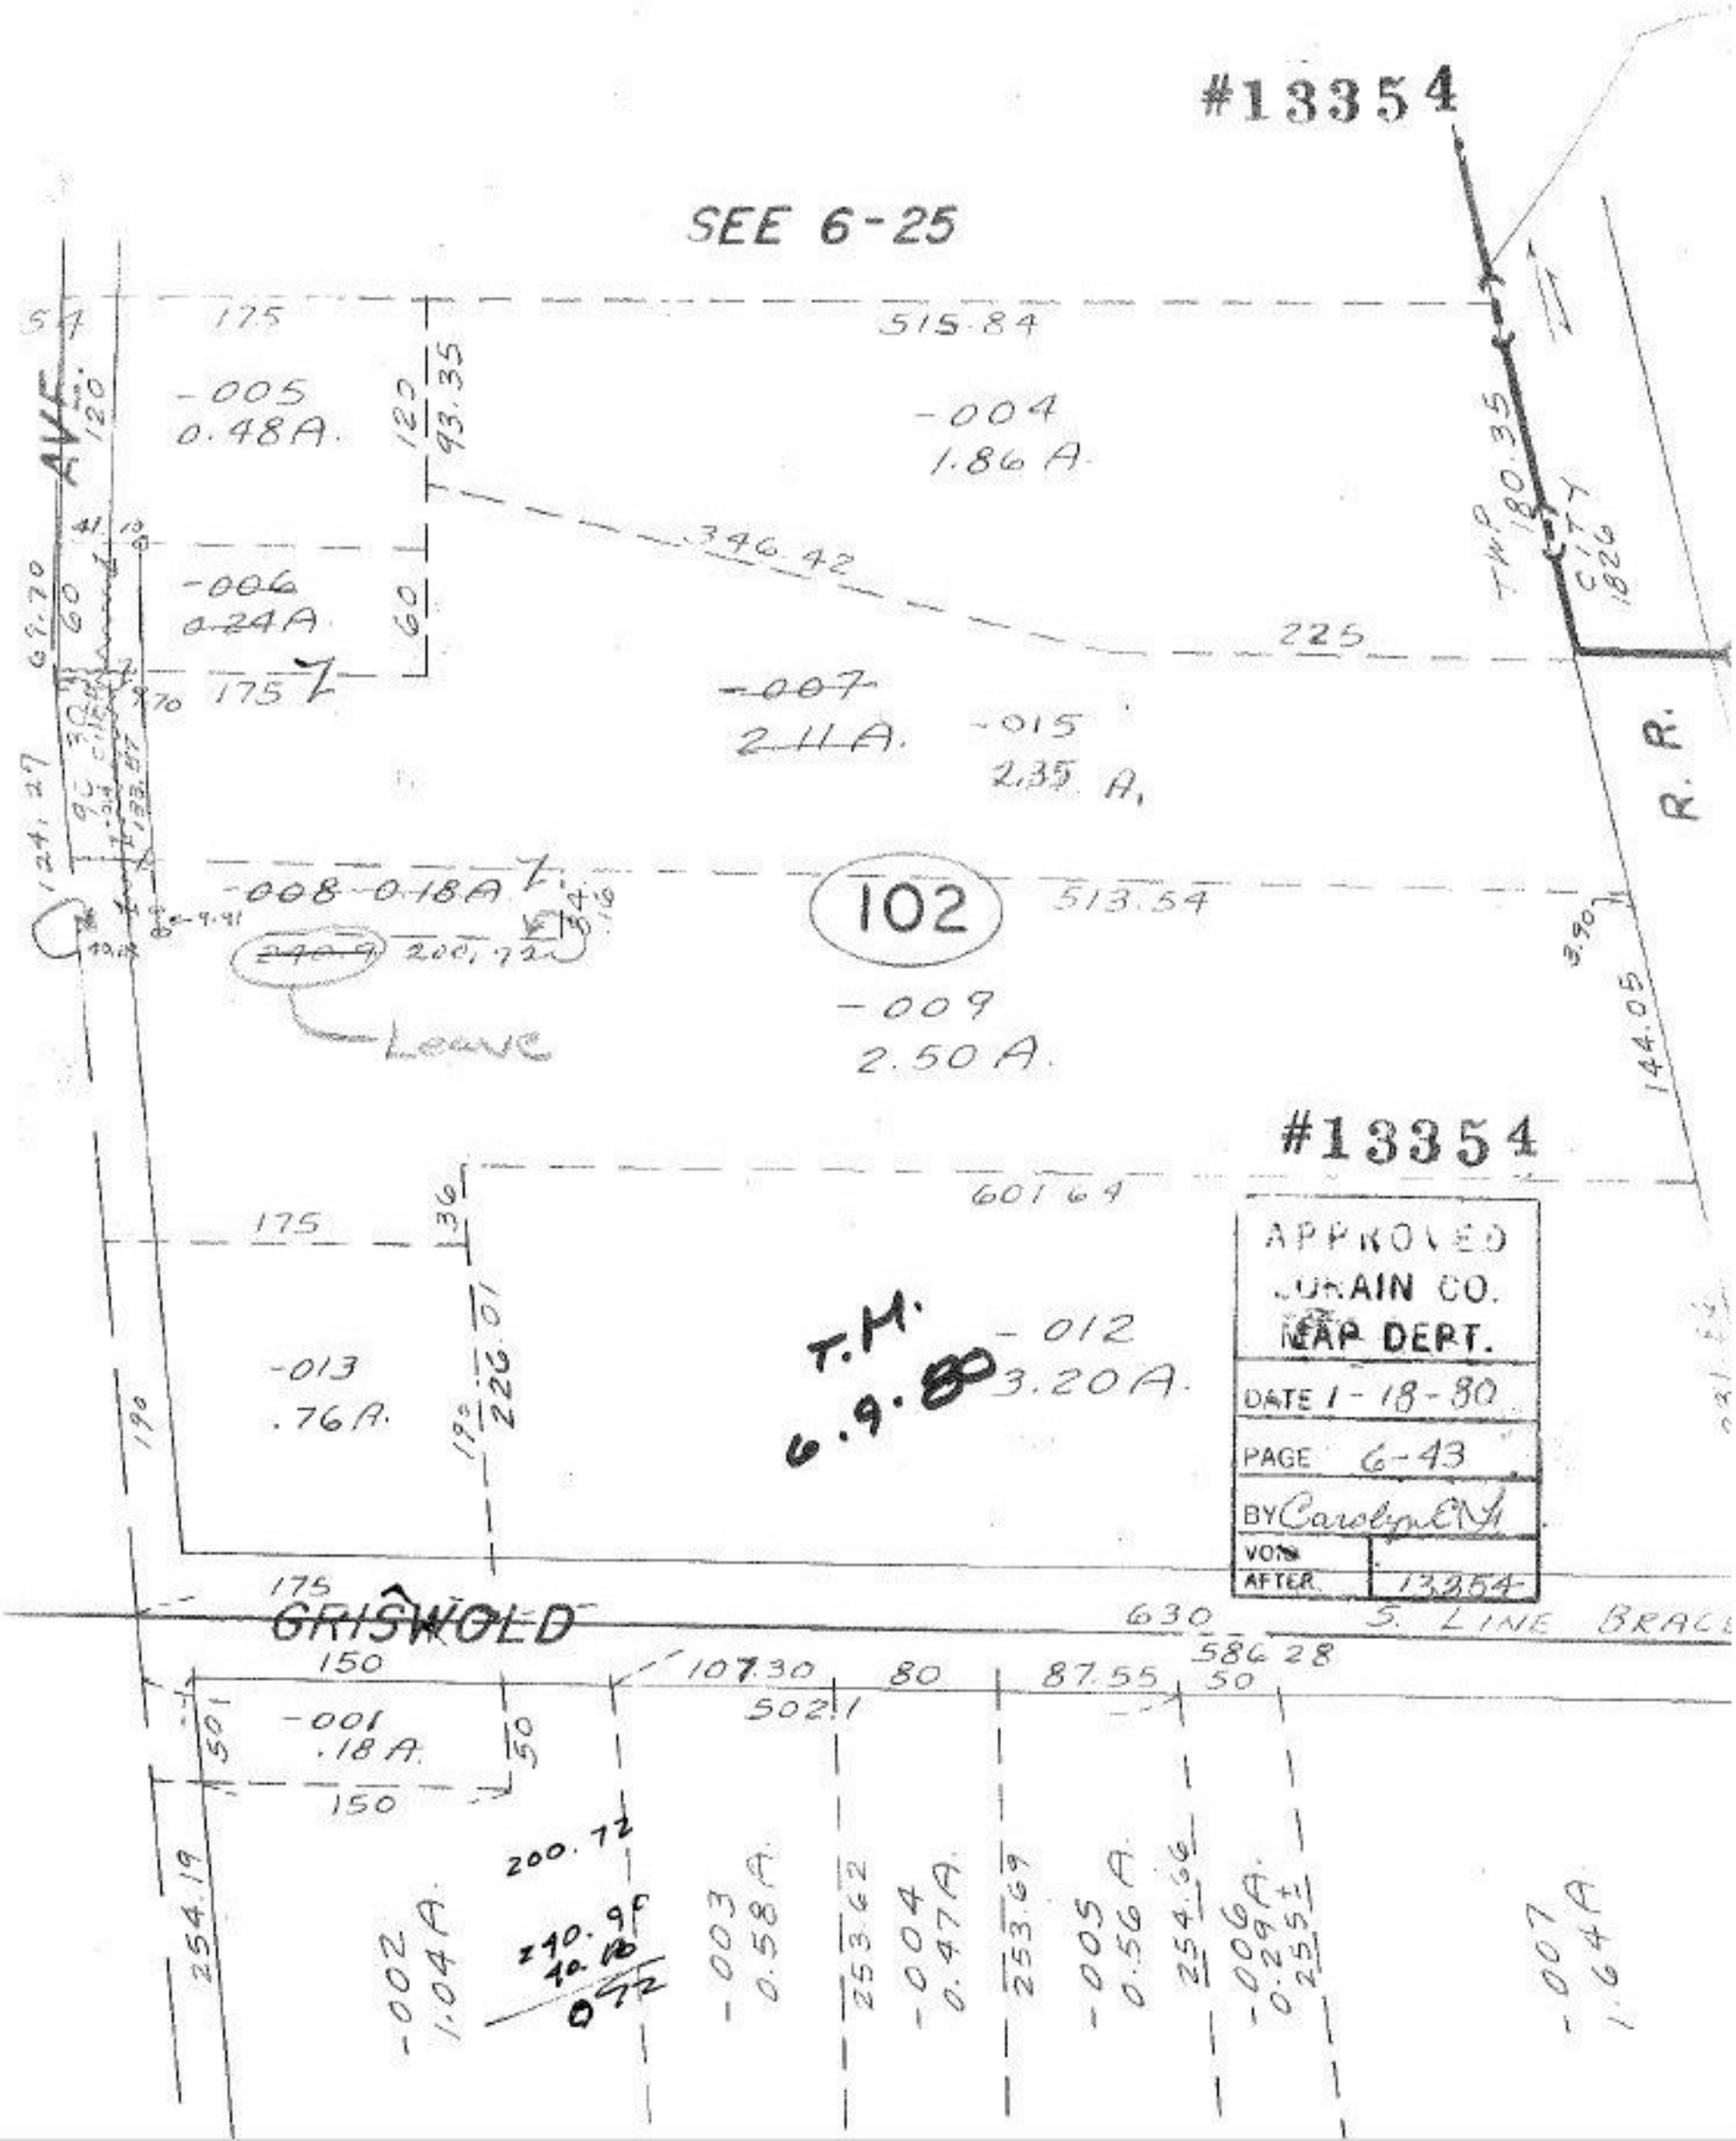
#13354
SEE 6-25
175
515.84
-005
0.48A.
120
93.35
-004
1.86 A.
AVE
TWP 180.35
CITY 1826
346.42
-006
0.24A
60
225
175
-007
2.11A.
-015
2.35 A.
R. R.
-008 0.18A
102
513.54
200.72
Leave
-009
2.50 A.
144.05
#13354
601.64
175
36
-013
.76A.
226.01
T.M.
6.9.80
-012
3.20A.
APPROVED
JURAIN CO.
MAP DEPT.
DATE 1-18-80
PAGE 6-43
BY Carolyn E.
VOID
AFTER 13354
175
GRISWOLD
630
S. LINE BRACE
150
107.30
80
87.55
586.28
50
502.1
-001
.18 A.
50
150
200.72
254.19
-002
1.04 A.
240.90
40.10
0.72
-003
0.58 A.
253.62
-004
0.47 A.
253.69
-005
0.56 A.
254.66
-006
0.29 A.
255±
-007
1.64 A.