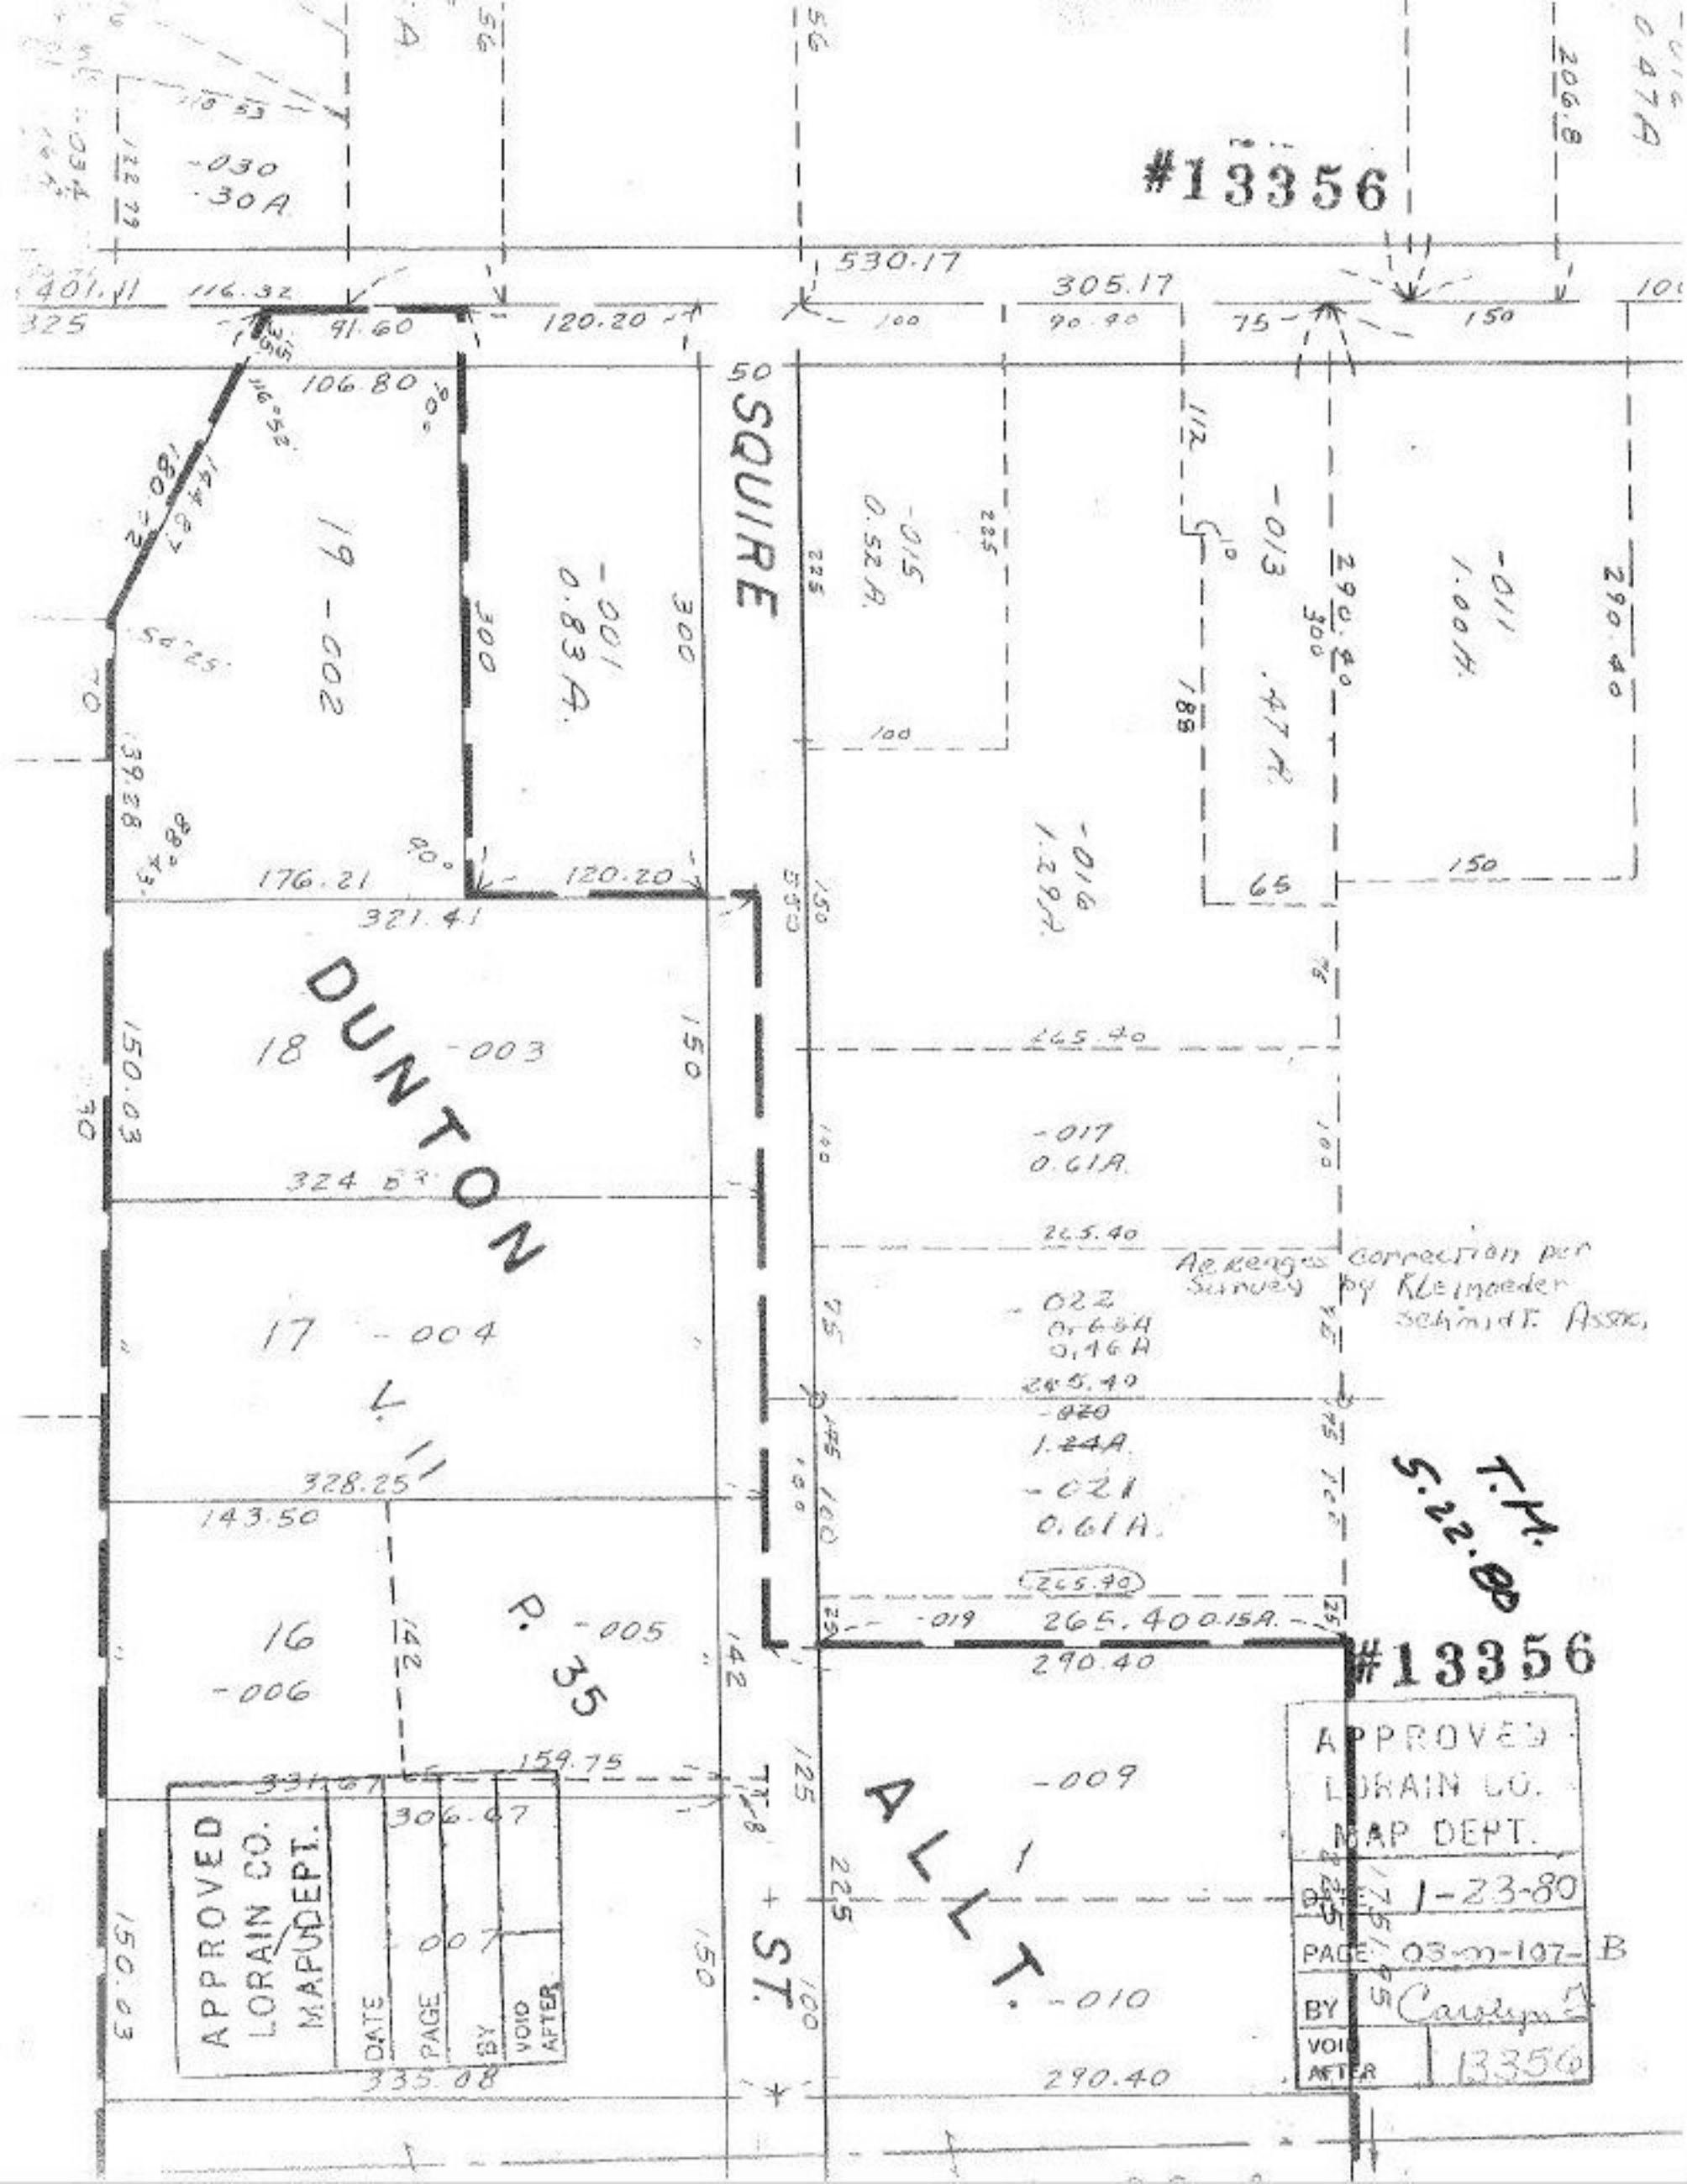
#13356
SQUIRE
DUNTON
ALLT.
ST.
P. 35
T.H.
5.22.80
#13356
APPROVED
LORAIN CO.
MAP DEPT.
DATE 1-23-80
PAGE 03-00-107-B
BY Carolyn
VOID AFTER 13356
APPROVED
LORAIN CO.
MAP DEPT.
DATE
PAGE
BY
VOID AFTER
Acreages correction per survey by Kleinoeder Schmidt Assoc.
530.17
305.17
401.11
116.32
91.60
120.20
106.80
176.21
321.41
324.83
328.25
143.50
159.75
306.67
335.08
290.40
265.40
-030
-30A
-001
0.83A.
-015
0.52A.
-013
.47A.
-011
1.00A.
-016
1.29A.
-017
0.61A.
-022
0.66A
0.46A
-020
1.24A.
-021
0.61A.
-019
265.40 0.15A.
-009
-010
-007
-006
-005
-004
-003
19 -002
18
17
16