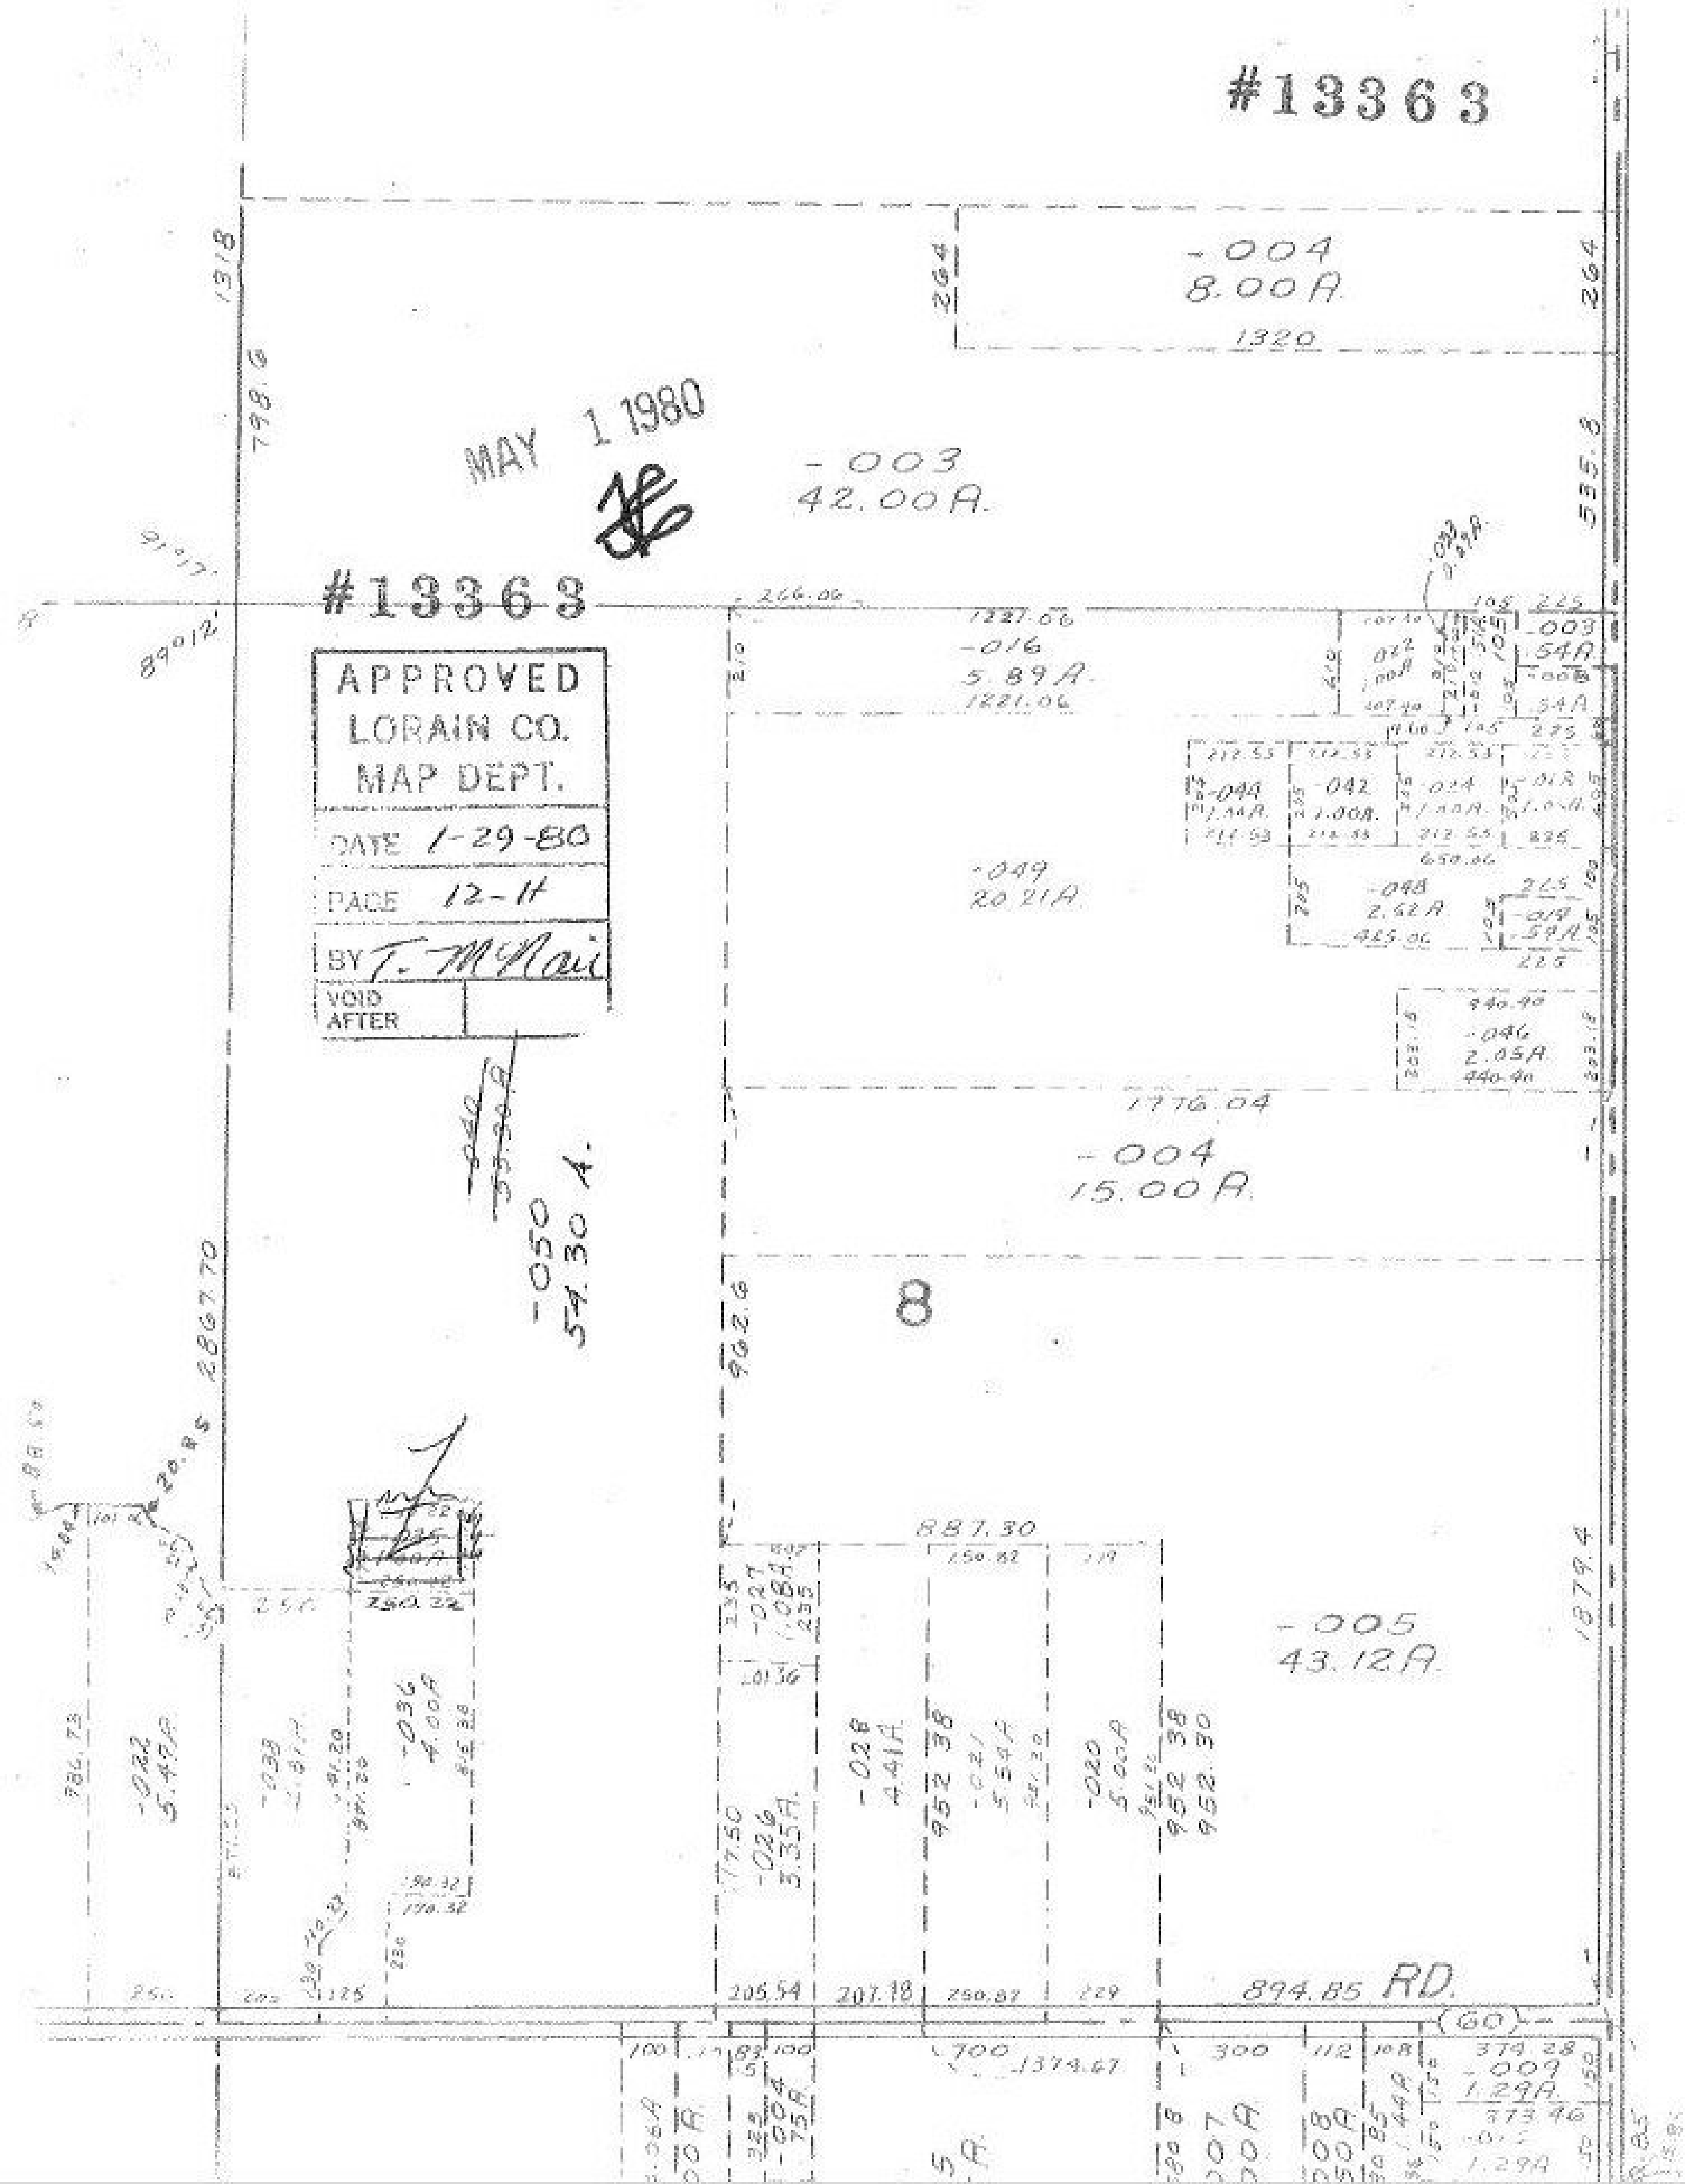
#13363
-004
8.00A.
1320
MAY 1 1980
-003
42.00A.
#13363
APPROVED
LORAIN CO.
MAP DEPT.
DATE 1-29-80
PAGE 12-11
BY T. McNair
VOID AFTER
-016
5.89A.
1221.06
-044
-042
1.00A.
-049
20.21A.
-048
2.62A
-046
2.05A.
1776.04
-004
15.00A.
-050
54.30 A.
8
887.30
-005
43.12A.
-022
-036
4.00A
-026
3.35A.
-028
4.41A.
-020
894.85 RD.
(60)
-009
1.29A.
1374.47