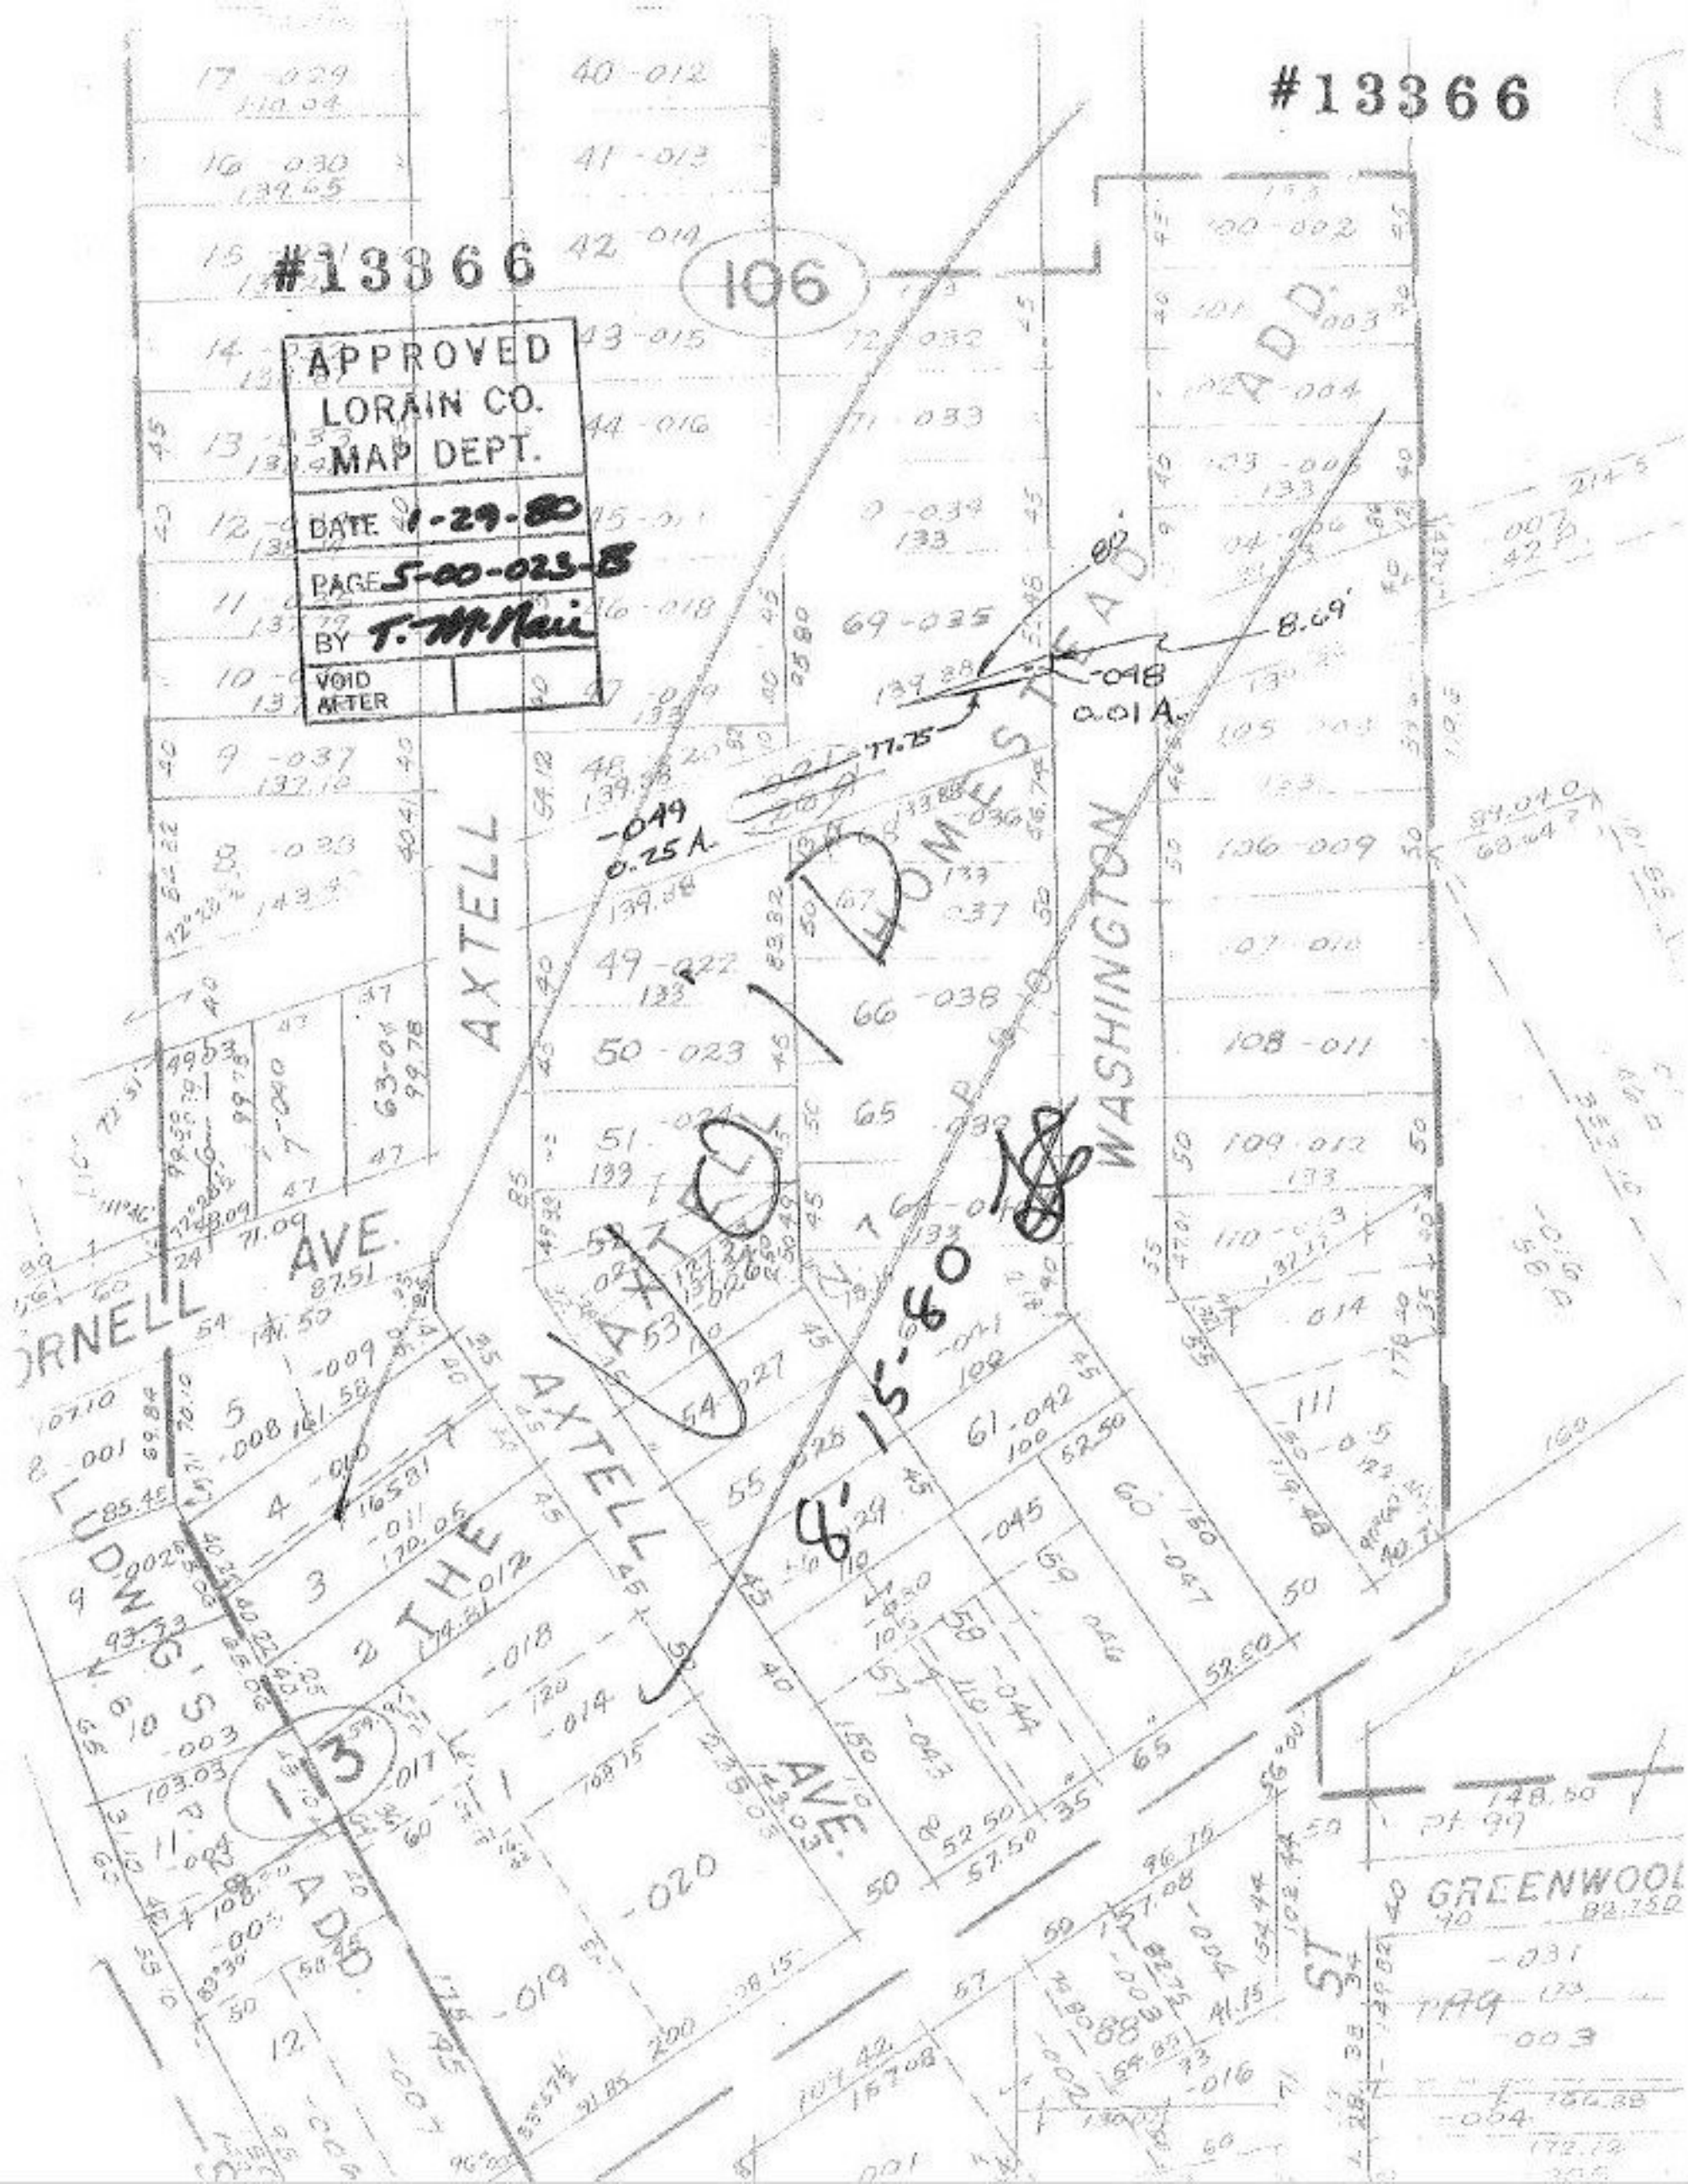
#13366
#13366
APPROVED
LORAIN CO.
MAP DEPT.
DATE 1-29-80
PAGE 5-00-023-B
BY T. McNair
VOID AFTER
106
13
AXTELL
AXTELL
AXTELL
AVE.
AVE.
WASHINGTON
ADD.
ORNELL
AVE.
LUDWIG'S
ADD.
GREENWOOD
ST
8'-15'-80
-048
0.01 A.
-049
0.25 A.
77.75
8.69'
80'