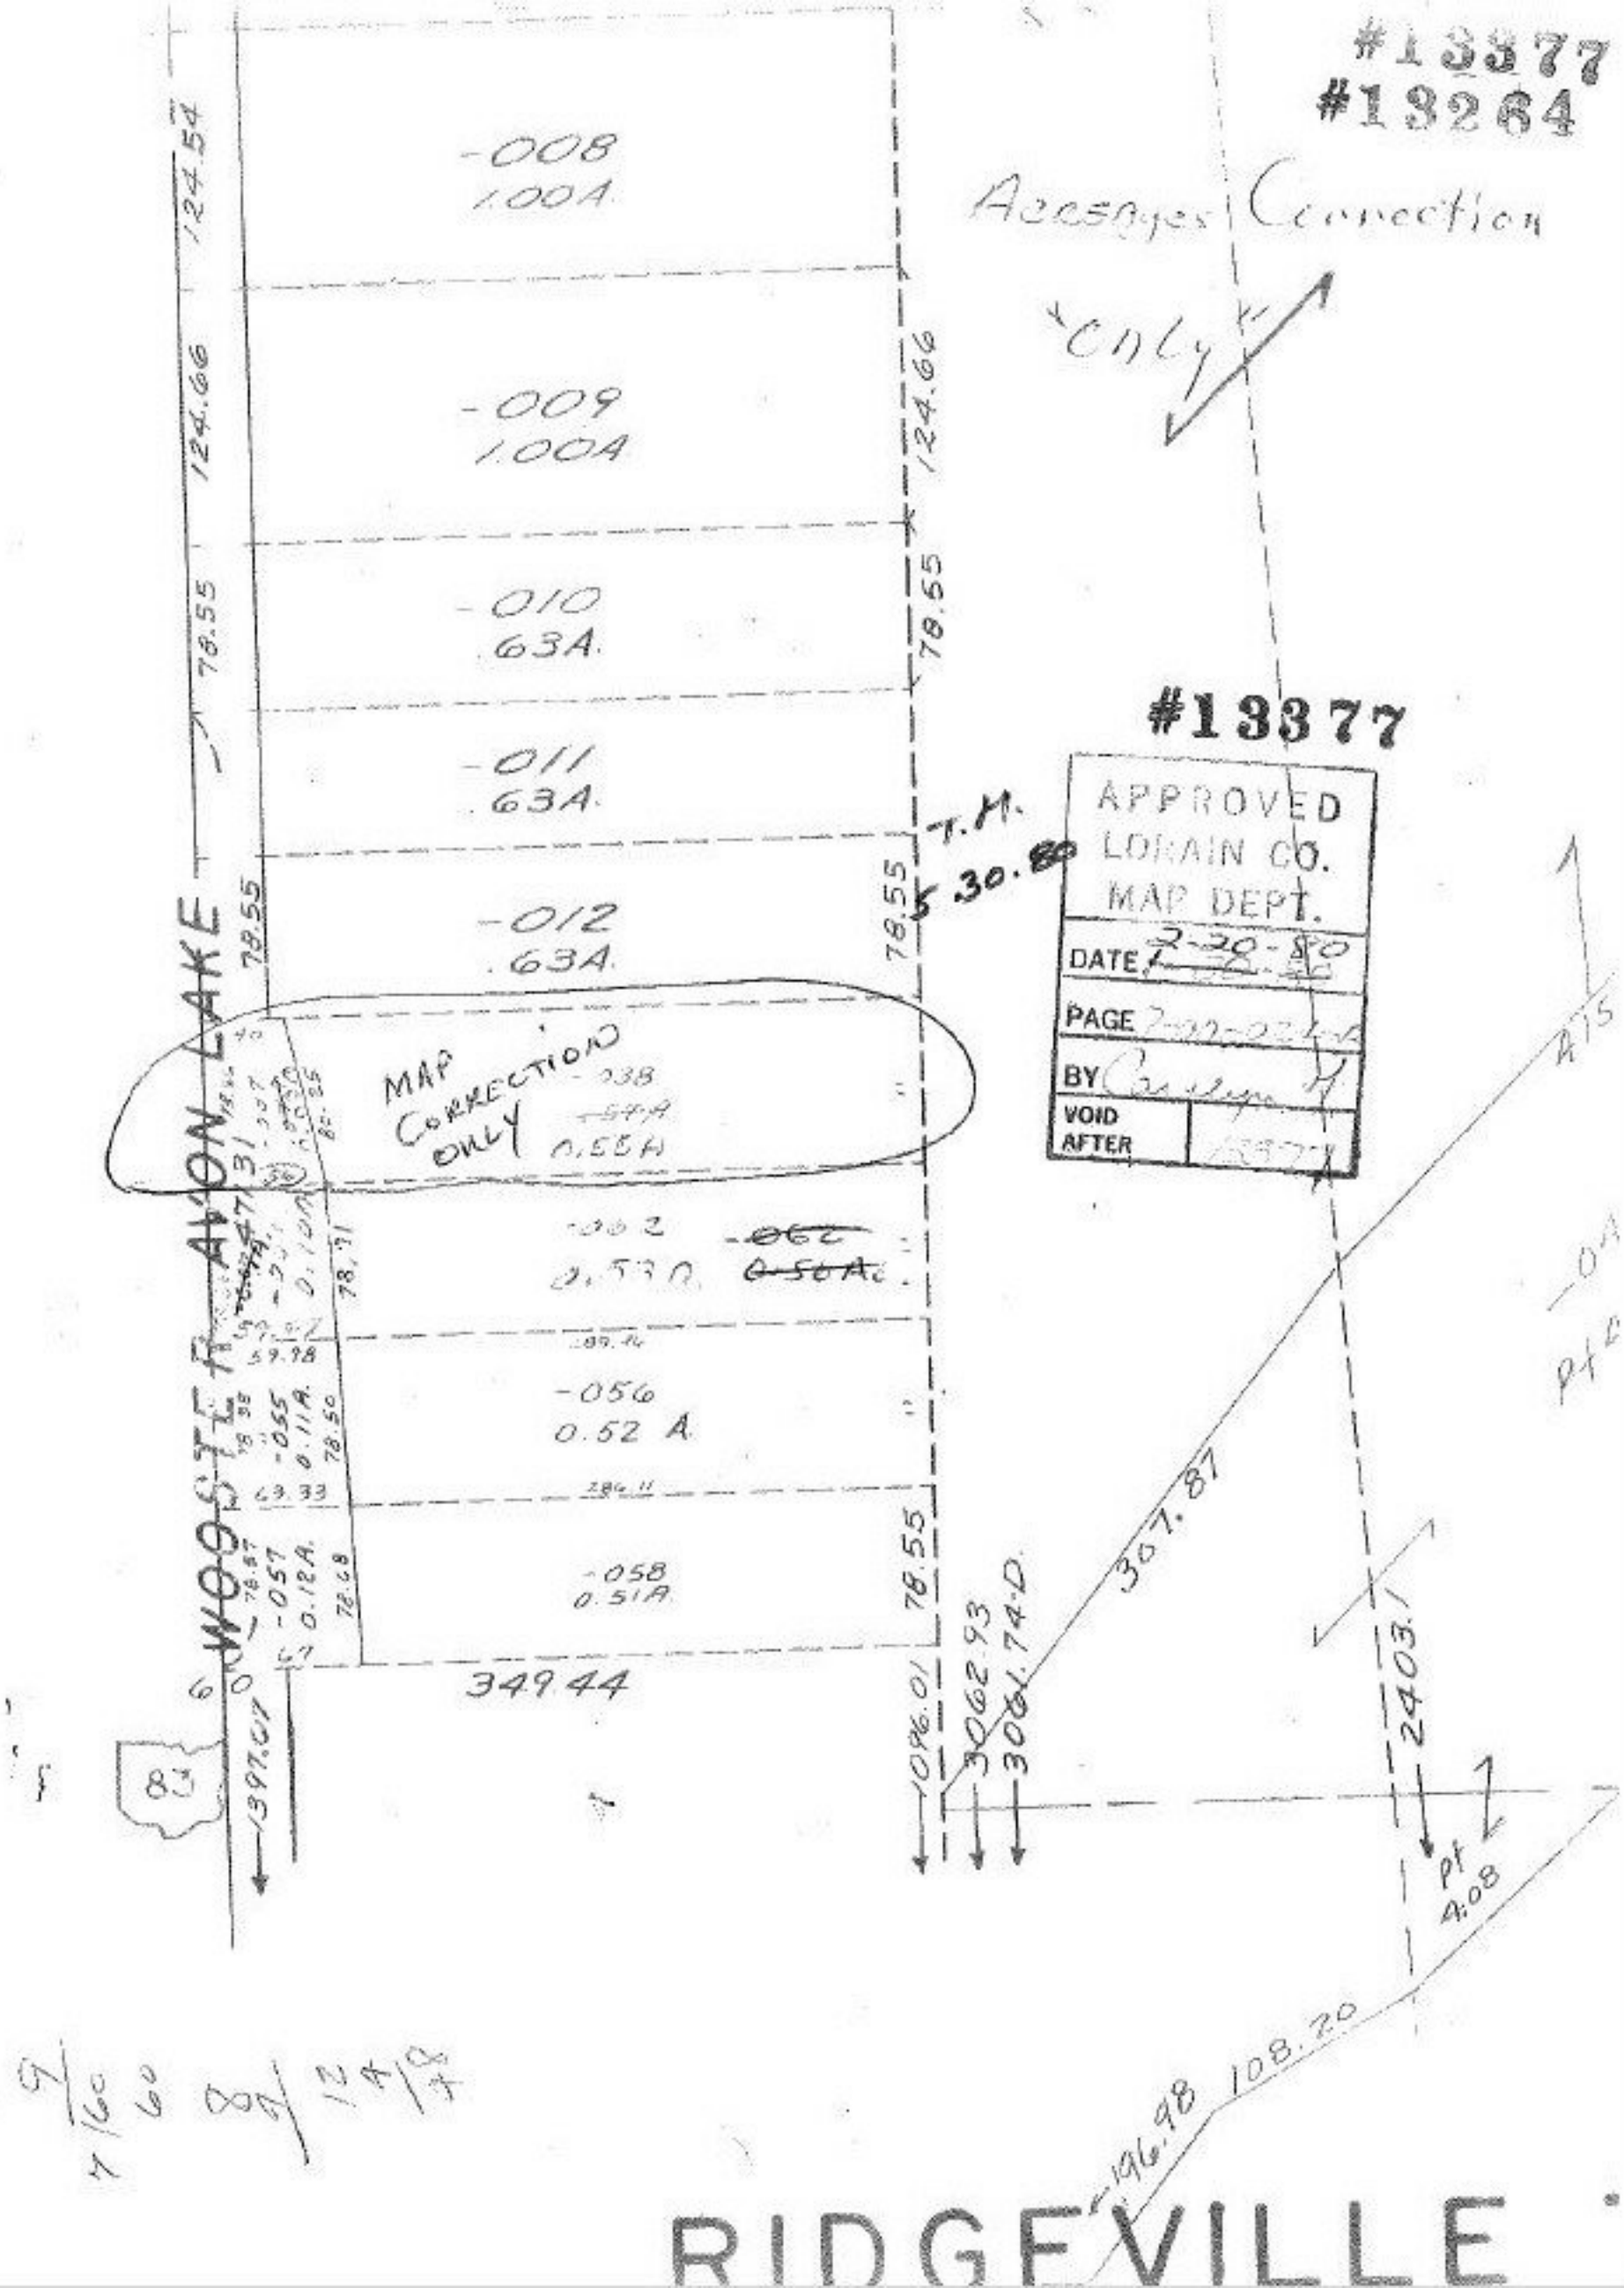
#13377
#13264
Acreages Correction
"Only"
-008
1.00A
-009
1.00A
-010
.63A
-011
.63A
-012
.63A
T.M.
5.30.80
#13377
APPROVED
LORAIN CO.
MAP DEPT.
DATE 2-20-80
PAGE
BY
VOID AFTER
MAP CORRECTION ONLY
-038
0.55A
-062
0.53A
-056
0.52 A
-058
0.51A
WOOSTER AVON LAKE
124.54
124.66
78.55
78.55
78.55
78.55
78.71
59.98
63.33
78.50
78.68
349.44
1397.07
1096.01
3062.93
3061.74-D
307.87
2403.1
pt 4.08
108.20
196.98
83
1964
RIDGEVILLE