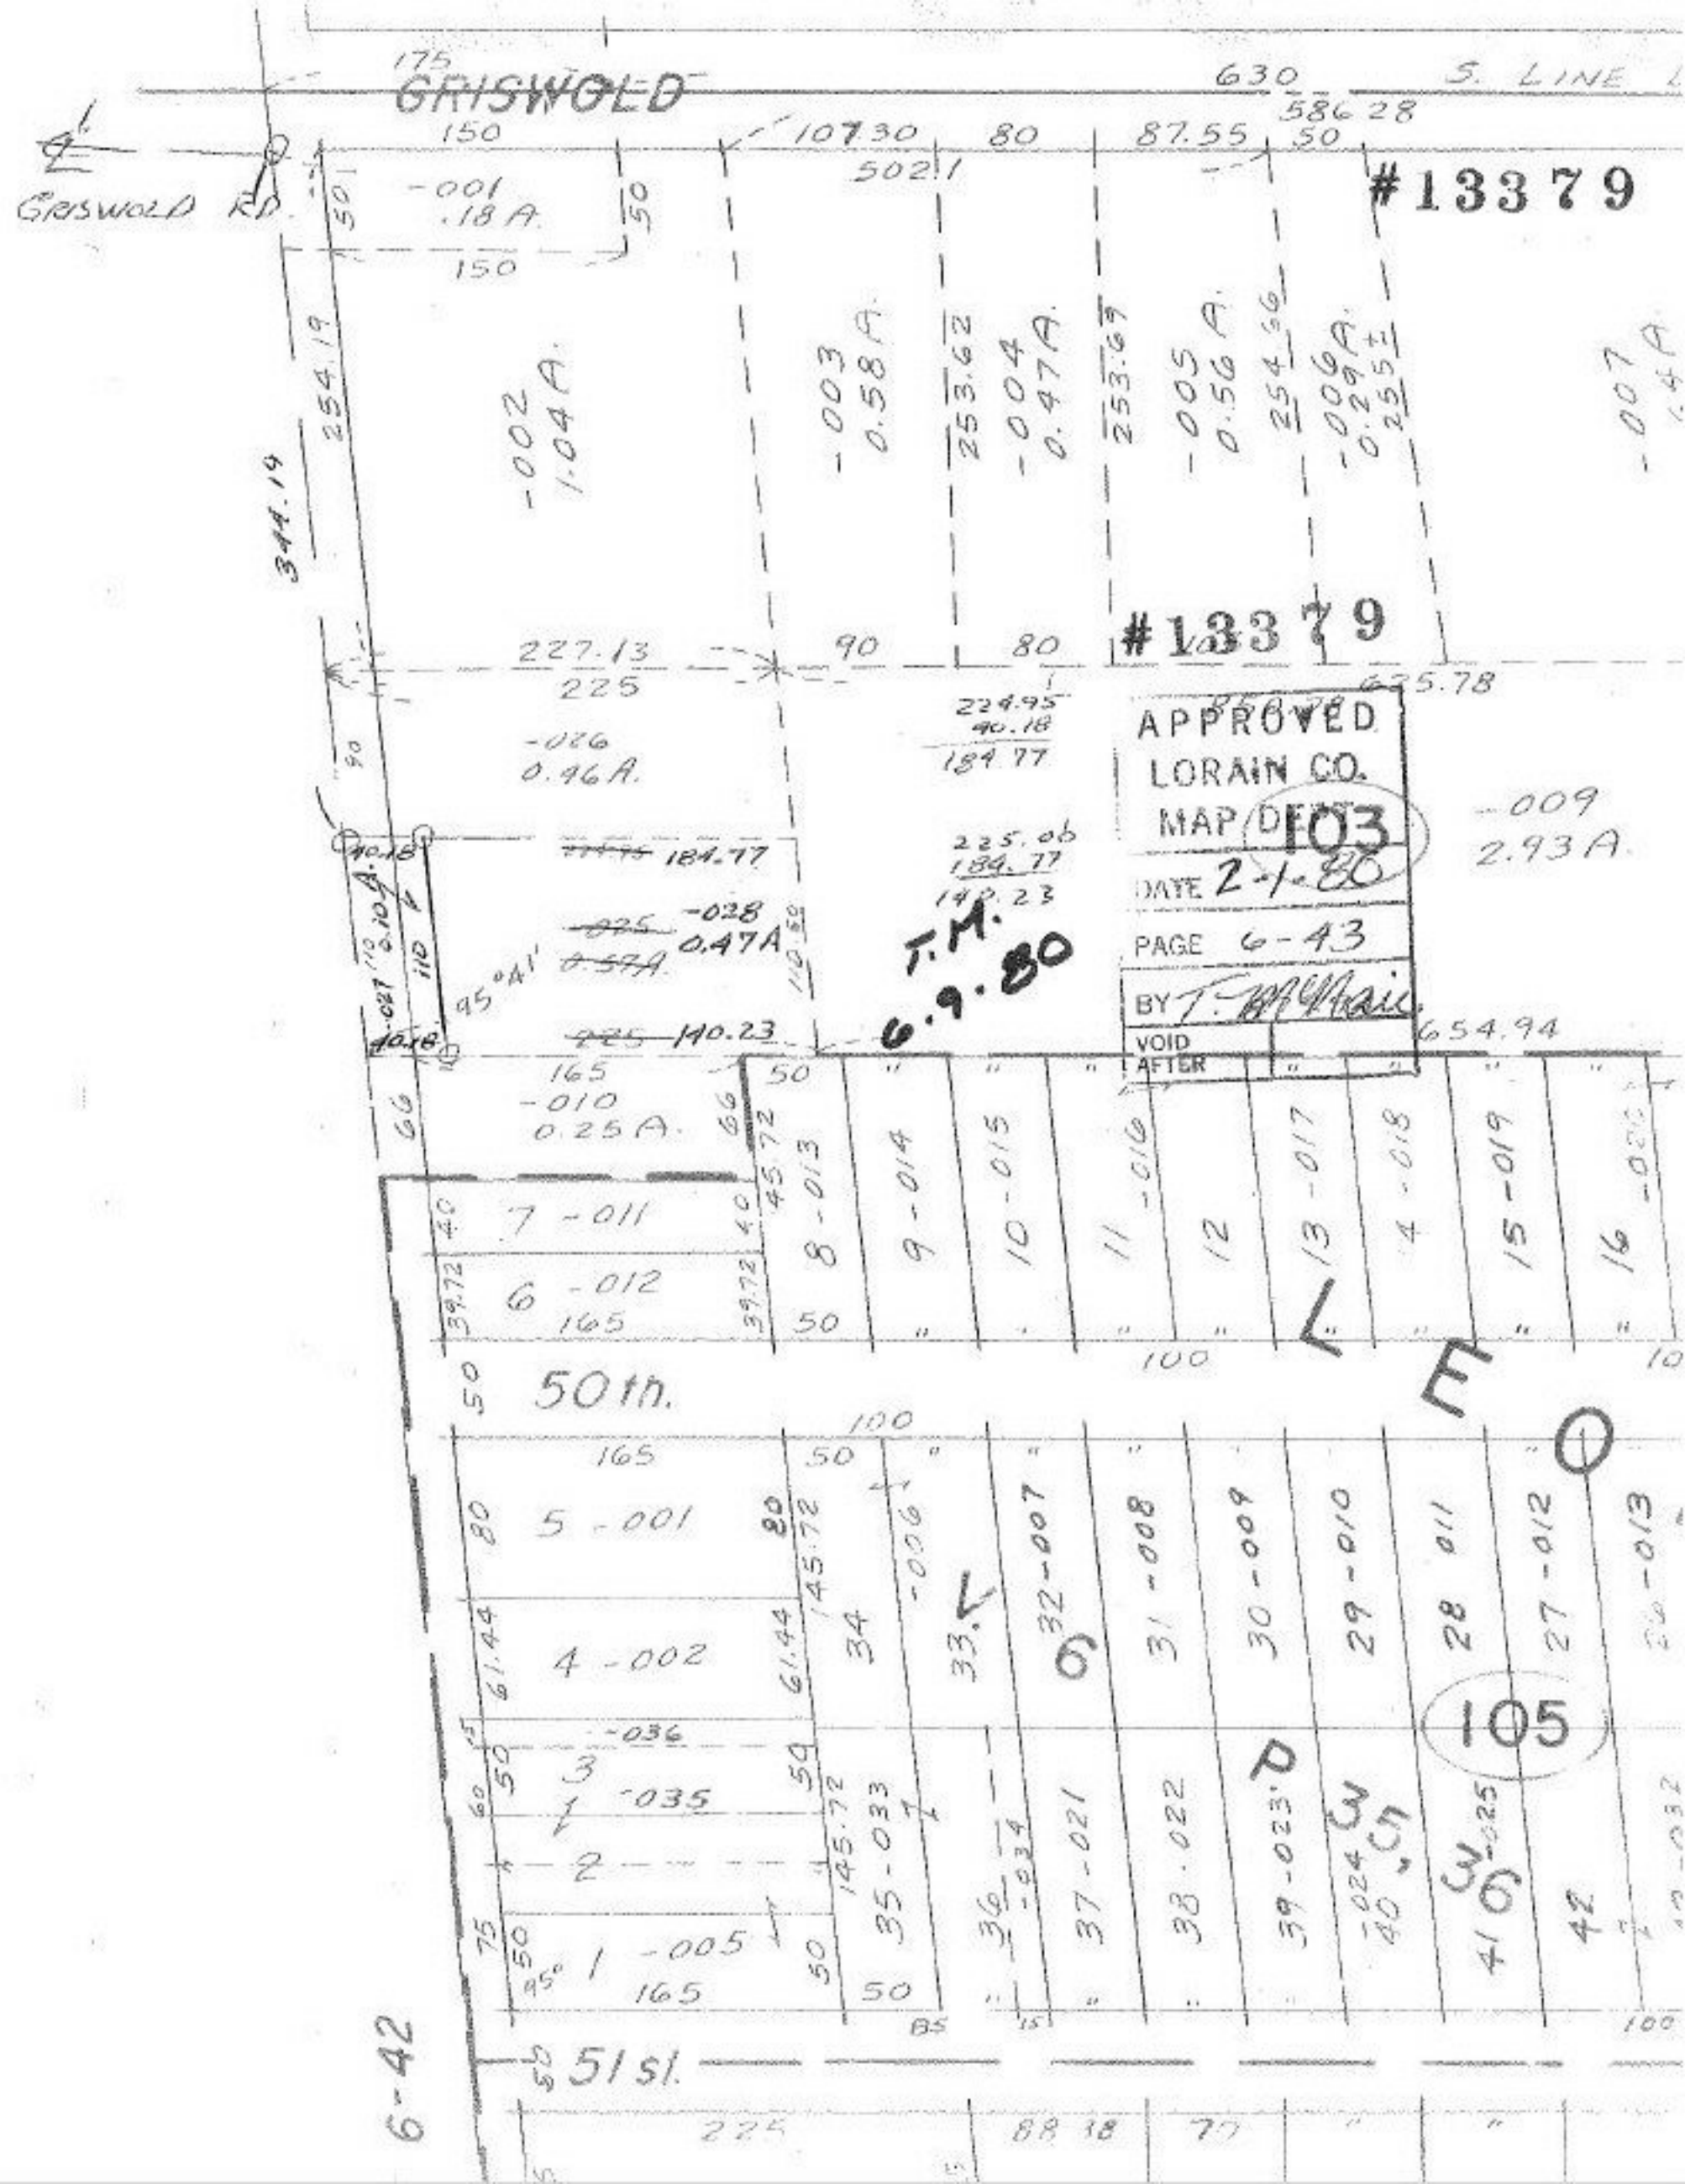
GRISWOLD
GRISWOLD RD.
S. LINE
#13379
#13379
APPROVED
LORAIN CO.
MAP DEPT.
103
DATE 2-1-80
PAGE 6-43
BY
VOID
AFTER
T.M.
6.9.80
50th.
51 st.
6-42
105