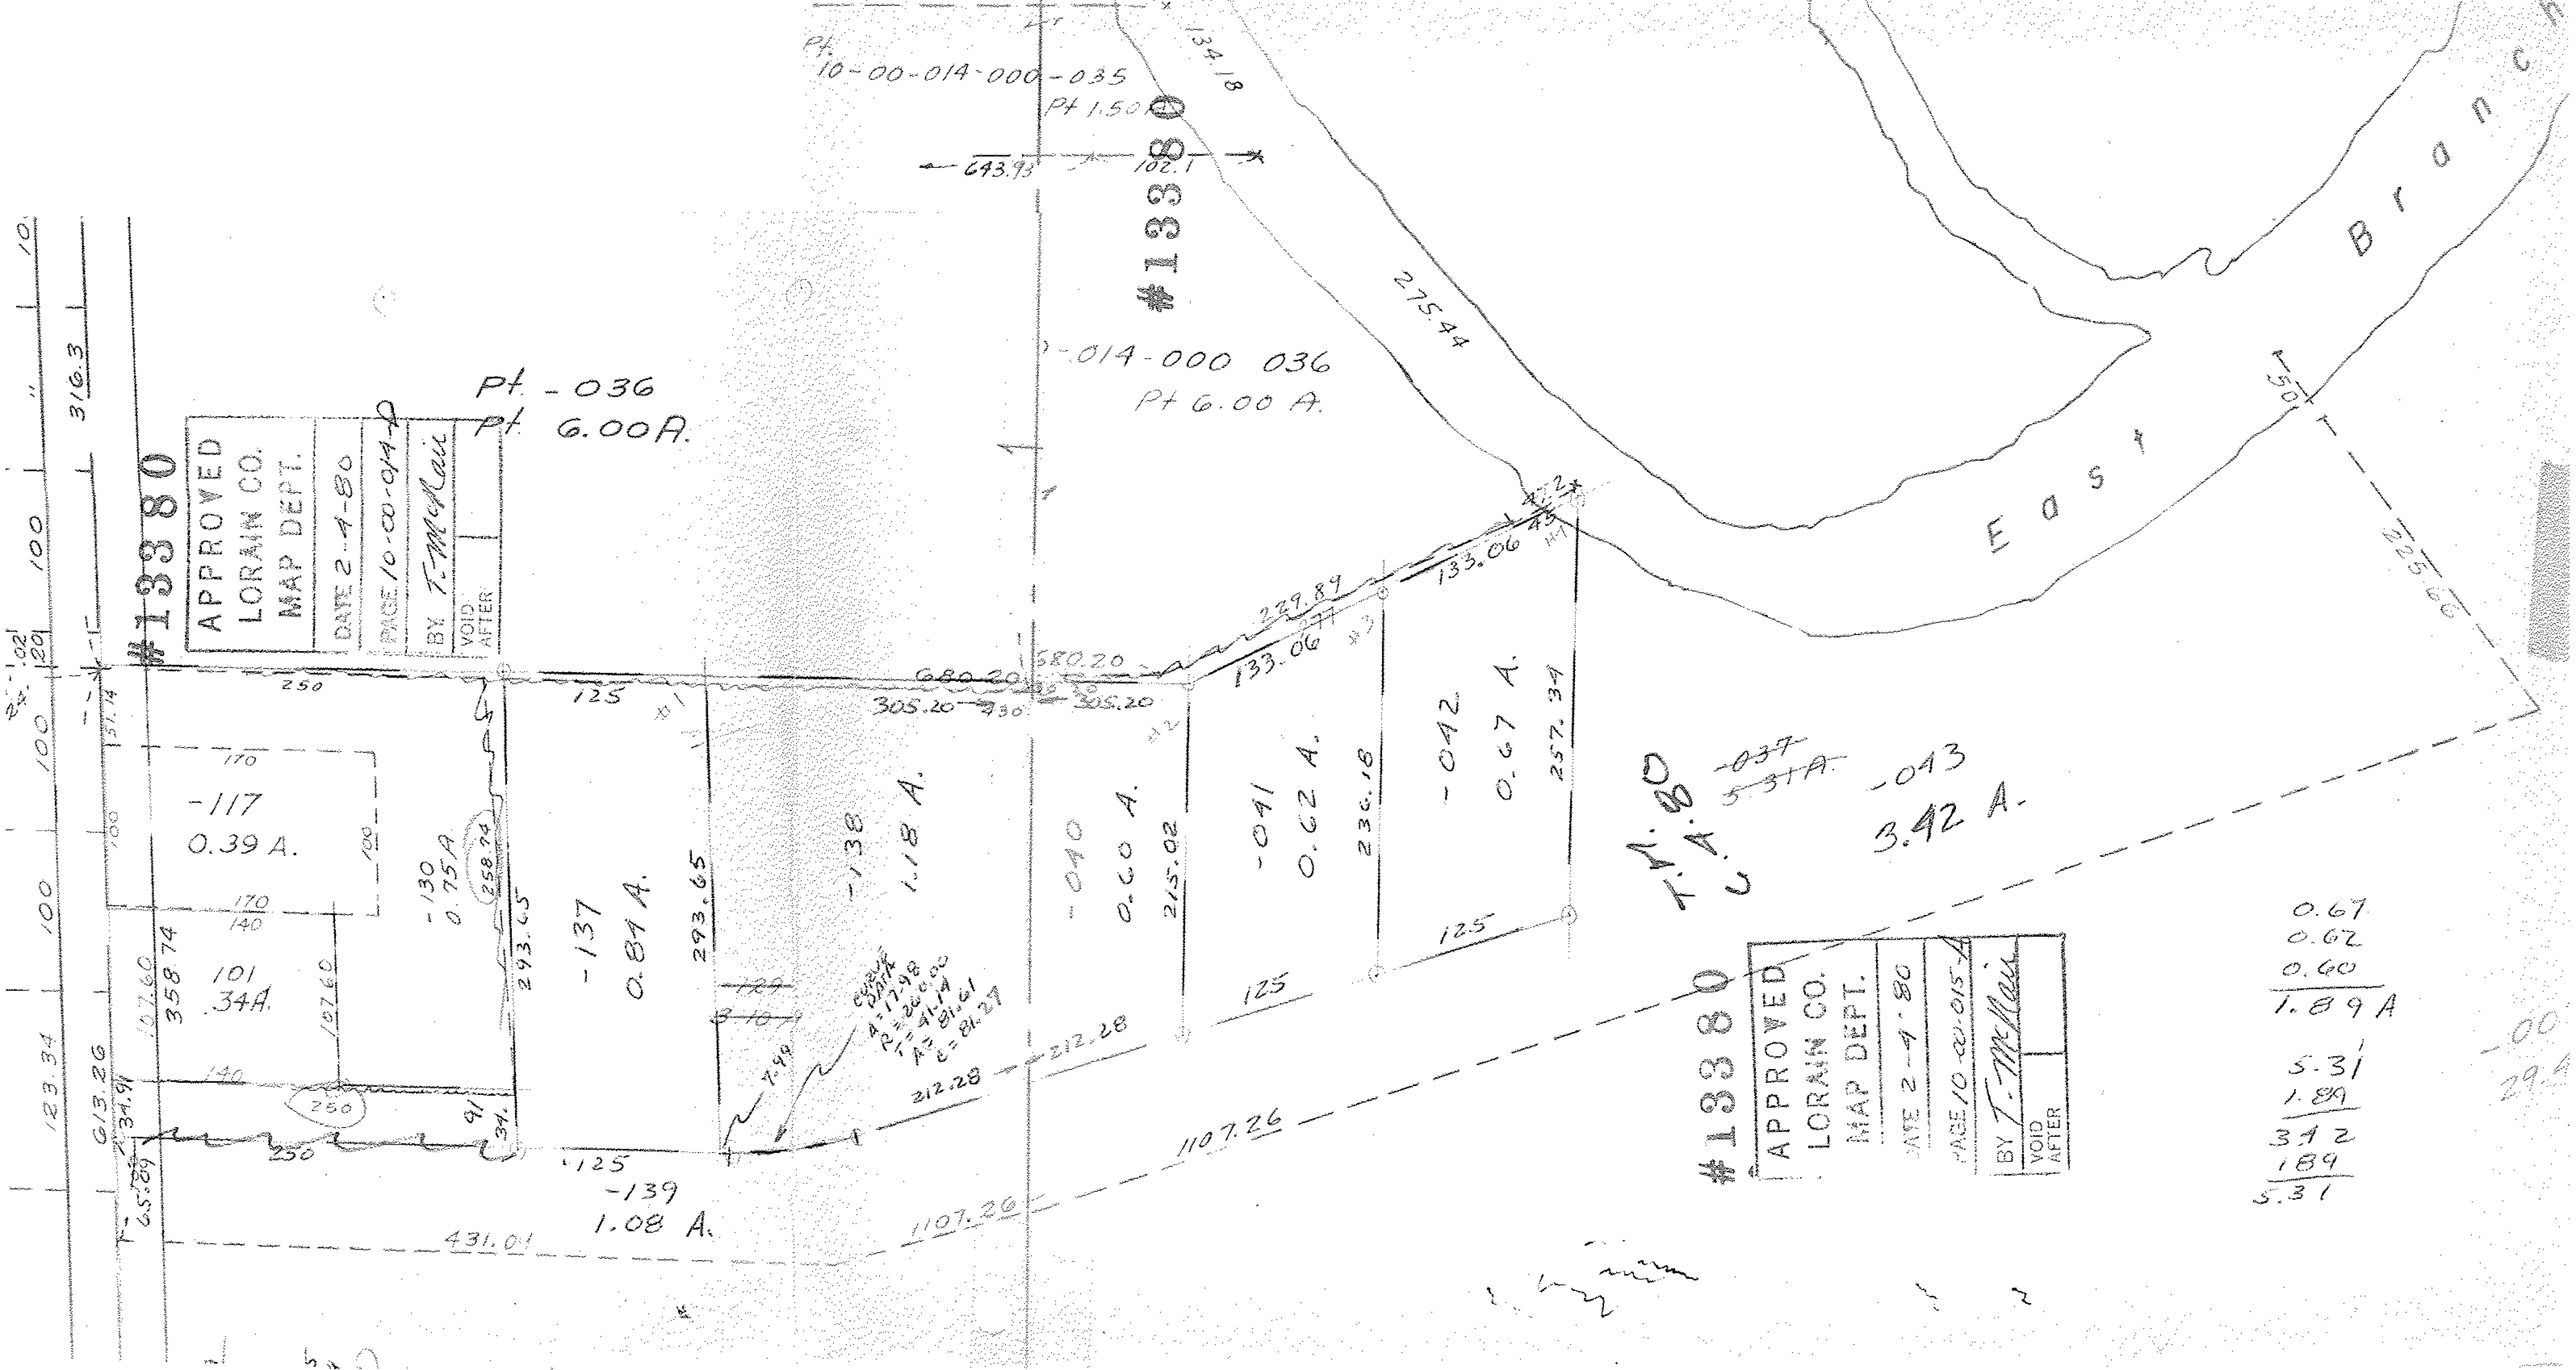
#13380
APPROVED
LORAIN CO.
MAP DEPT.
DATE 2-4-80
PAGE 10-00-014
BY T. McCall
VOID AFTER
Pt. - 036
Pt. 6.00A.
Pt. 10-00-014-000-035
Pt 1.50 A.
#13380
014-000 036
Pt 6.00 A.
East Branch
275.44
-117
0.39 A.
-130
0.75A
-137
0.84 A.
-138
1.18 A.
-139
1.08 A.
-040
0.00 A.
-041
0.62 A.
-042
0.67 A.
-013
3.42 A.
101
.34A.
T.A. 1.80
-037
5.31A
#13380
APPROVED
LORAIN CO.
MAP DEPT.
DATE 2-4-80
PAGE 10-00-015
BY T. McCall
VOID AFTER
0.67
0.62
0.60
1.89 A
5.31
1.89
3.42
1.89
5.31
680.20
580.20
305.20
930
239.89
133.06
135.06
1107.26
431.01
212.28
293.65
215.02
236.18
257.34
293.45
258.74
358.74
107.60
123.34
613.26
316.3
CURVE DATA
Δ=17°48'
R=260.00
T=91.14
A=161.61
L=161.27
7.98