#13386

#13386

APPROVED
LORAIN CO.
MAP DEPT.
DATE 2.20.80
PAGE 7.00.017-B
BY T. McNair
VOID
AFTER
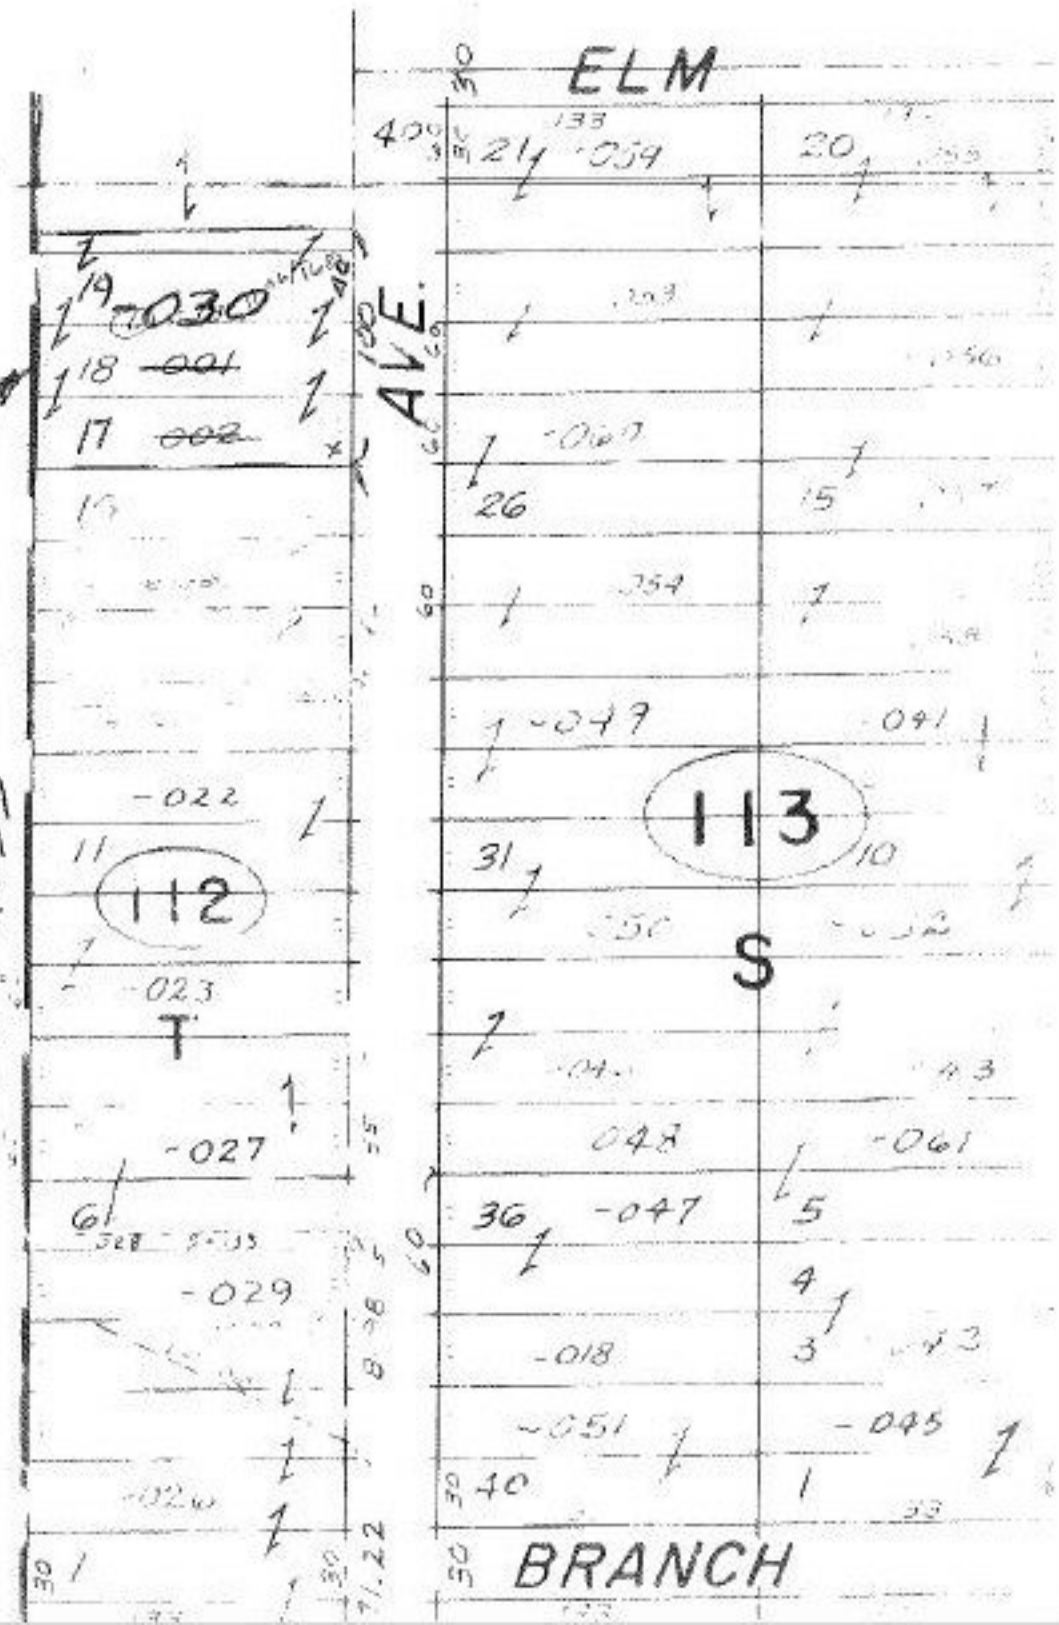
T.M.
5.29.80