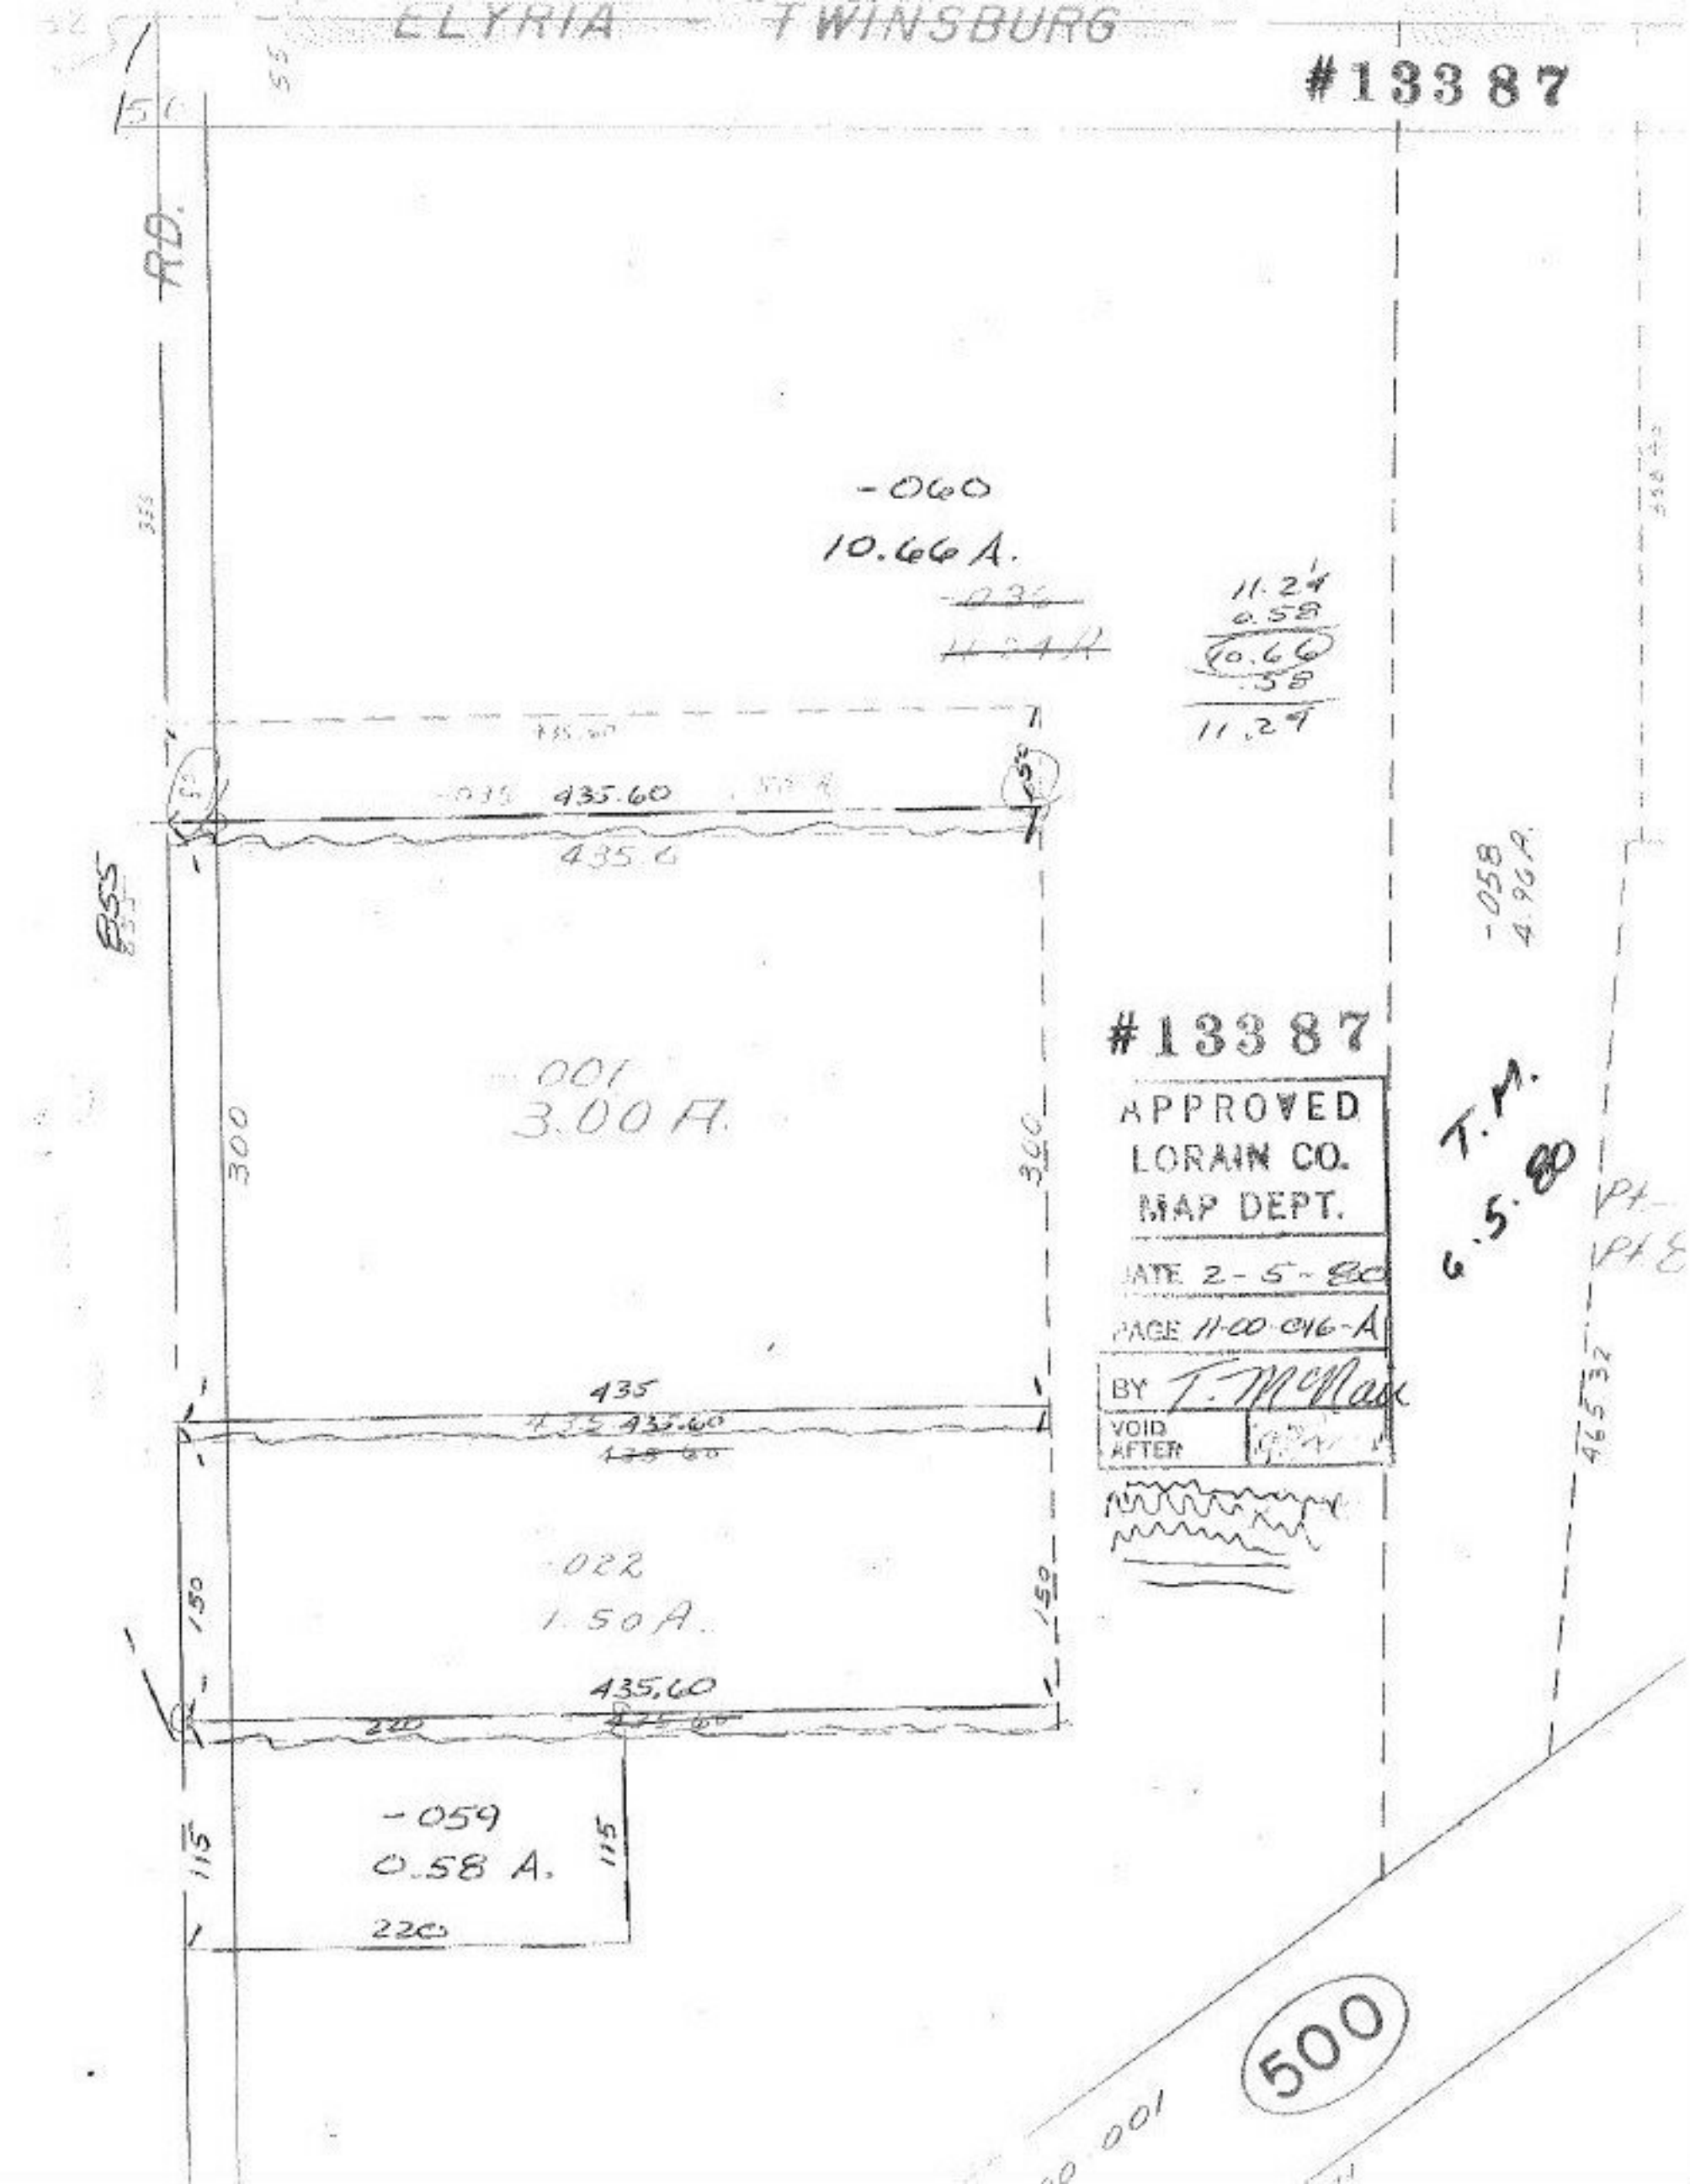
ELYRIA - TWINSBURG
#13387
RD.
-060
10.66 A.
11.24
0.58
10.66
.58
11.24
435.60
435.6
-058
4.96 A.
#13387
APPROVED
LORAIN CO.
MAP DEPT.
DATE 2-5-80
PAGE 11-00-016-A
BY T. McNair
VOID AFTER
T.M.
6.5.80
.001
3.00 A.
300
300
435
435.60
.022
1.50 A.
150
150
435.60
220
-059
0.58 A.
115
115
220
500
.001