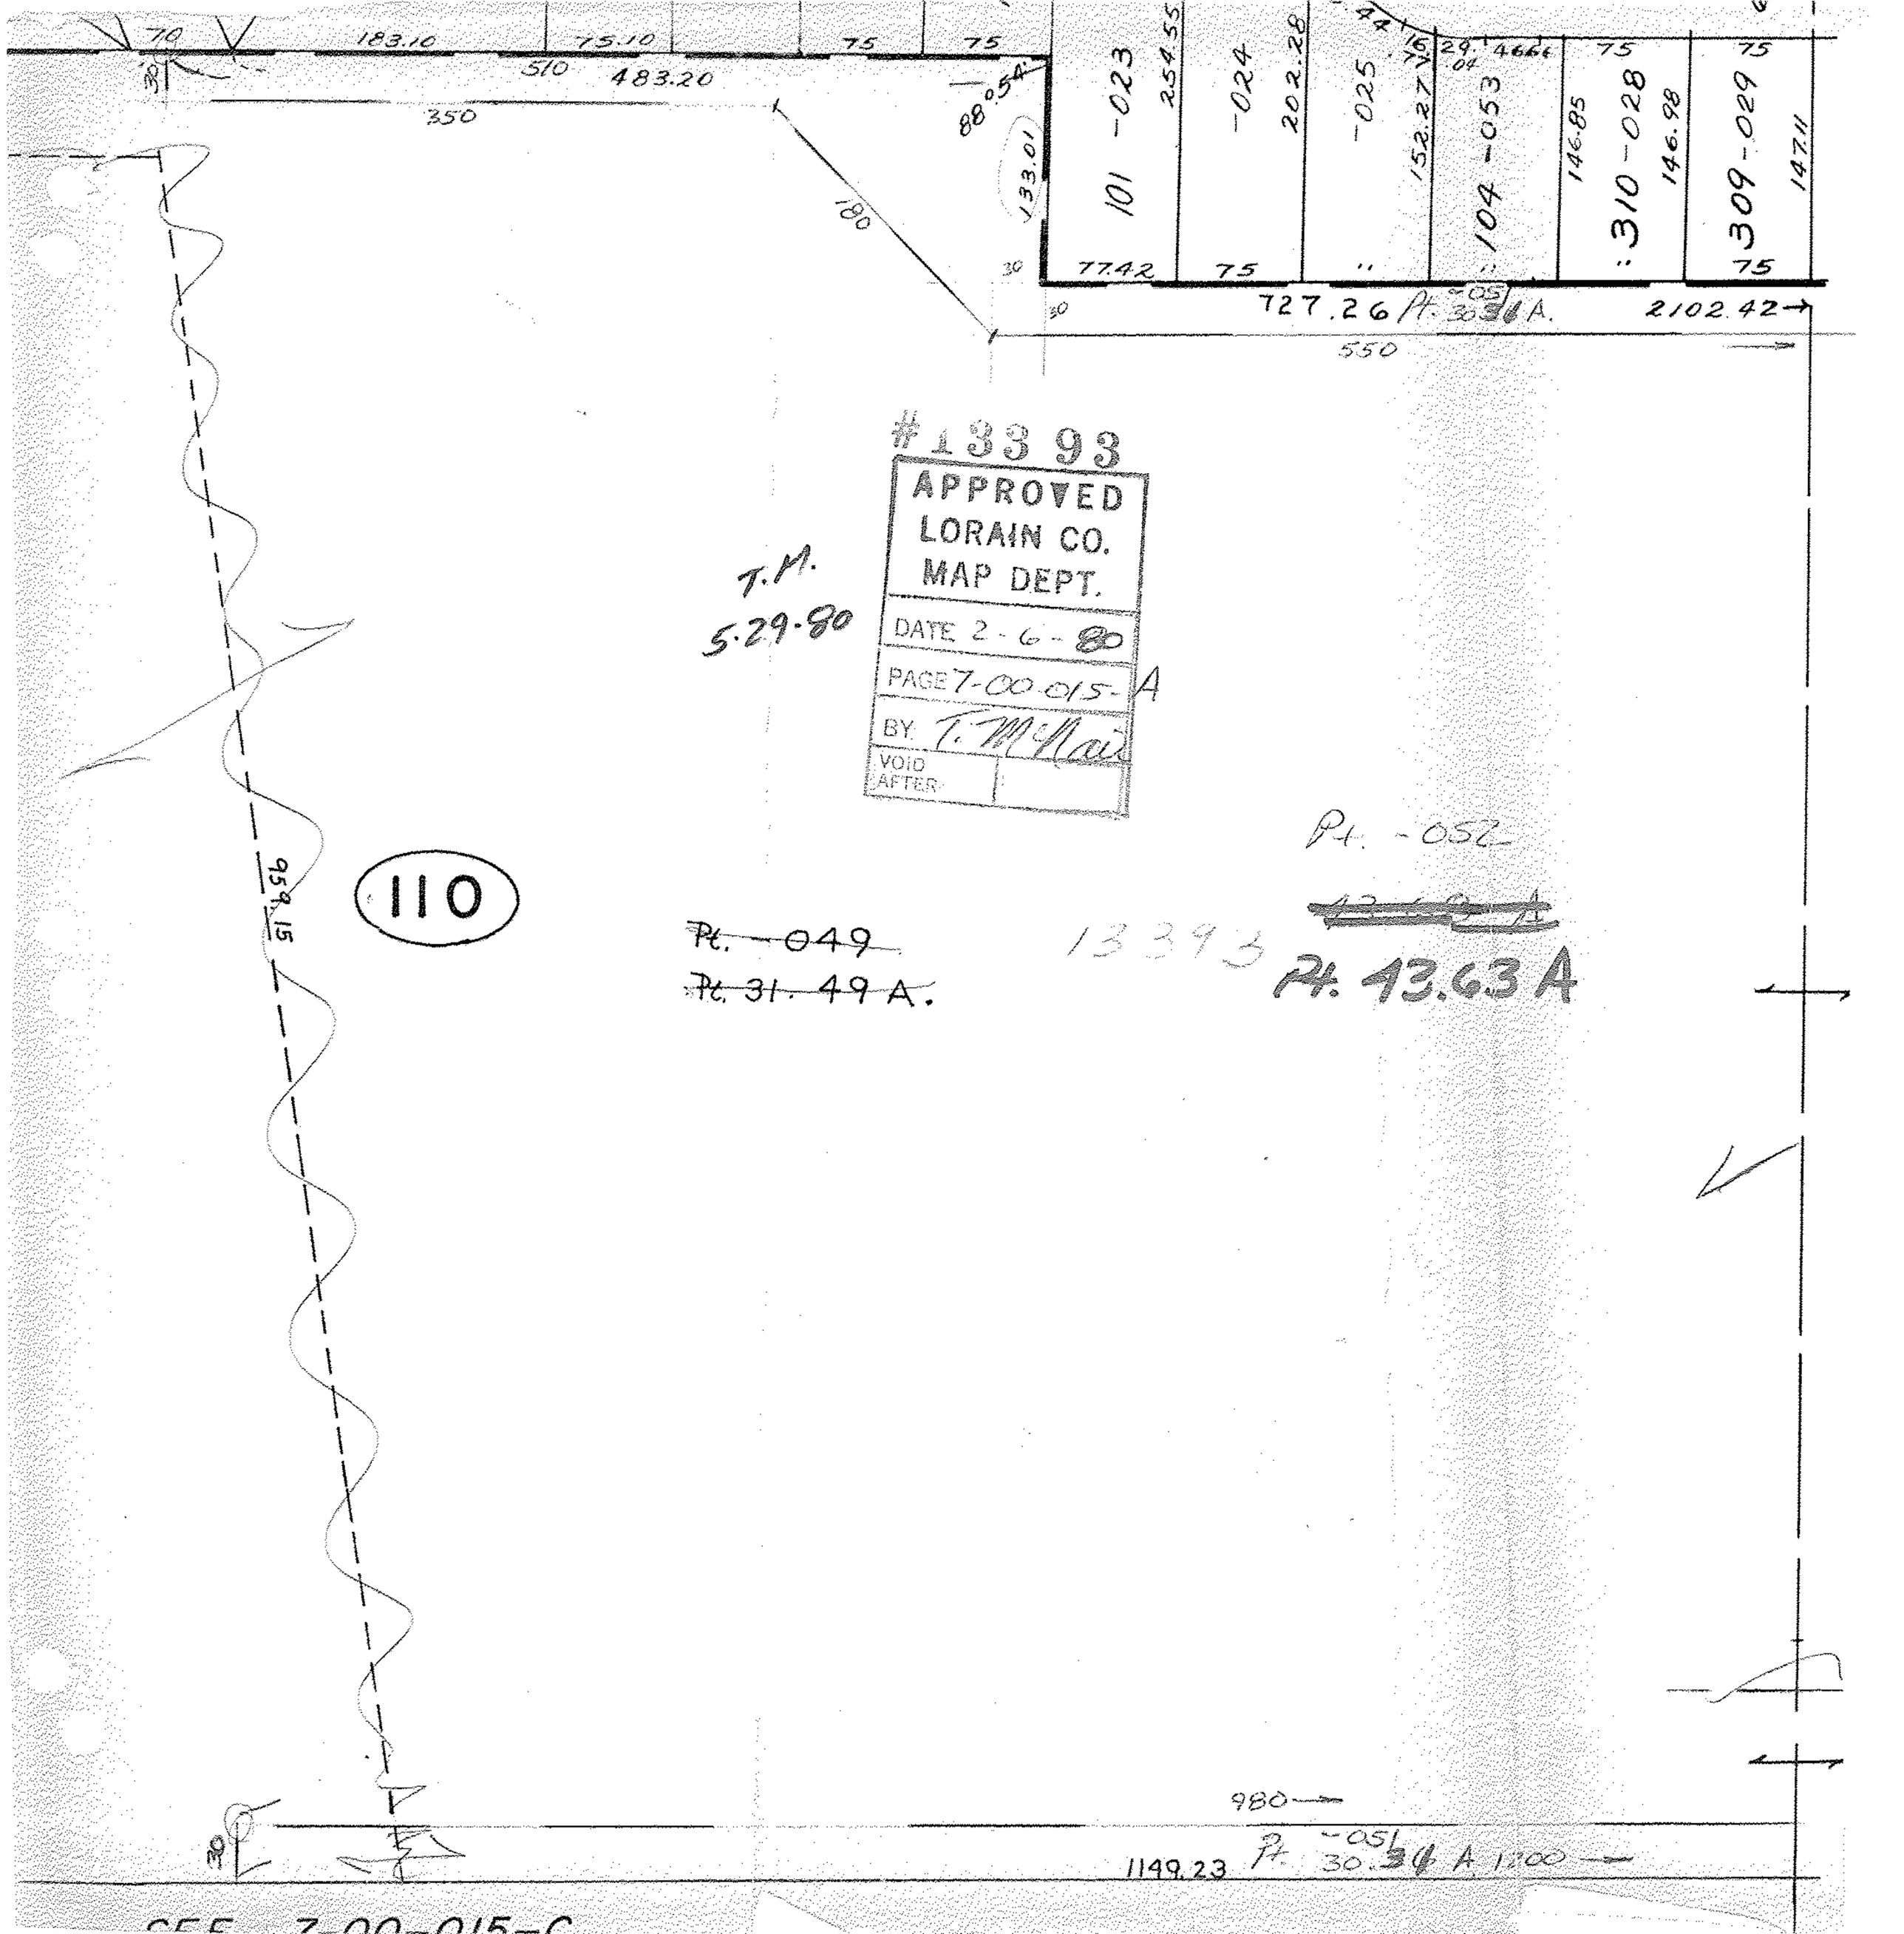

70
183.10
75.10
75
75
510
483.20
350
88°54'
133.01
180
101 -023
254.55
-024
202.28
-025
152.27
104 -053
146.85
310 -028
146.98
309 -029
147.11
77.42
75
75
727.26 Pt. 30.36 A.
2102.42
550
#13393
APPROVED
LORAIN CO.
MAP DEPT.
DATE 2-6-80
PAGE 7-00-015-A
BY T. McNair
VOID AFTER
T.M.
5-29-80
Pt. -052
110
959.15
Pt. -049
Pt. 31.49 A.
13393
Pt. 43.63 A
980
1149.23
Pt. -051
30.36 A 1200

SEE 7-00-015-C