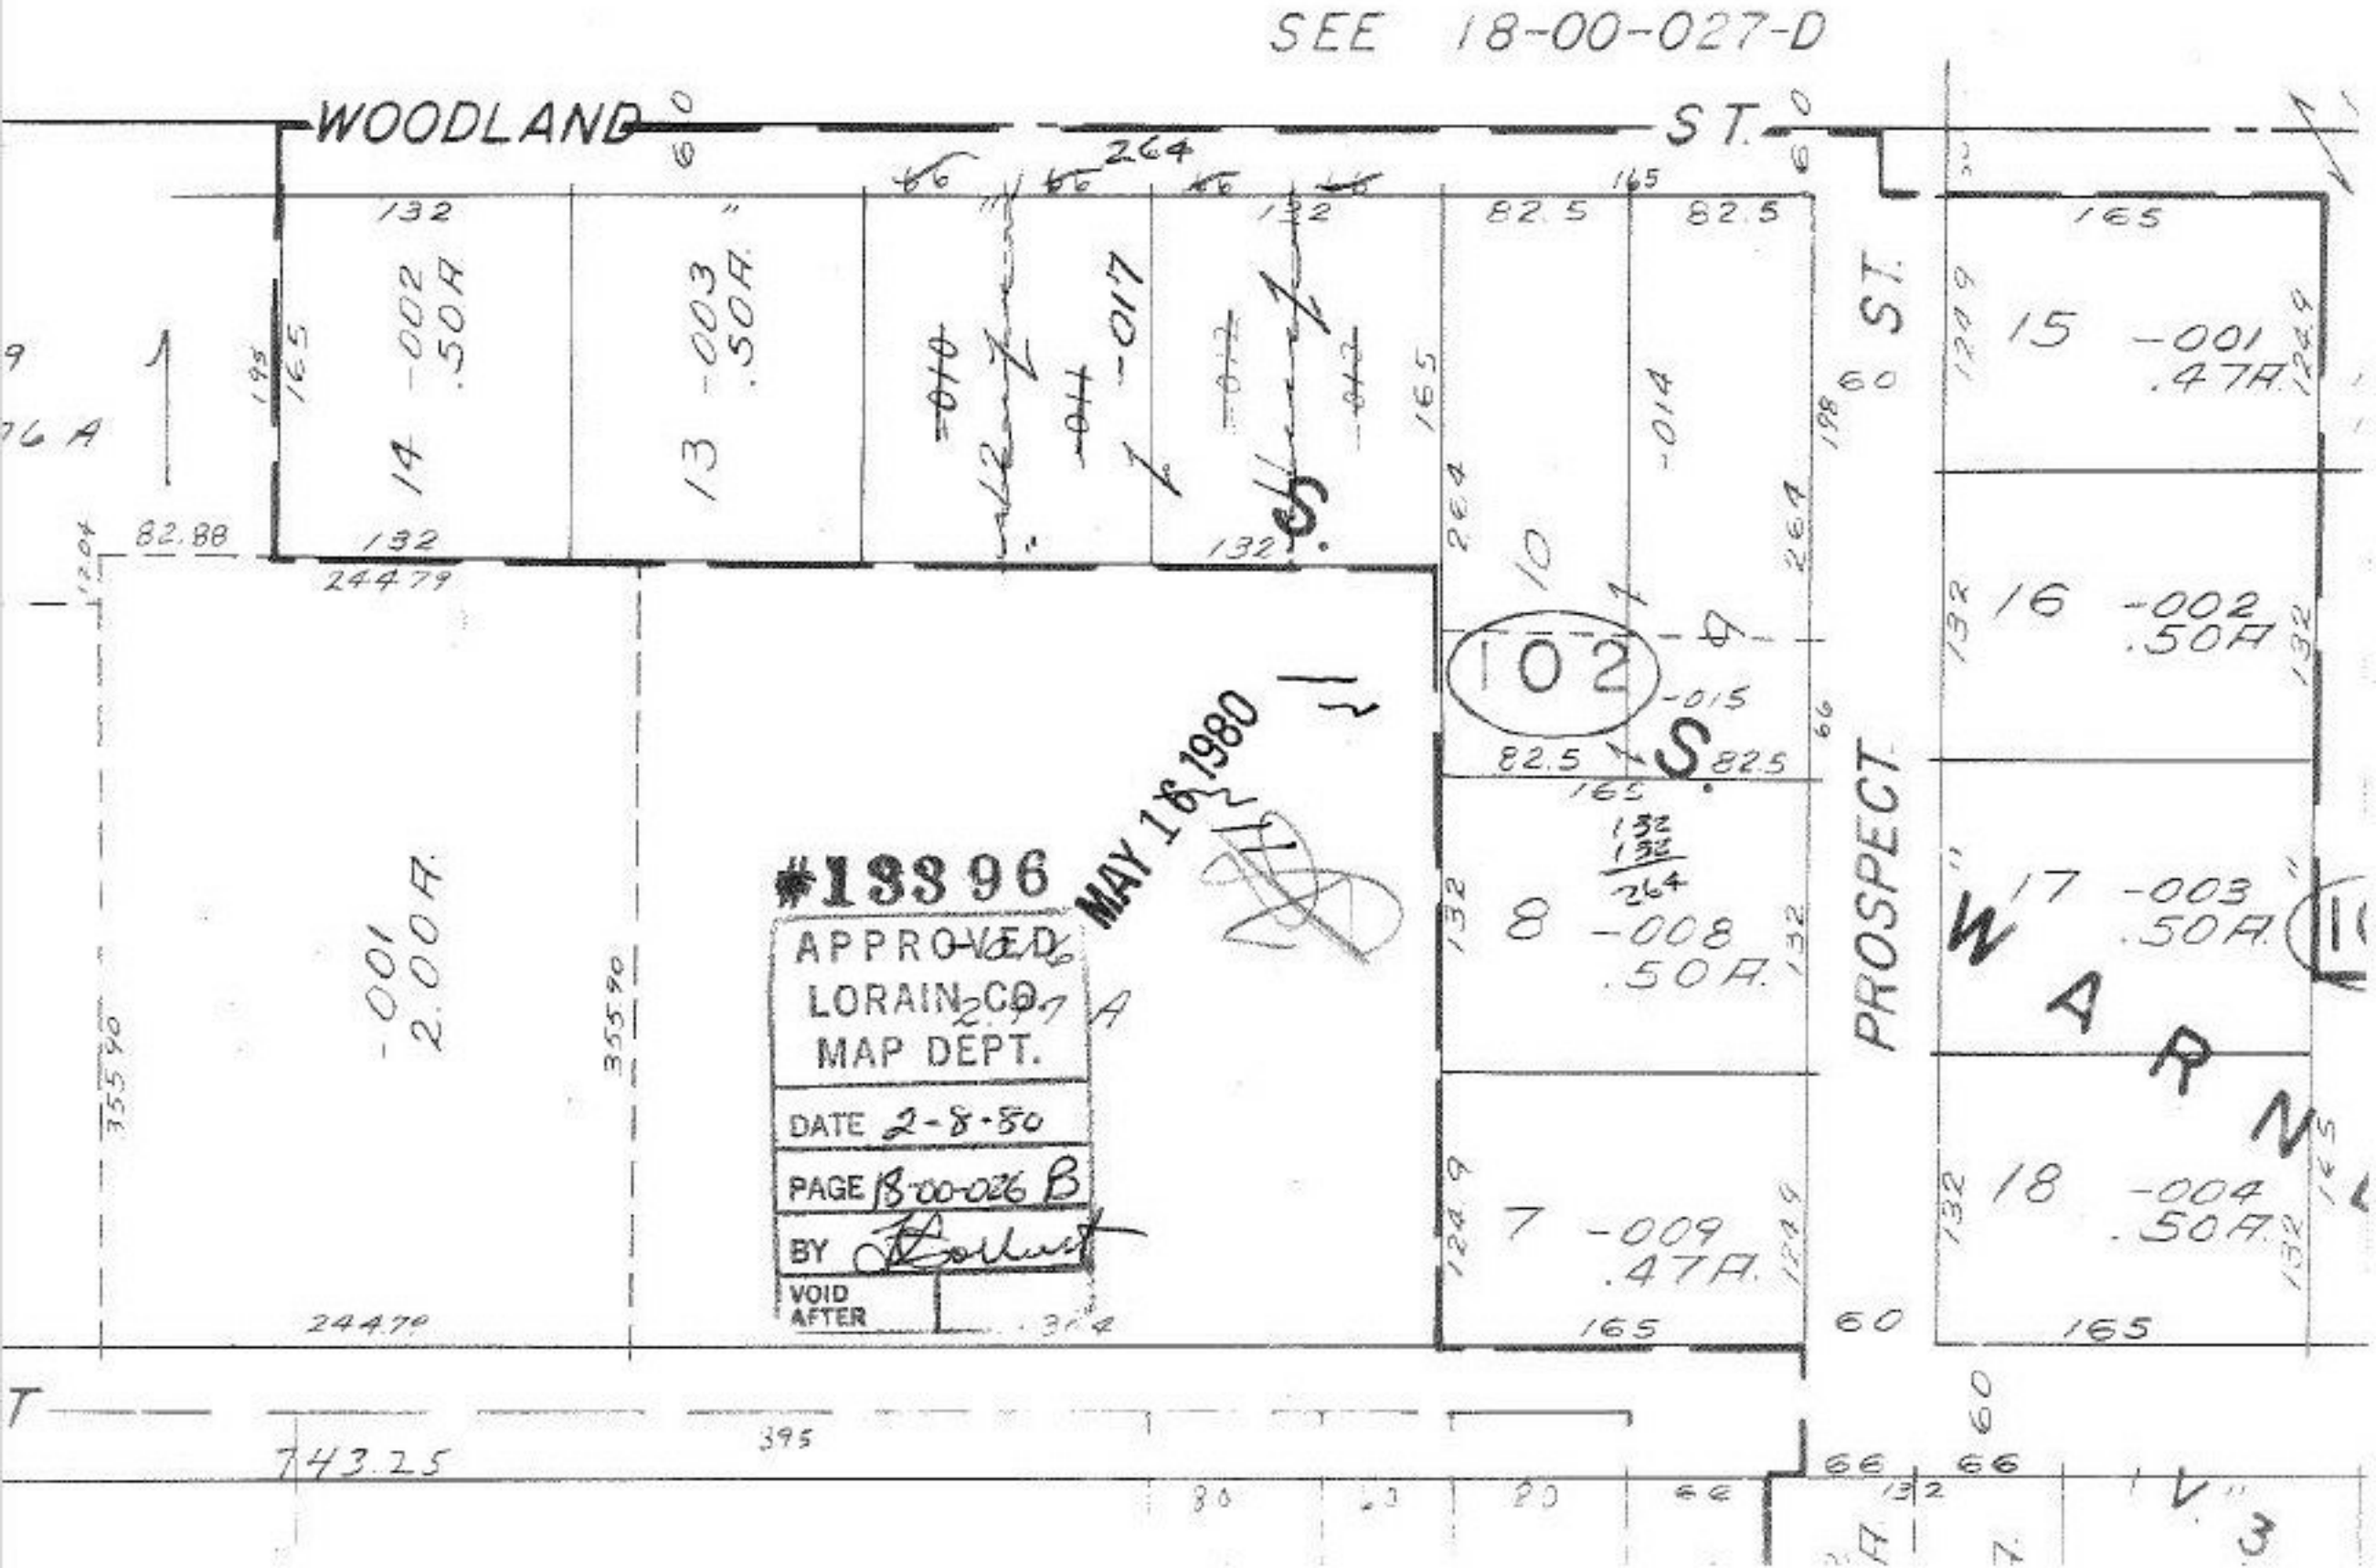
SEE 18-00-027-D
WOODLAND ST.
PROSPECT ST.
WARN
102
14 -002 .50A
13 -003 .50A
-010
-011
-017
-012
-013
-014
-015
10
9
8 -008 .50A
7 -009 .47A
15 -001 .47A
16 -002 .50A
17 -003 .50A
18 -004 .50A
-001 2.00A
#13396
MAY 16 1980
APPROVED
LORAIN CO.
MAP DEPT.
DATE 2-8-80
PAGE 18-00-026 B
BY
VOID AFTER
24479
355.90
743.25
395
82.88
132
165
264
82.5
60
66
124.9
198
195
1204