#13406

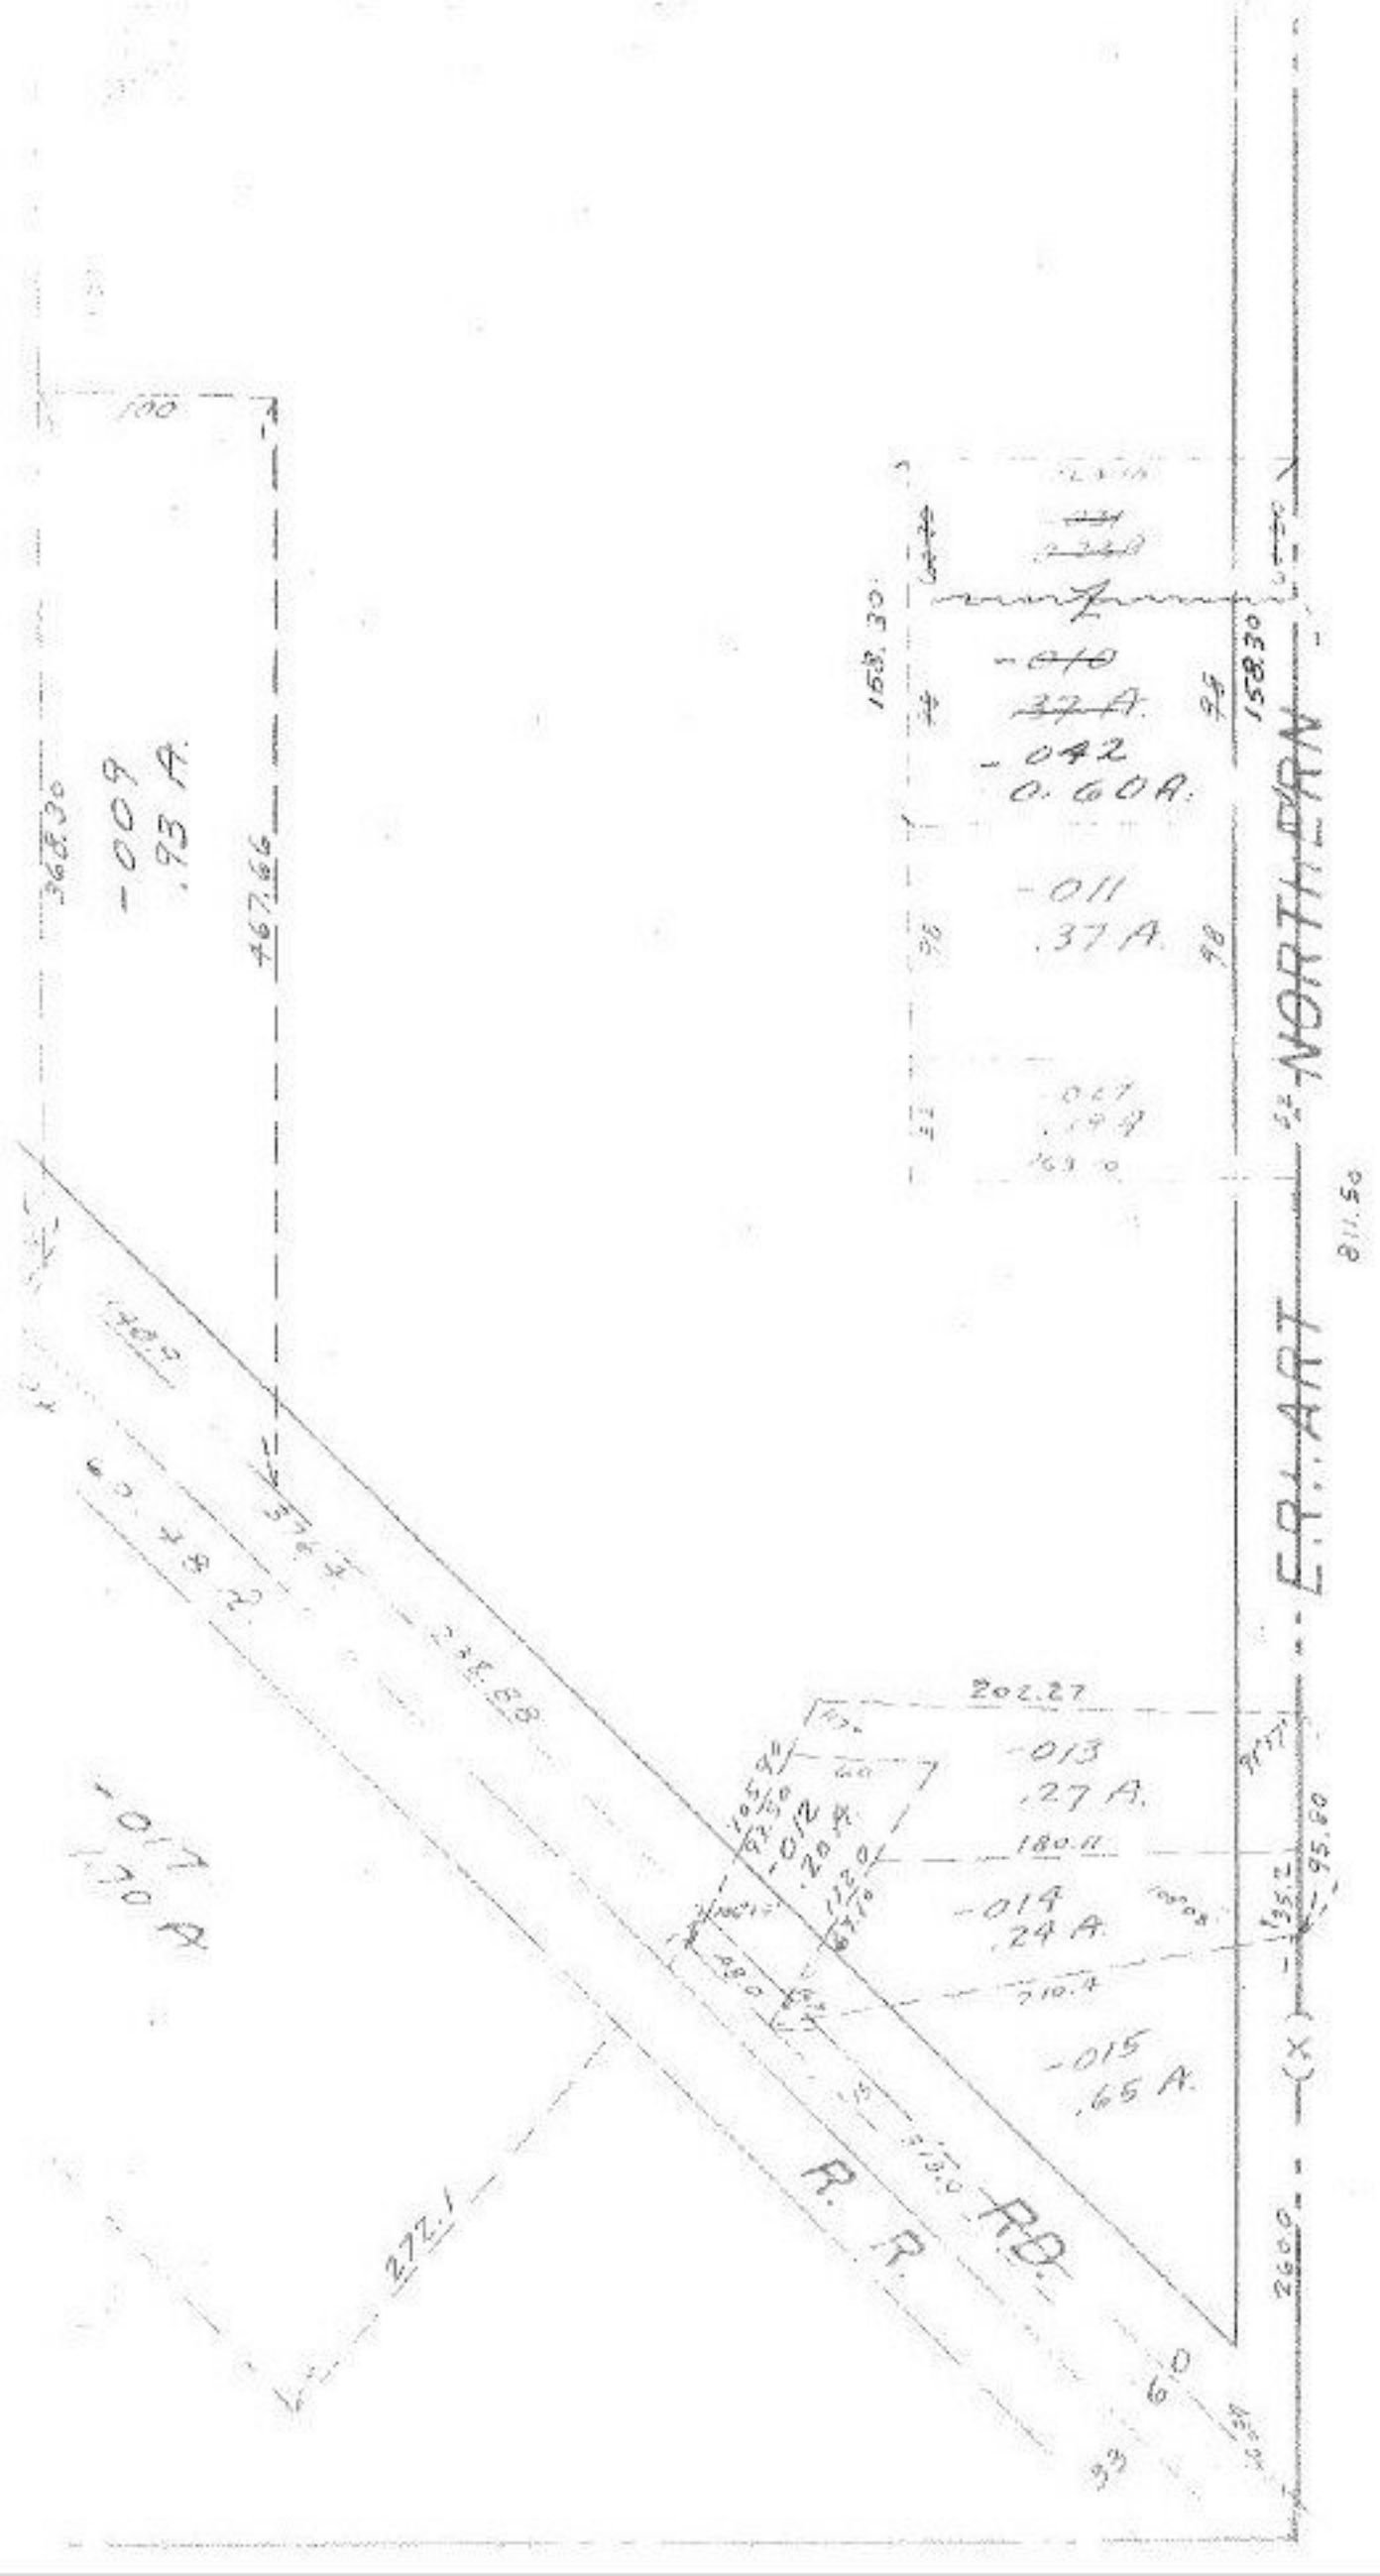

0.23
0.37
0.60 A

T.M.
6.3.80

#13406

APPROVED
LORAIN CO.
MAP DEPT.
DATE 2-13-80
PAGE 16-00-091-B
BY Carolyn B. [illegible]
TOD
ATTN 13406