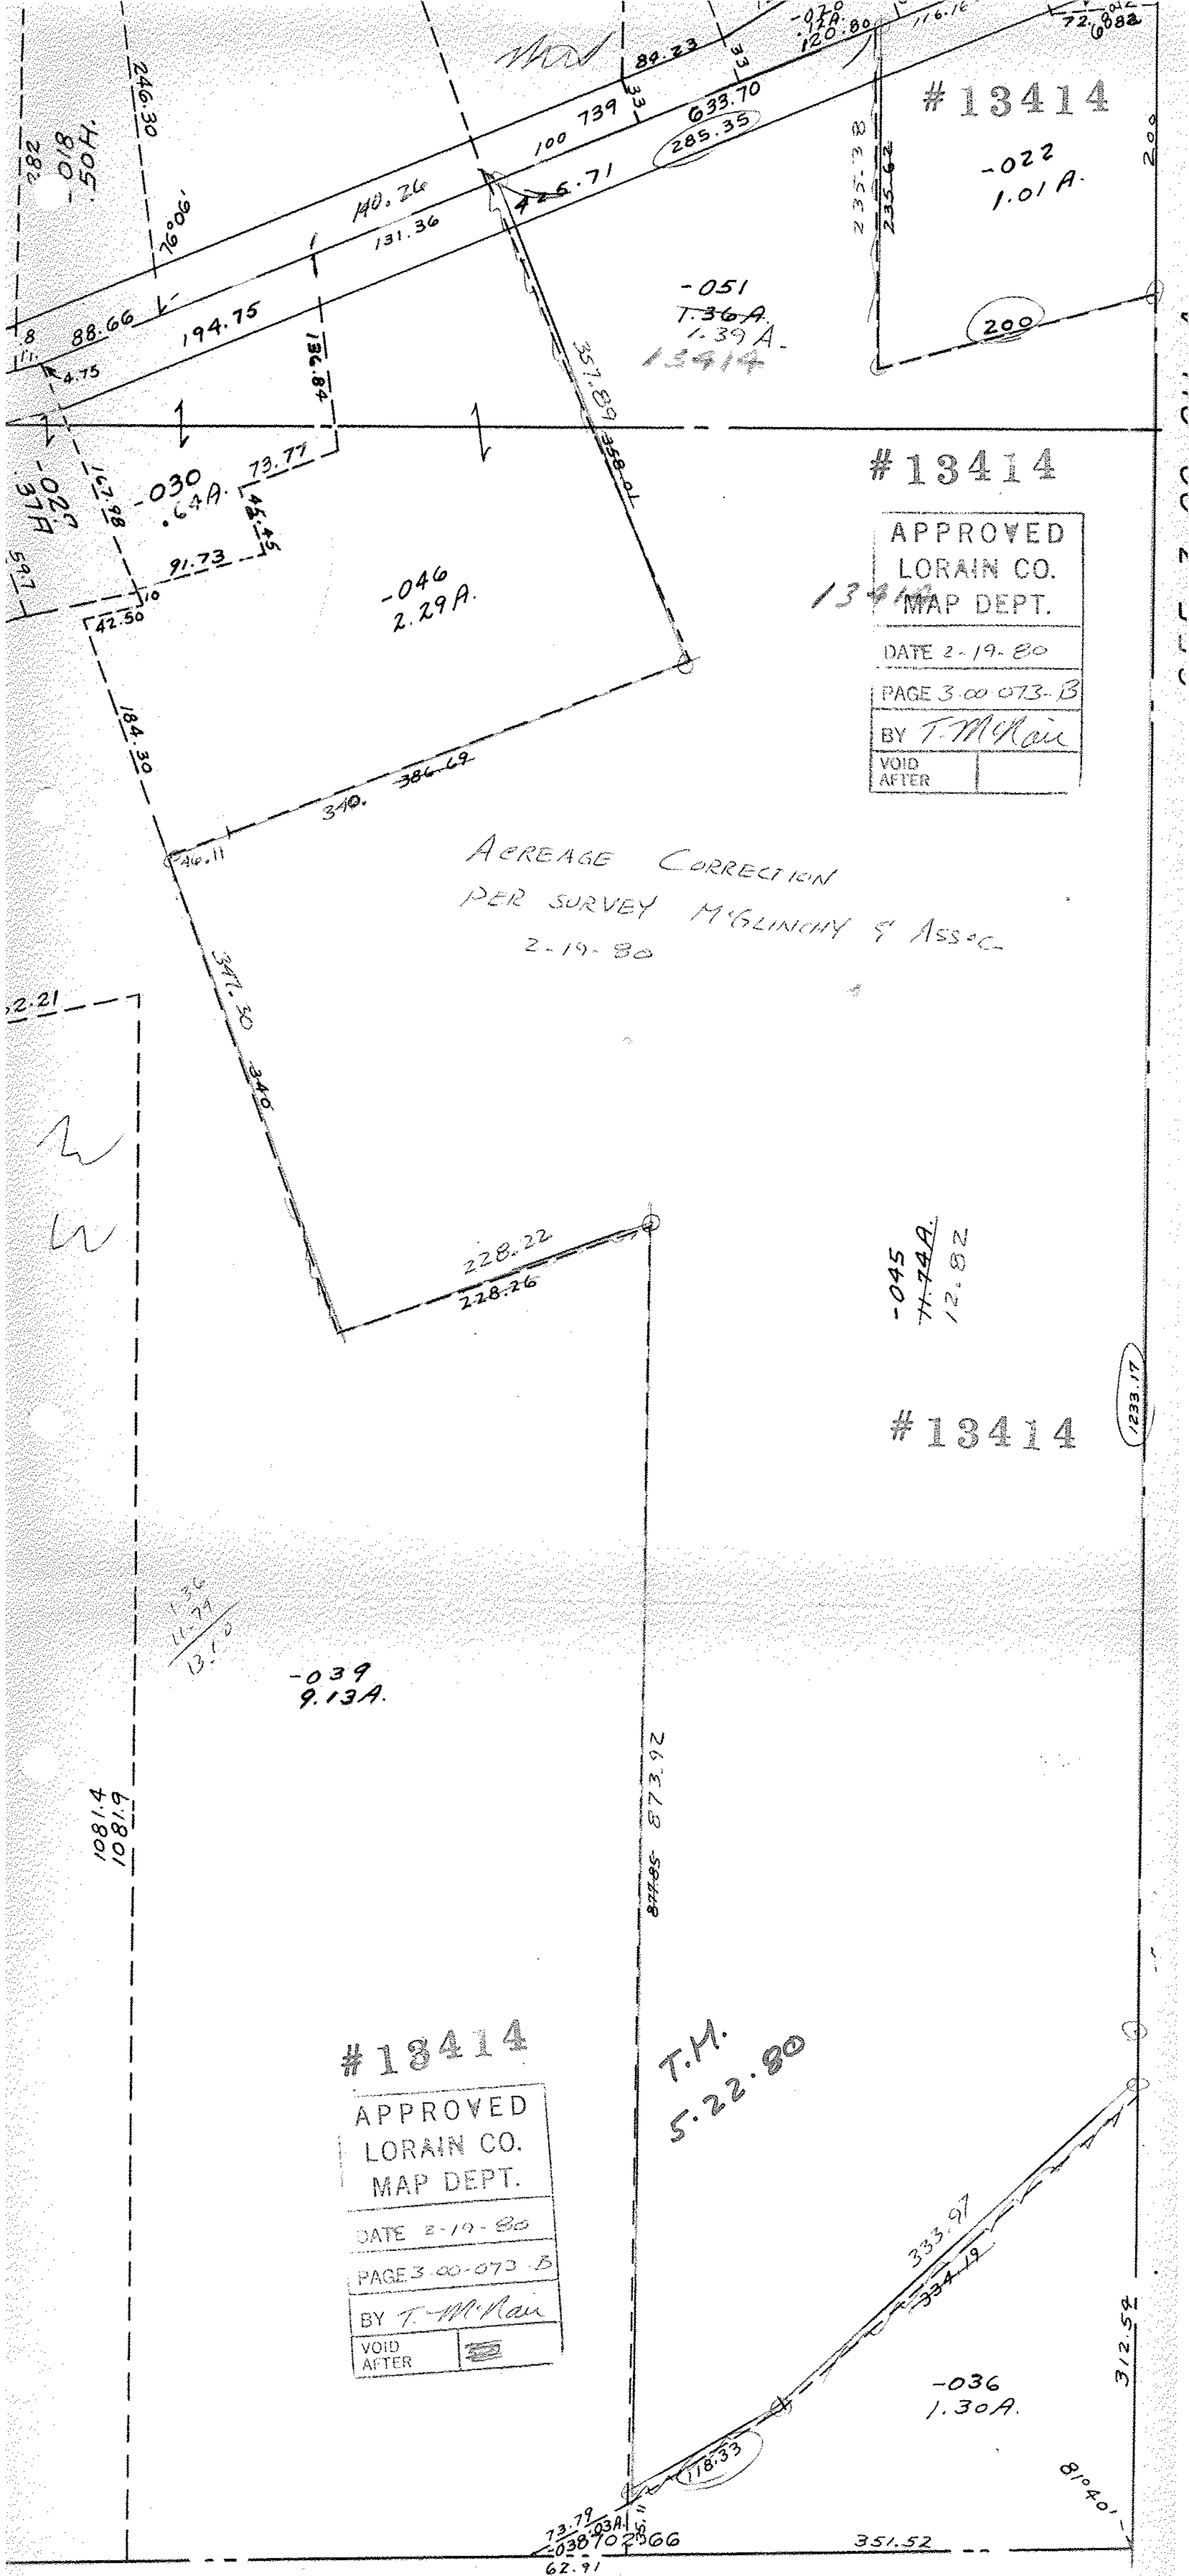
#13414
-022
1.01 A.
-051
T.36 A.
1.39 A.
13414
#13414
-030
.64A.
-046
2.29A.
APPROVED
LORAIN CO.
MAP DEPT.
DATE 2-19-80
PAGE 3.00 073-B
BY T. McRae
VOID AFTER
ACREAGE CORRECTION
PER SURVEY McGLINCHY & Assoc.
2-19-80
-045
11.74A.
12.82
#13414
-039
9.13A.
#13414
APPROVED
LORAIN CO.
MAP DEPT.
DATE 2-19-80
PAGE 3-00-073-B
BY T. McRae
VOID AFTER
T.M.
5.22.80
-036
1.30A.