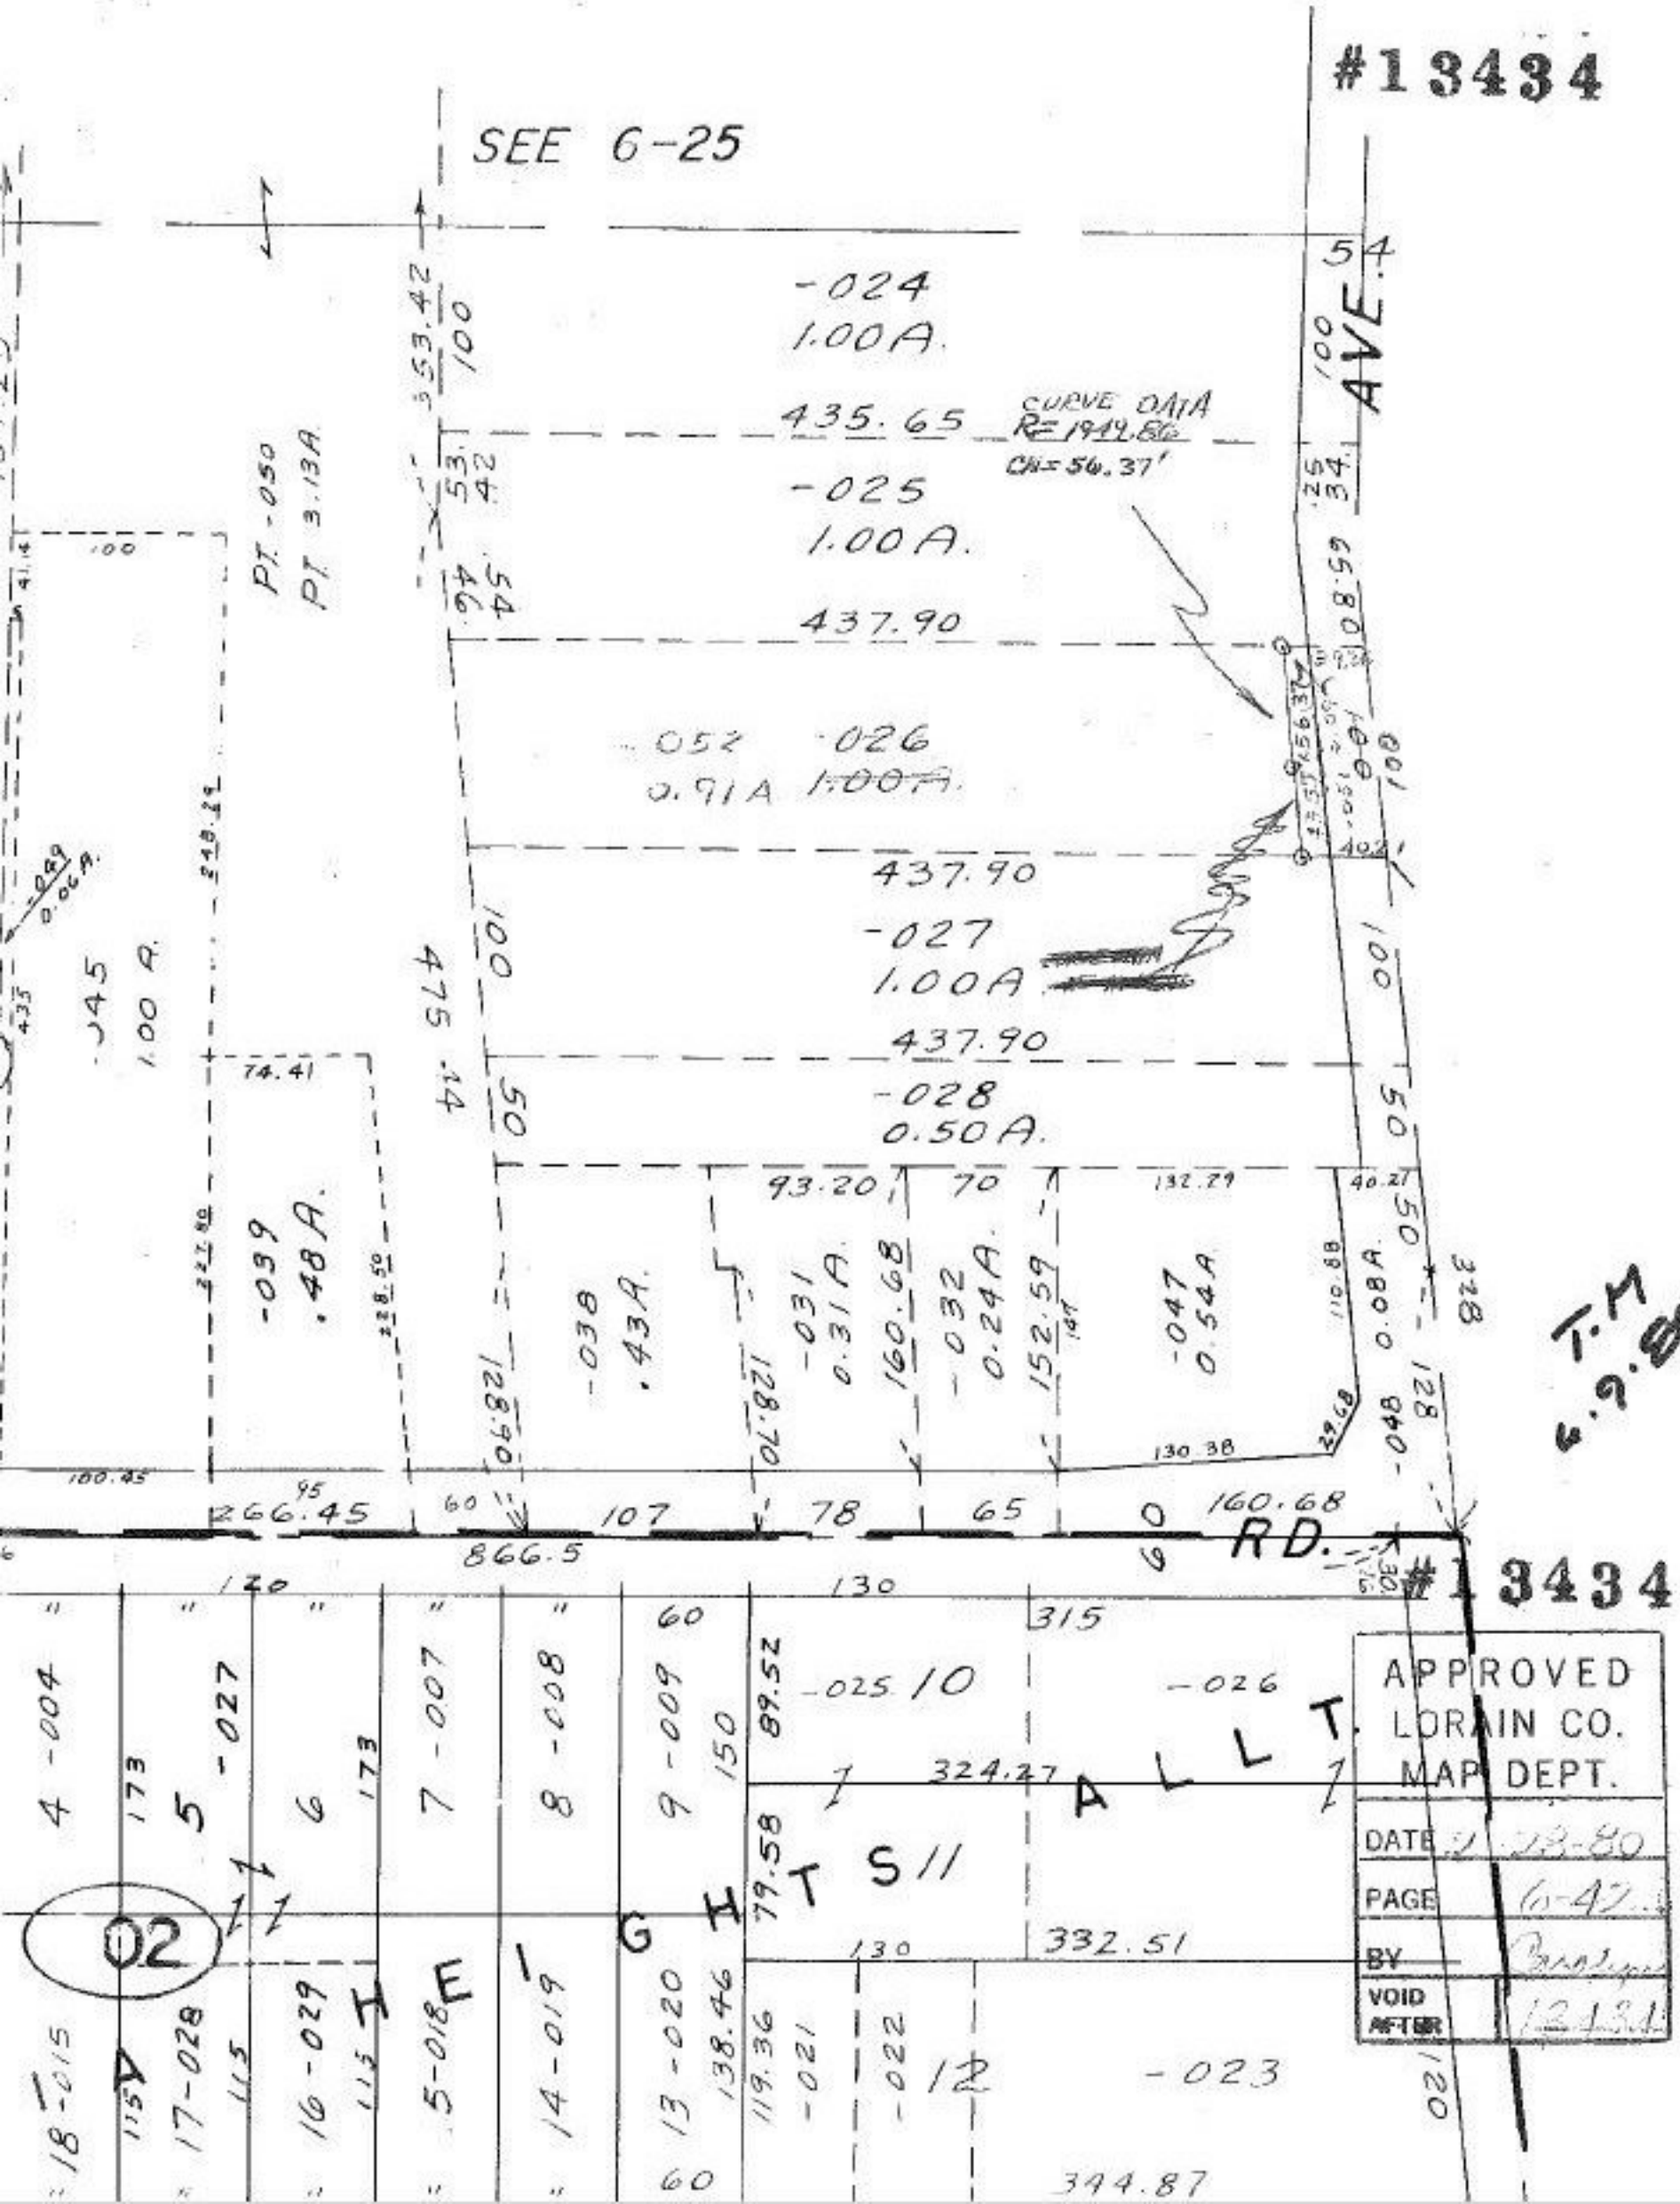
#13434
SEE 6-25
-024
1.00A.
435.65
CURVE DATA
R=1949.86
CH=56.37'
-025
1.00A.
437.90
-052
0.91A
-026
1.00A.
437.90
-027
1.00A
437.90
-028
0.50A.
-039
.48A.
-038
.43A.
-031
0.31A.
-032
0.24A.
-047
0.54A
-045
1.00 A.
PT. -050
PT. 3.13A
-049
0.06A.
-048
0.08A.
266.45
866.5
160.68
RD.
AVE.
T.M
6.9.80
#13434
APPROVED
LORAIN CO.
MAP DEPT.
DATE
PAGE
BY
VOID
AFTER
HEIGHTS ALLT.
02
-025
-026
-023
324.27
332.51
344.87