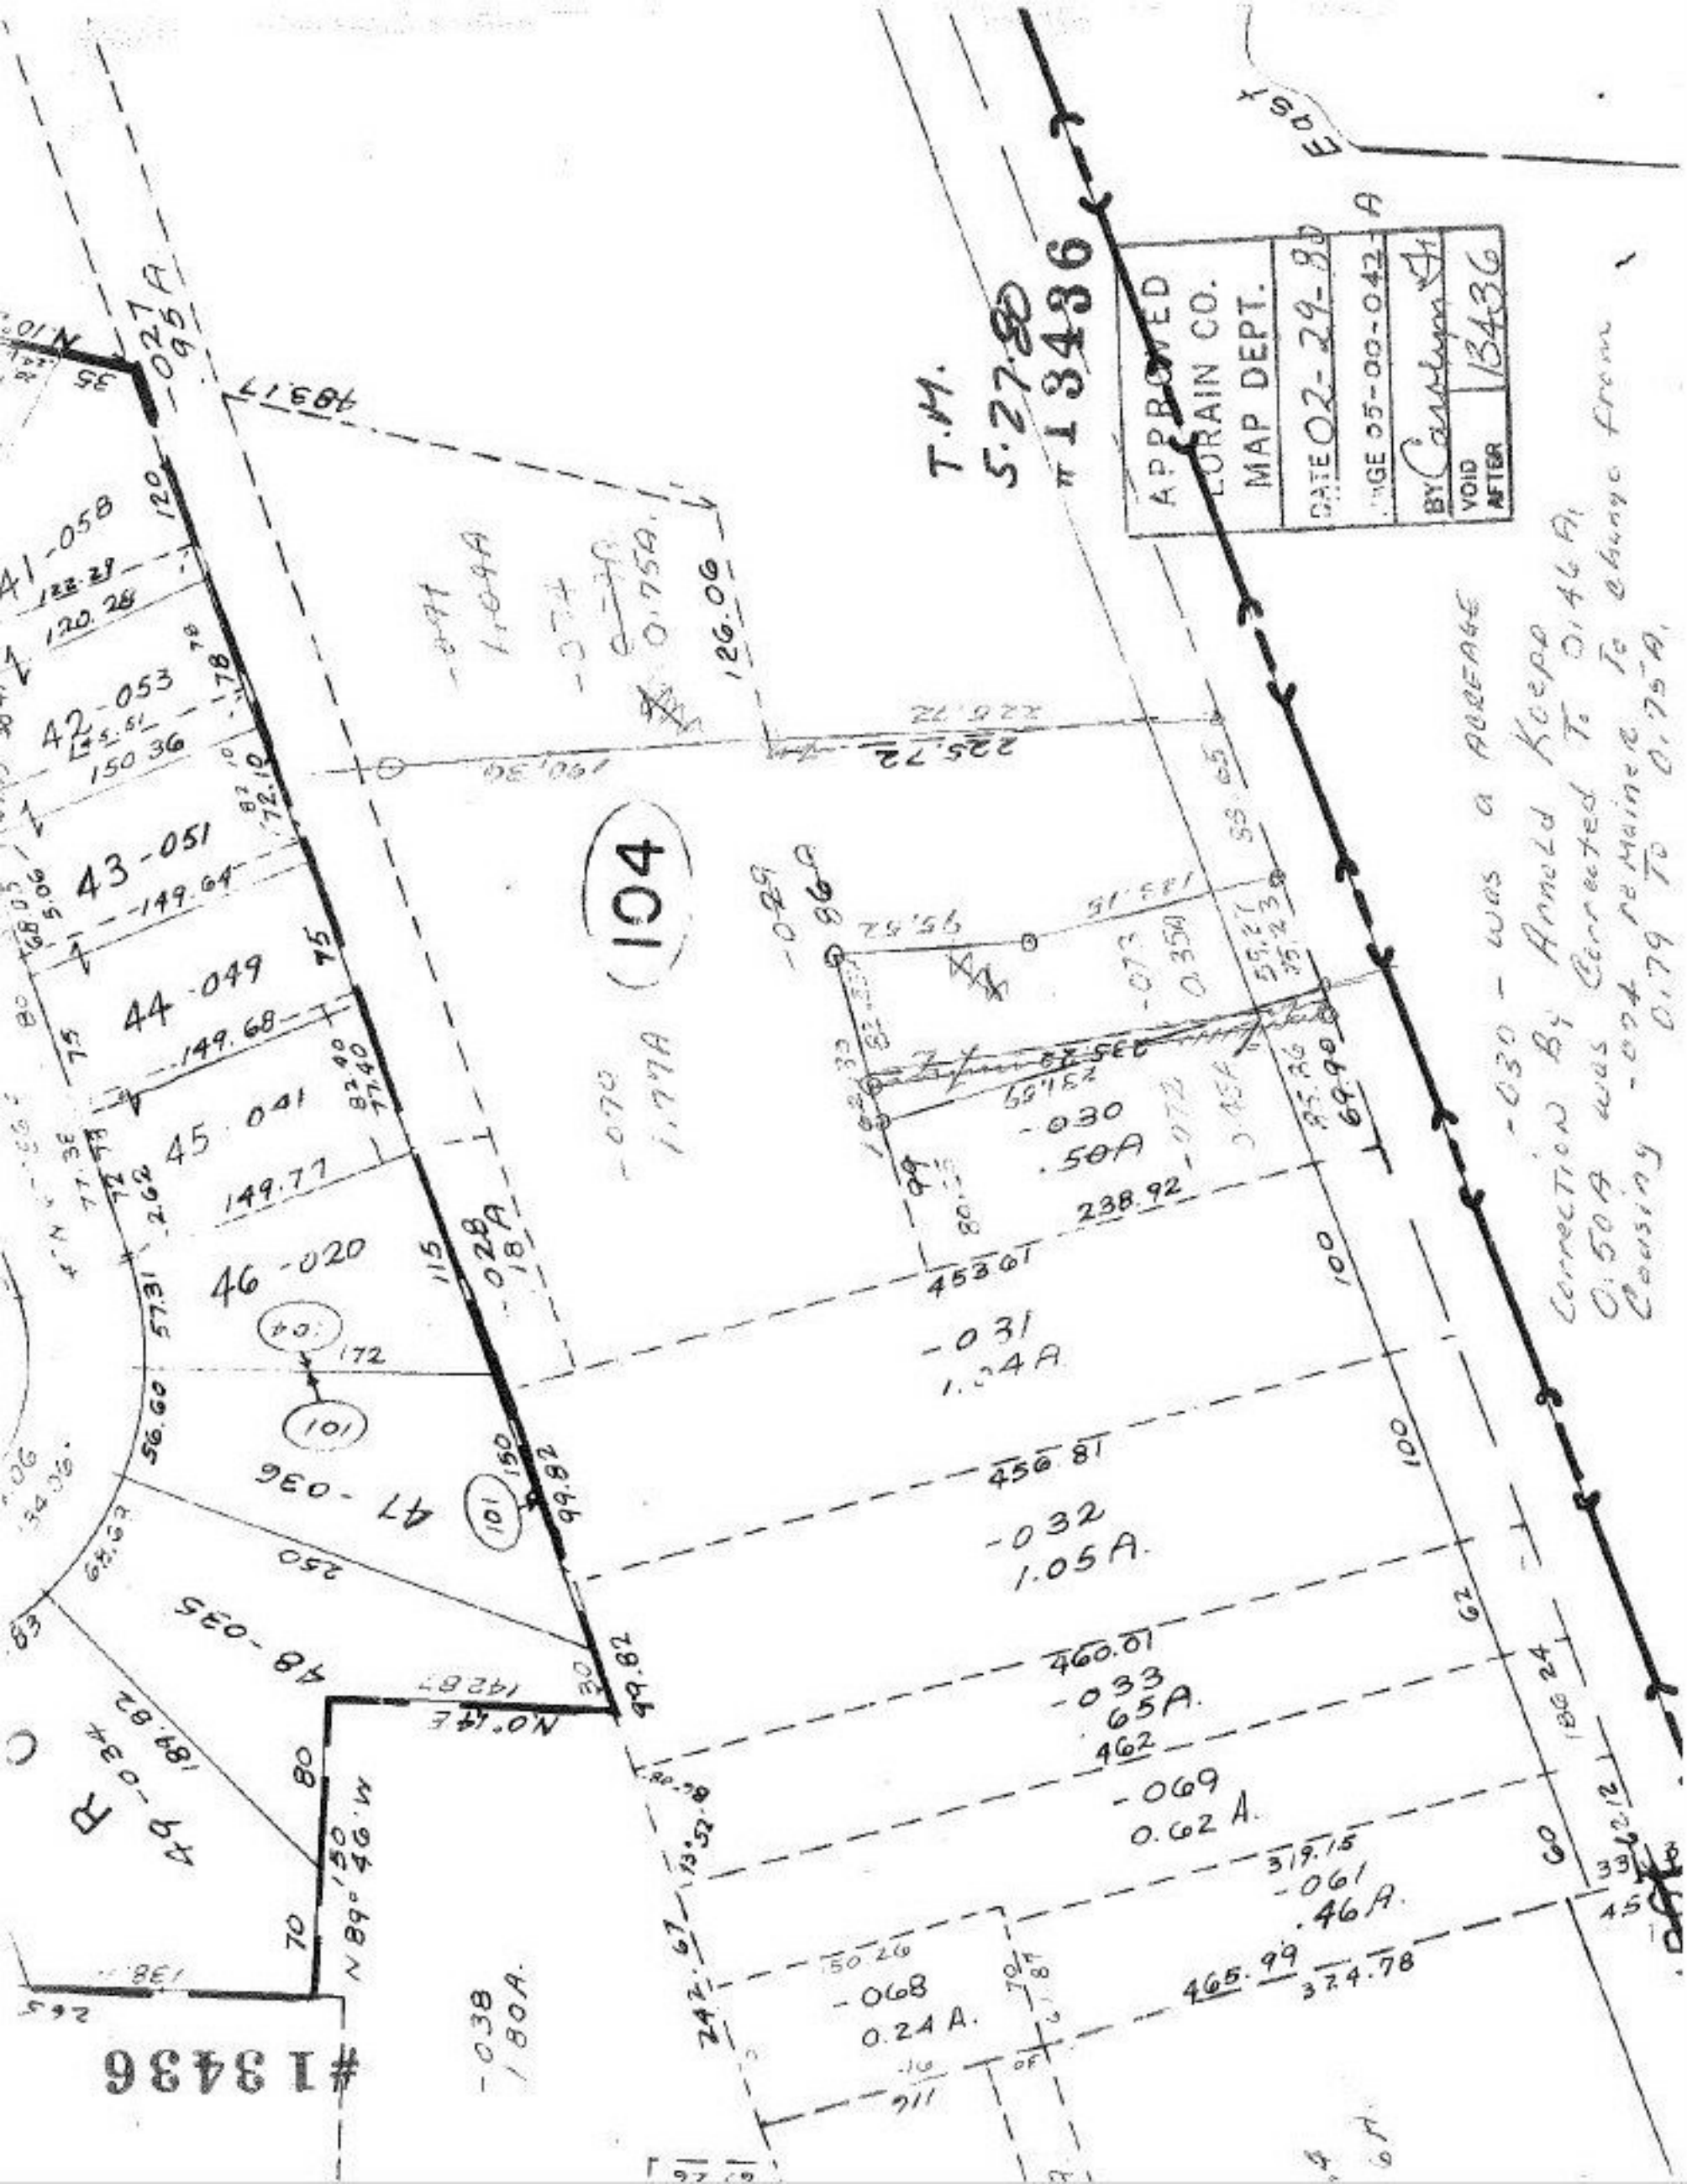

APPROVED
LORAIN CO.
MAP DEPT.
DATE 02-29-80
PAGE 05-00-042-A
BY Carolyn H
VOID AFTER 13436
T.M.
5.27.80
#13436
#13436
104
-030 - was a ACREAGE
Correction By Arnold Koepp
0.50A was Corrected To 0.46A.
Coasing -074 remainder To change from
0.79 To 0.75A.
-030
.50A
-031
1.04A
-032
1.05A.
-033
.65A.
-069
0.62 A.
-061
.46A.
-068
0.24 A.
-038
1.80A.
-028
1.8A
-027
.95A
-029
.86A
-070
1.77A
-073
0.35A
-074
0.75A.
-077
1.04A
-078
0.75A.
41-058
42-053
43-051
44-049
45-041
46-020
47-036
48-035
49-034