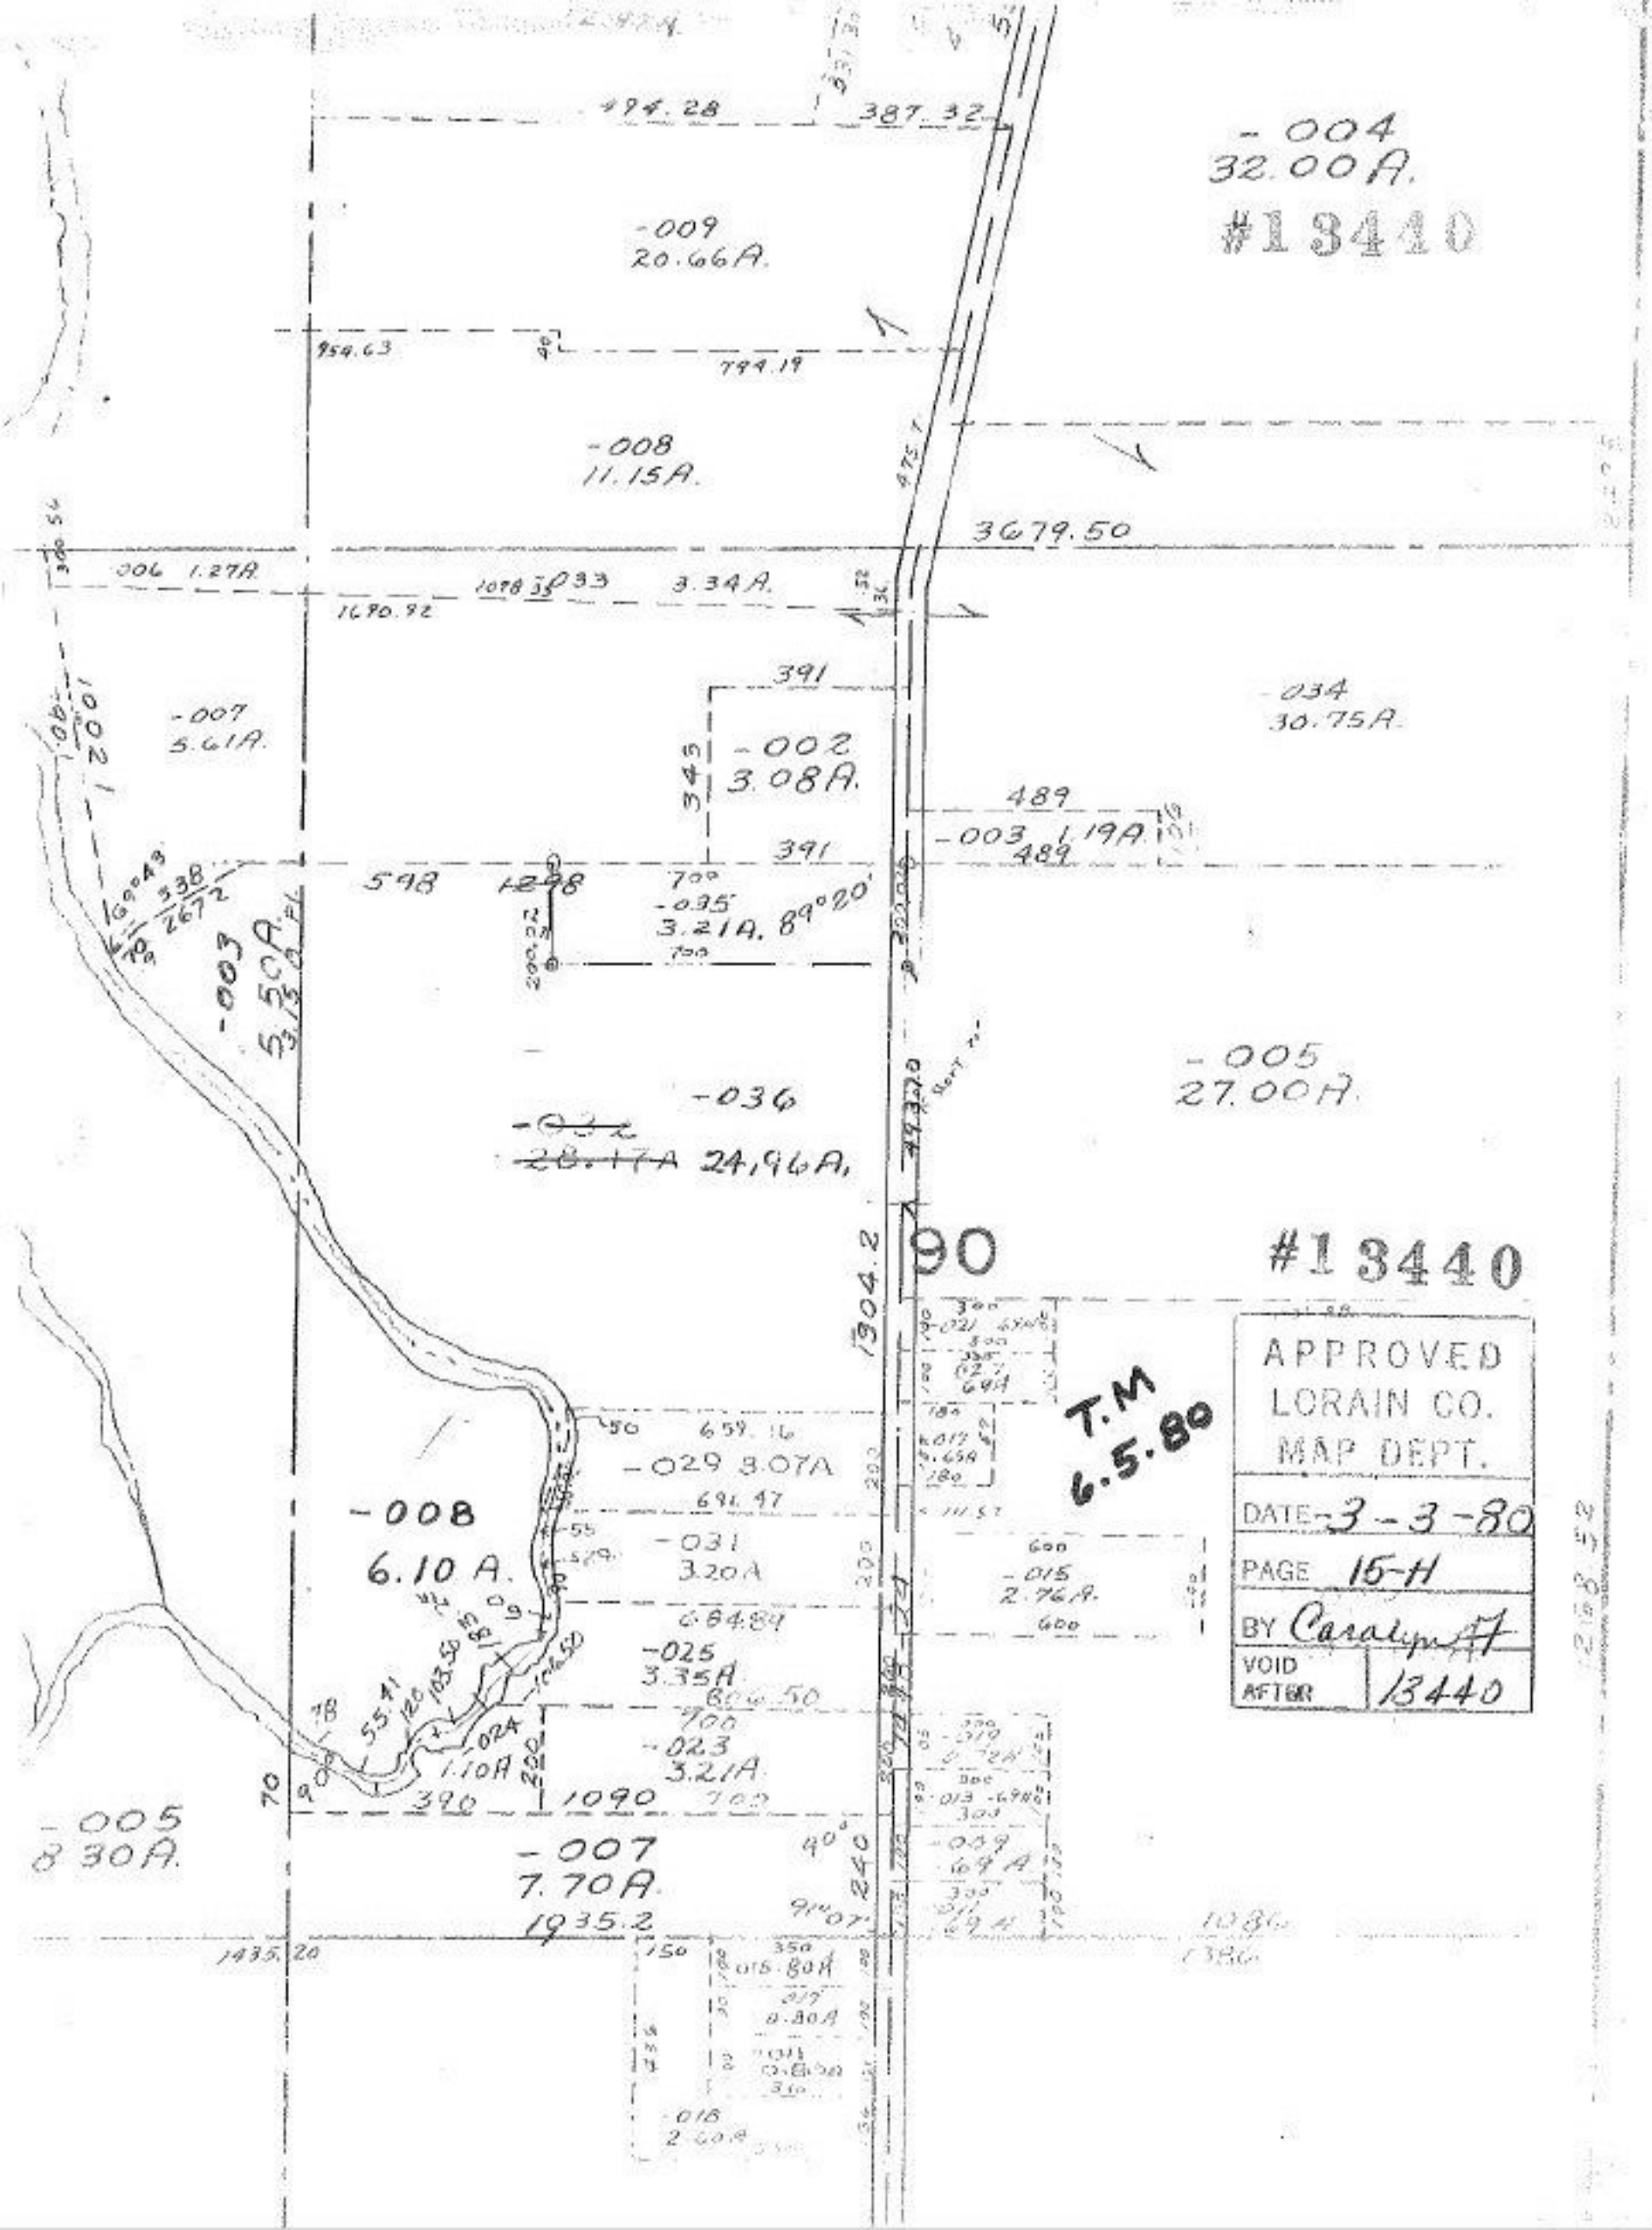

-004
32.00A.
#13440
-009
20.66A.
-008
11.15A.
3679.50
-007
5.61A.
-002
3.08A.
-034
30.75A.
-003 1.19A.
-035
3.21A. 89°20'
-003
5.50A.
-005
27.00A.
-036
24.96A.
90
#13440
T.M
6.5.80
-029 3.07A
-008
6.10 A.
-031
3.20A
-015
2.76A.
-025
3.35A
-023
3.21A
-005
8.30A.
-007
7.70A.
1935.2
APPROVED
LORAIN CO.
MAP DEPT.
DATE -3-3-80
PAGE 15-H
BY Carolyn A
VOID AFTER 13440