#13447

APPROVED
LORAIN CO.
MAP DEPT.

DATE 3-1-80

PAGE 9-00-086-A

BY T. McNair

VOID AFTER

5-14-80
T.M.

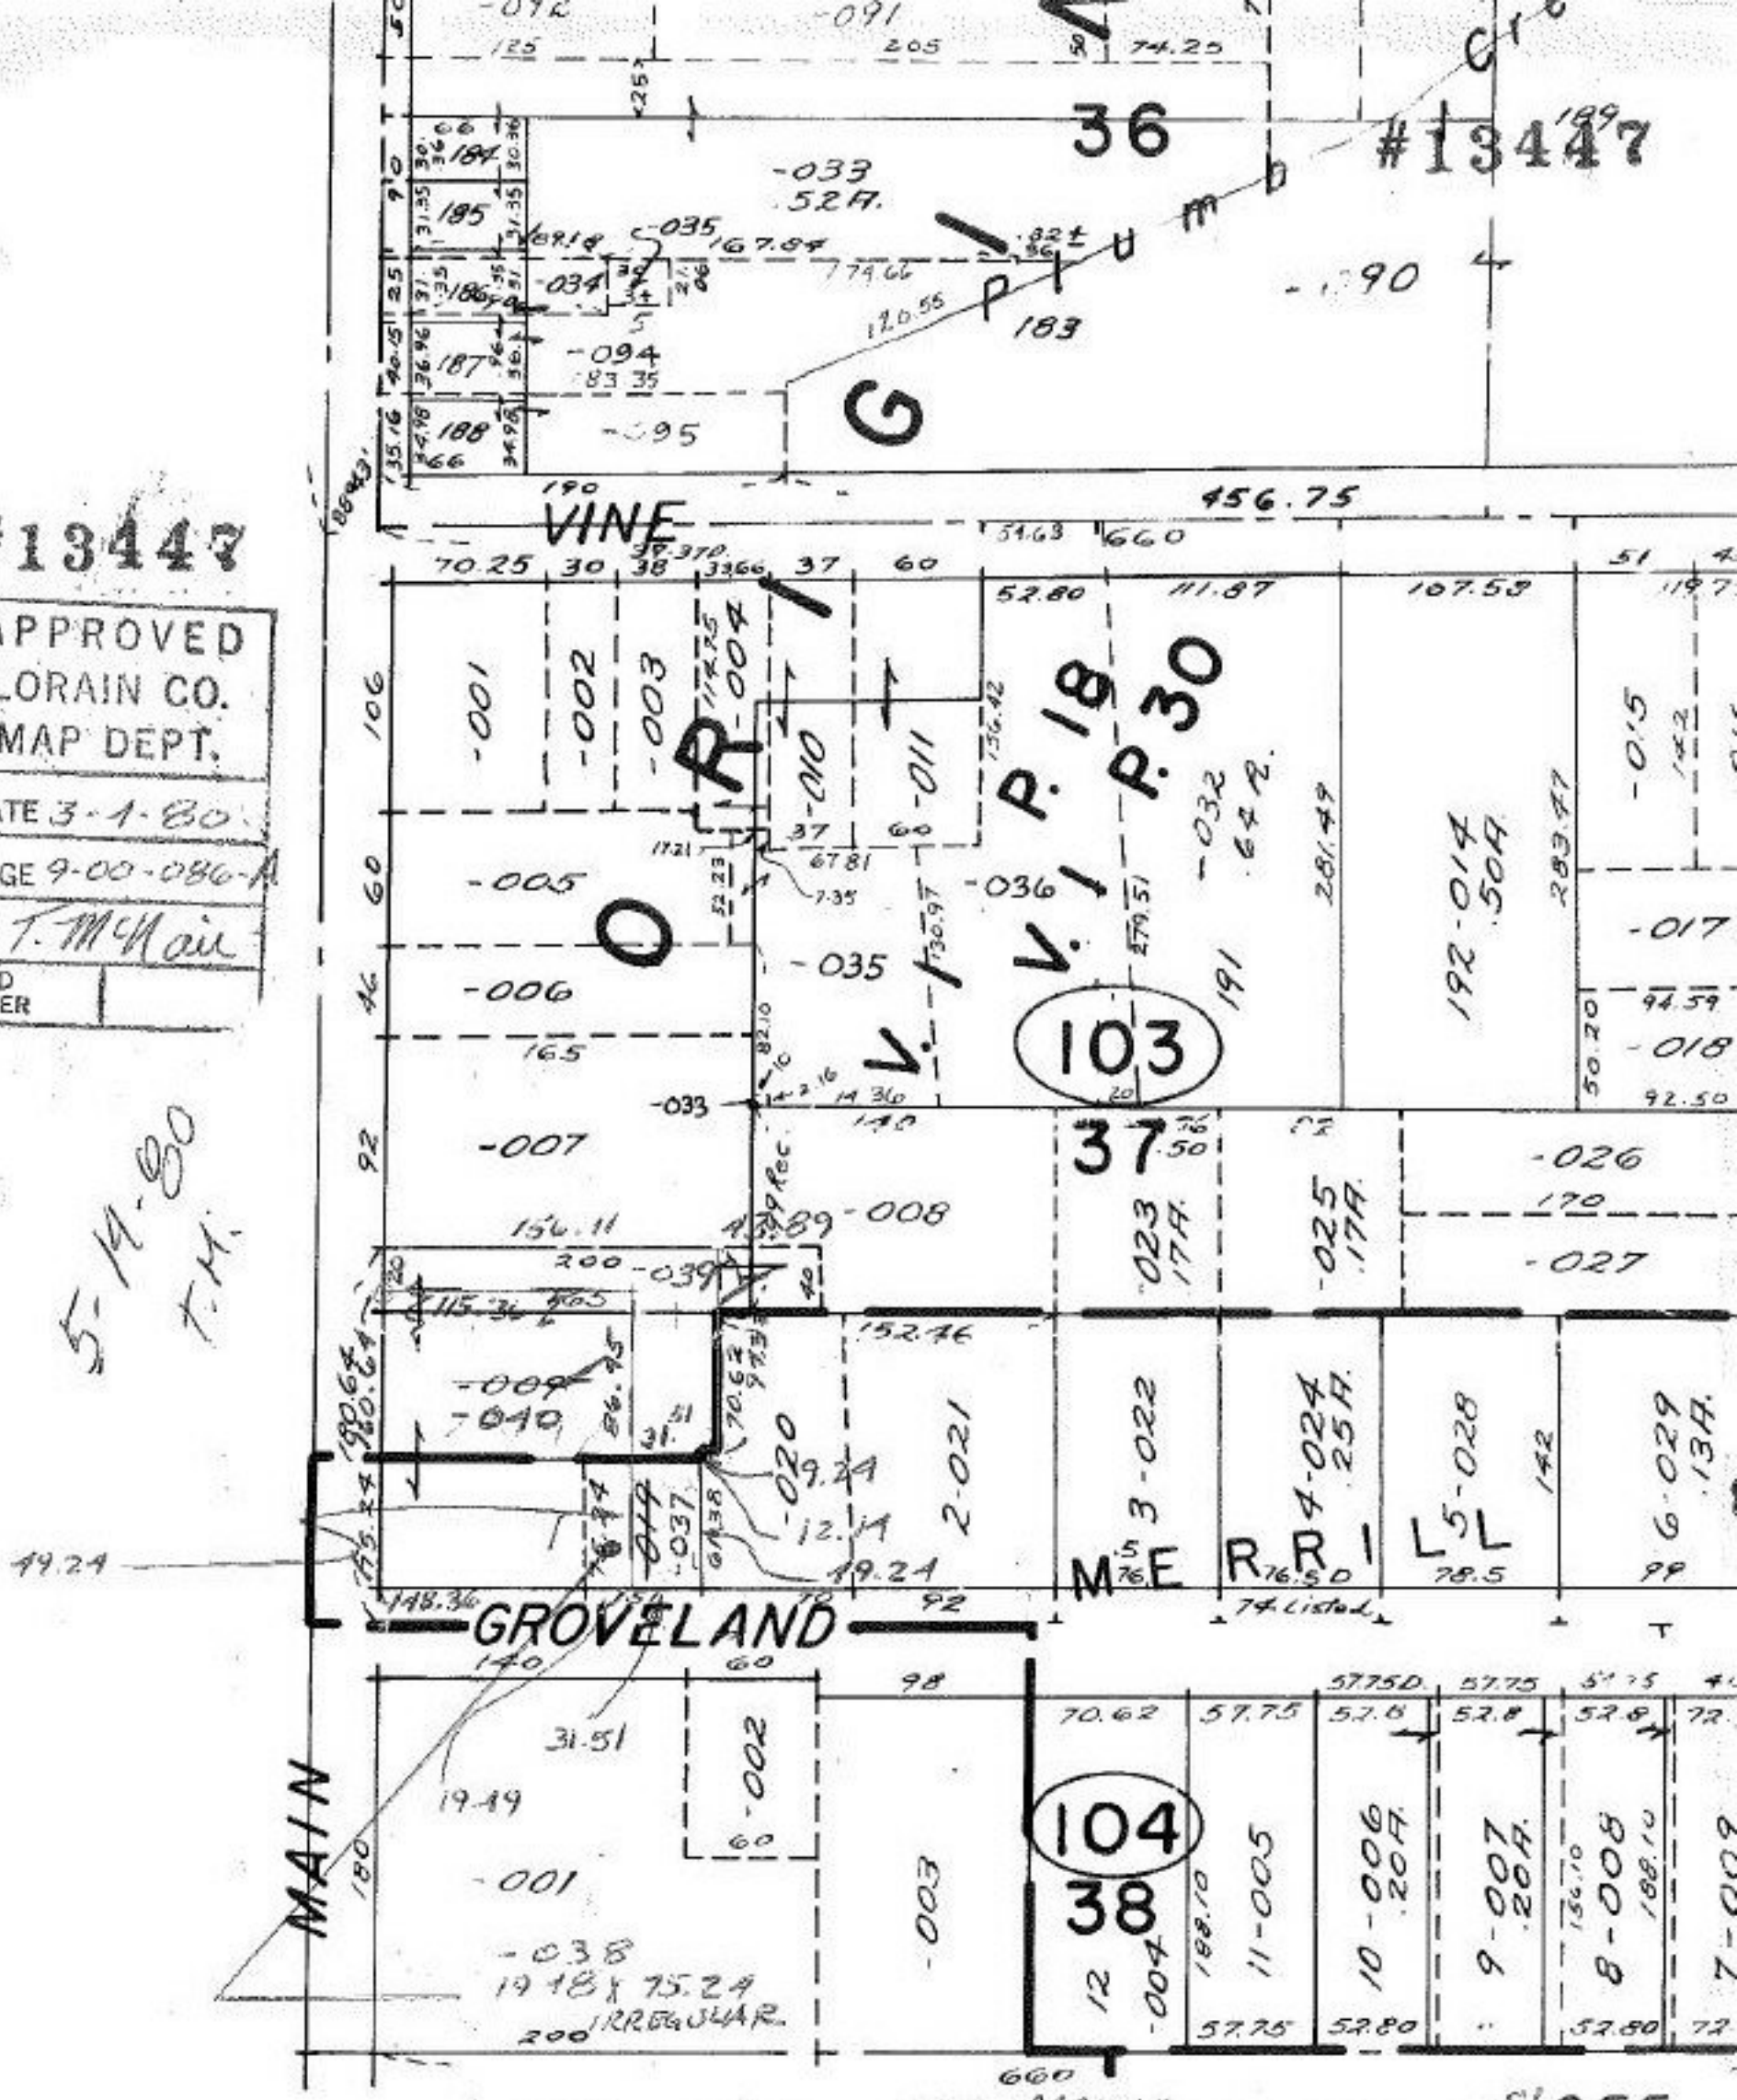


NEW PARCELS
09-00-086-103-037 31.75 x 49.24
09-00-086-103-038 19.45 x 75.24
09-00-086-103-039 20 x 156.11
09-00-086-103-040 160.64 x 115.36

SEE