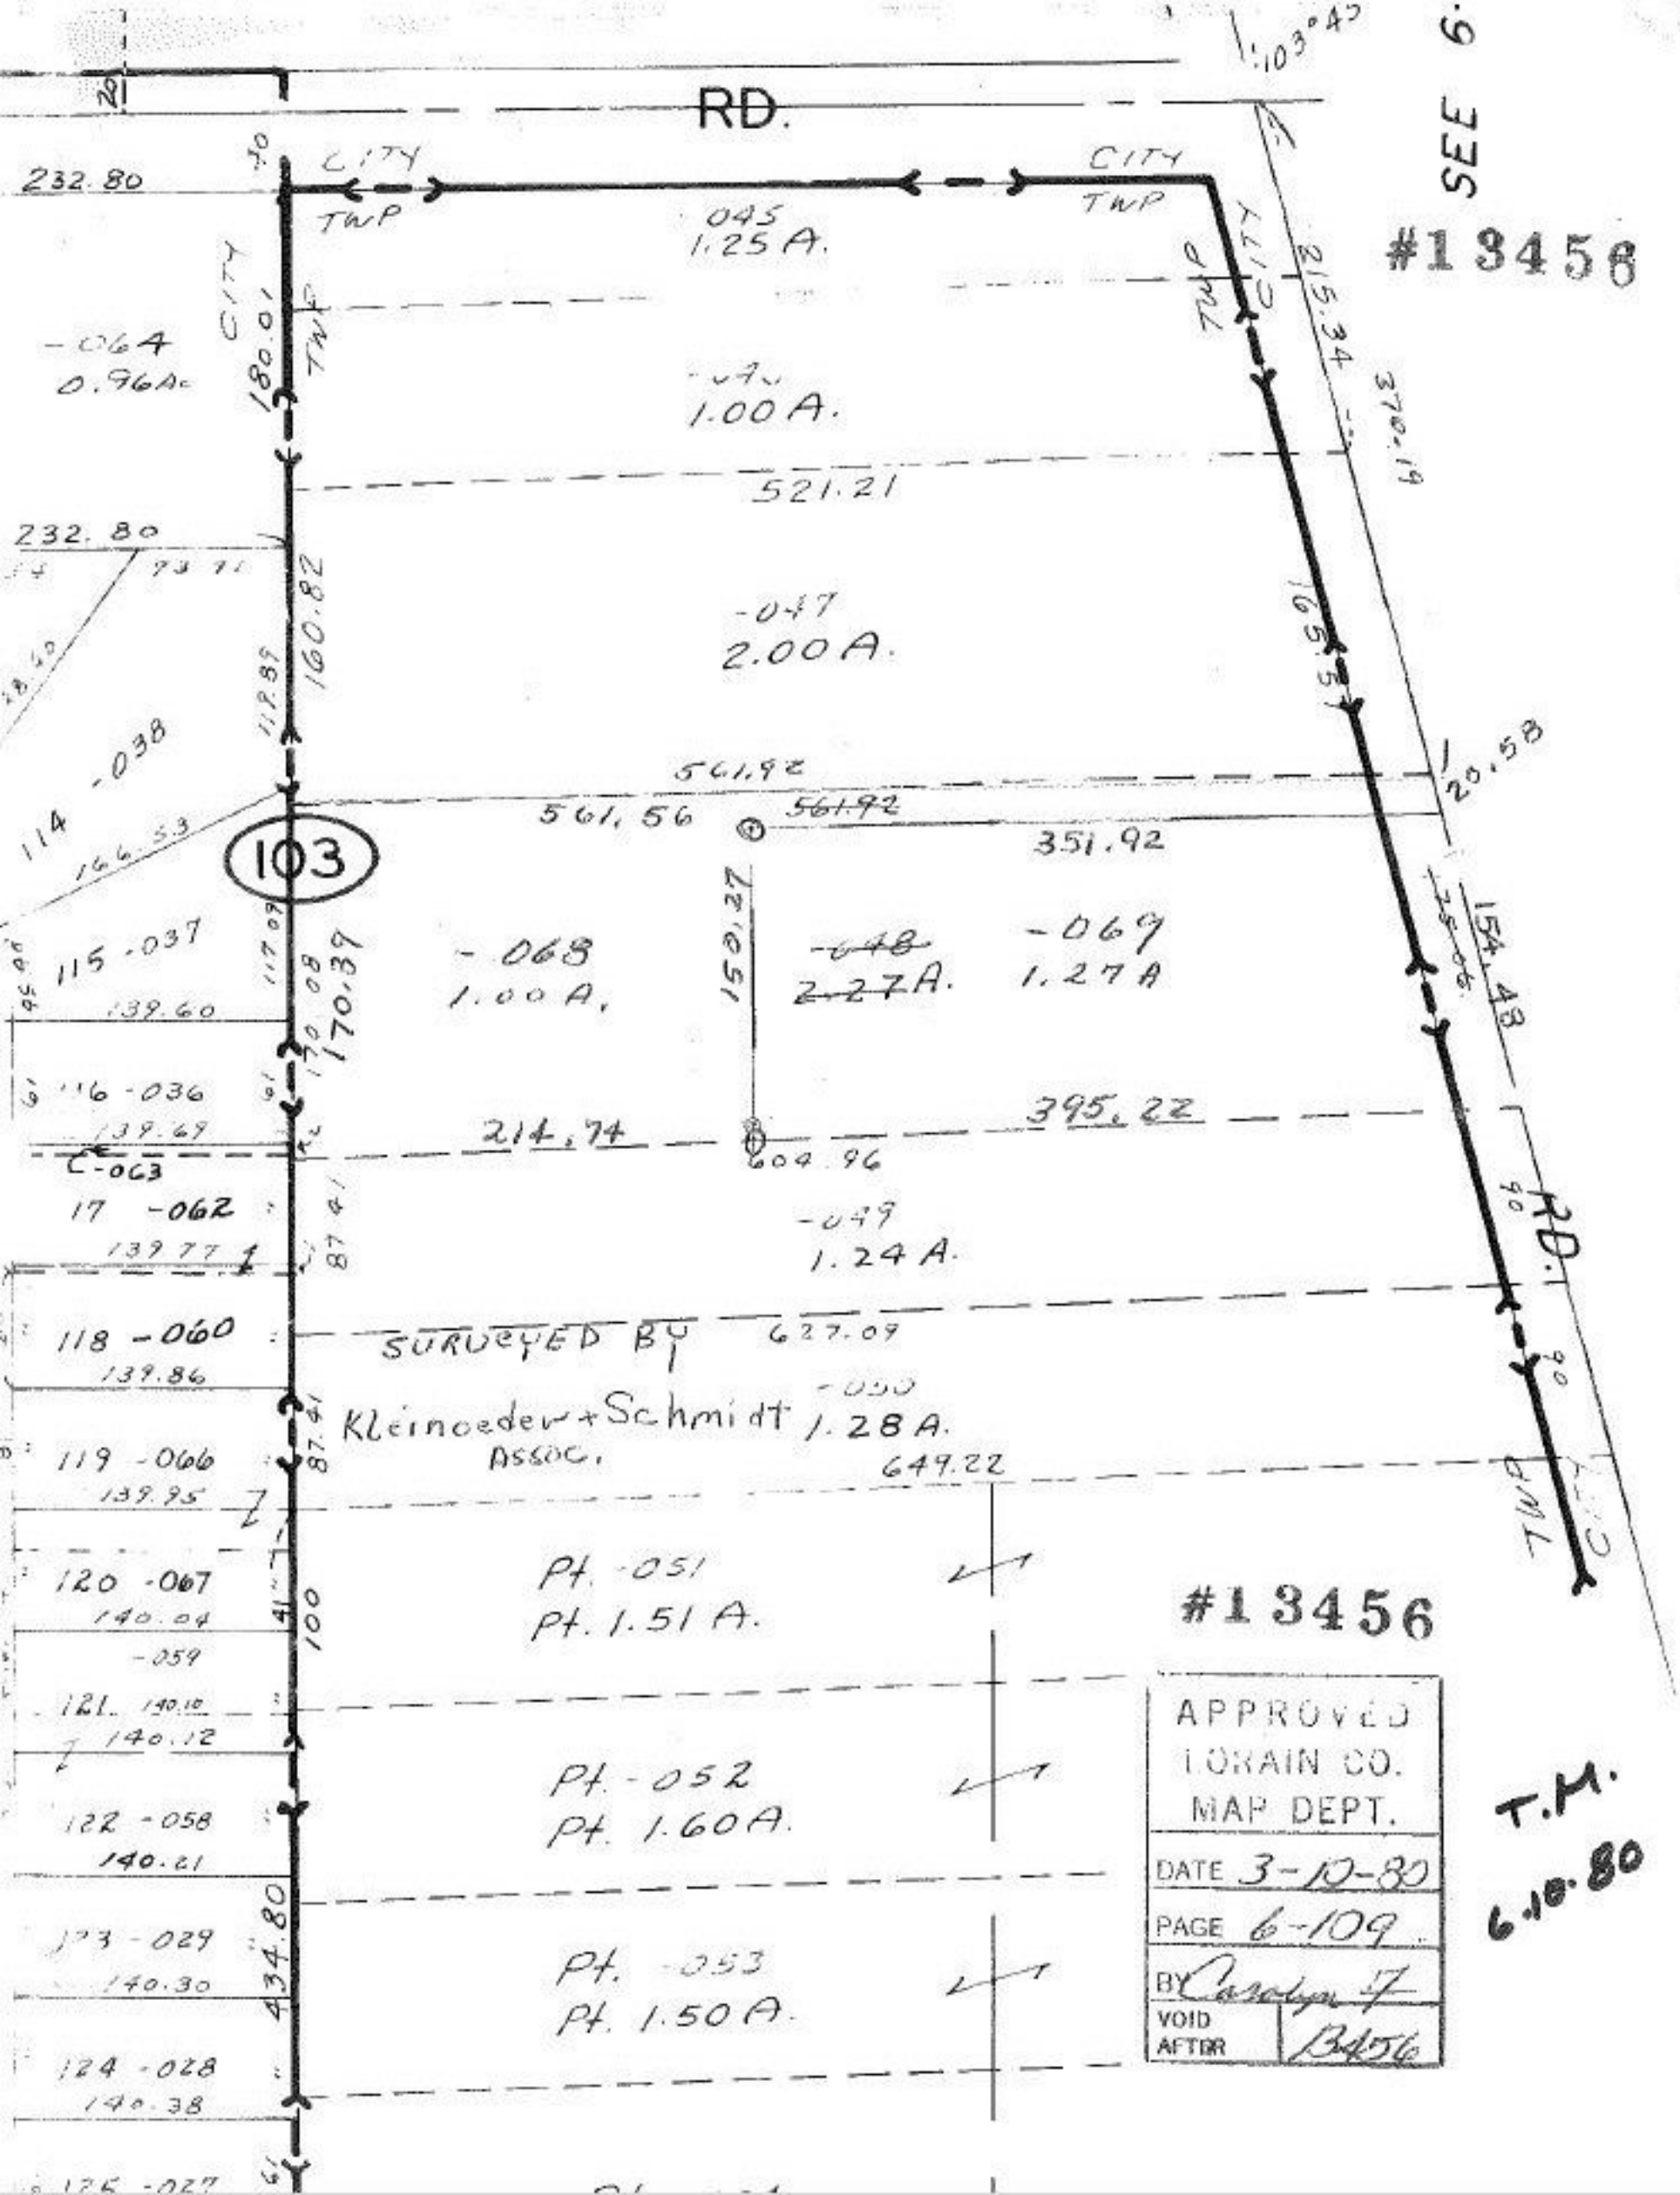

RD.
CITY
TWP
232.80
-064
0.96Ac
180.01
-045
1.25 A.
1.00 A.
521.21
232.80
160.82
-047
2.00 A.
114 -038
166.53
561.92
561.56
561.92
351.92
103
115 -037
139.60
170.39
-068
1.00 A.
150.27
-048
2.27 A.
-069
1.27 A
116 -036
139.69
214.74
395.22
604.96
-063
17 -062
139.77
-049
1.24 A.
118 -060
139.86
SURVEYED BY
627.09
Kleinoeder + Schmidt
ASSOC.
-050
1.28 A.
649.22
119 -066
139.95
120 -067
140.04
Pt. -051
Pt. 1.51 A.
-059
121 140.10
140.12
Pt. -052
Pt. 1.60 A.
122 -058
140.21
123 -029
140.30
434.80
Pt. -053
Pt. 1.50 A.
124 -028
140.38
125 -027
215.34
370.19
165.57
20.58
154.48
RD.
TWP
SEE 6
#13456
#13456
APPROVED
LORAIN CO.
MAP DEPT.
DATE 3-10-80
PAGE 6-109
BY Carolyn F
VOID AFTER B456
T.M.
6.10.80