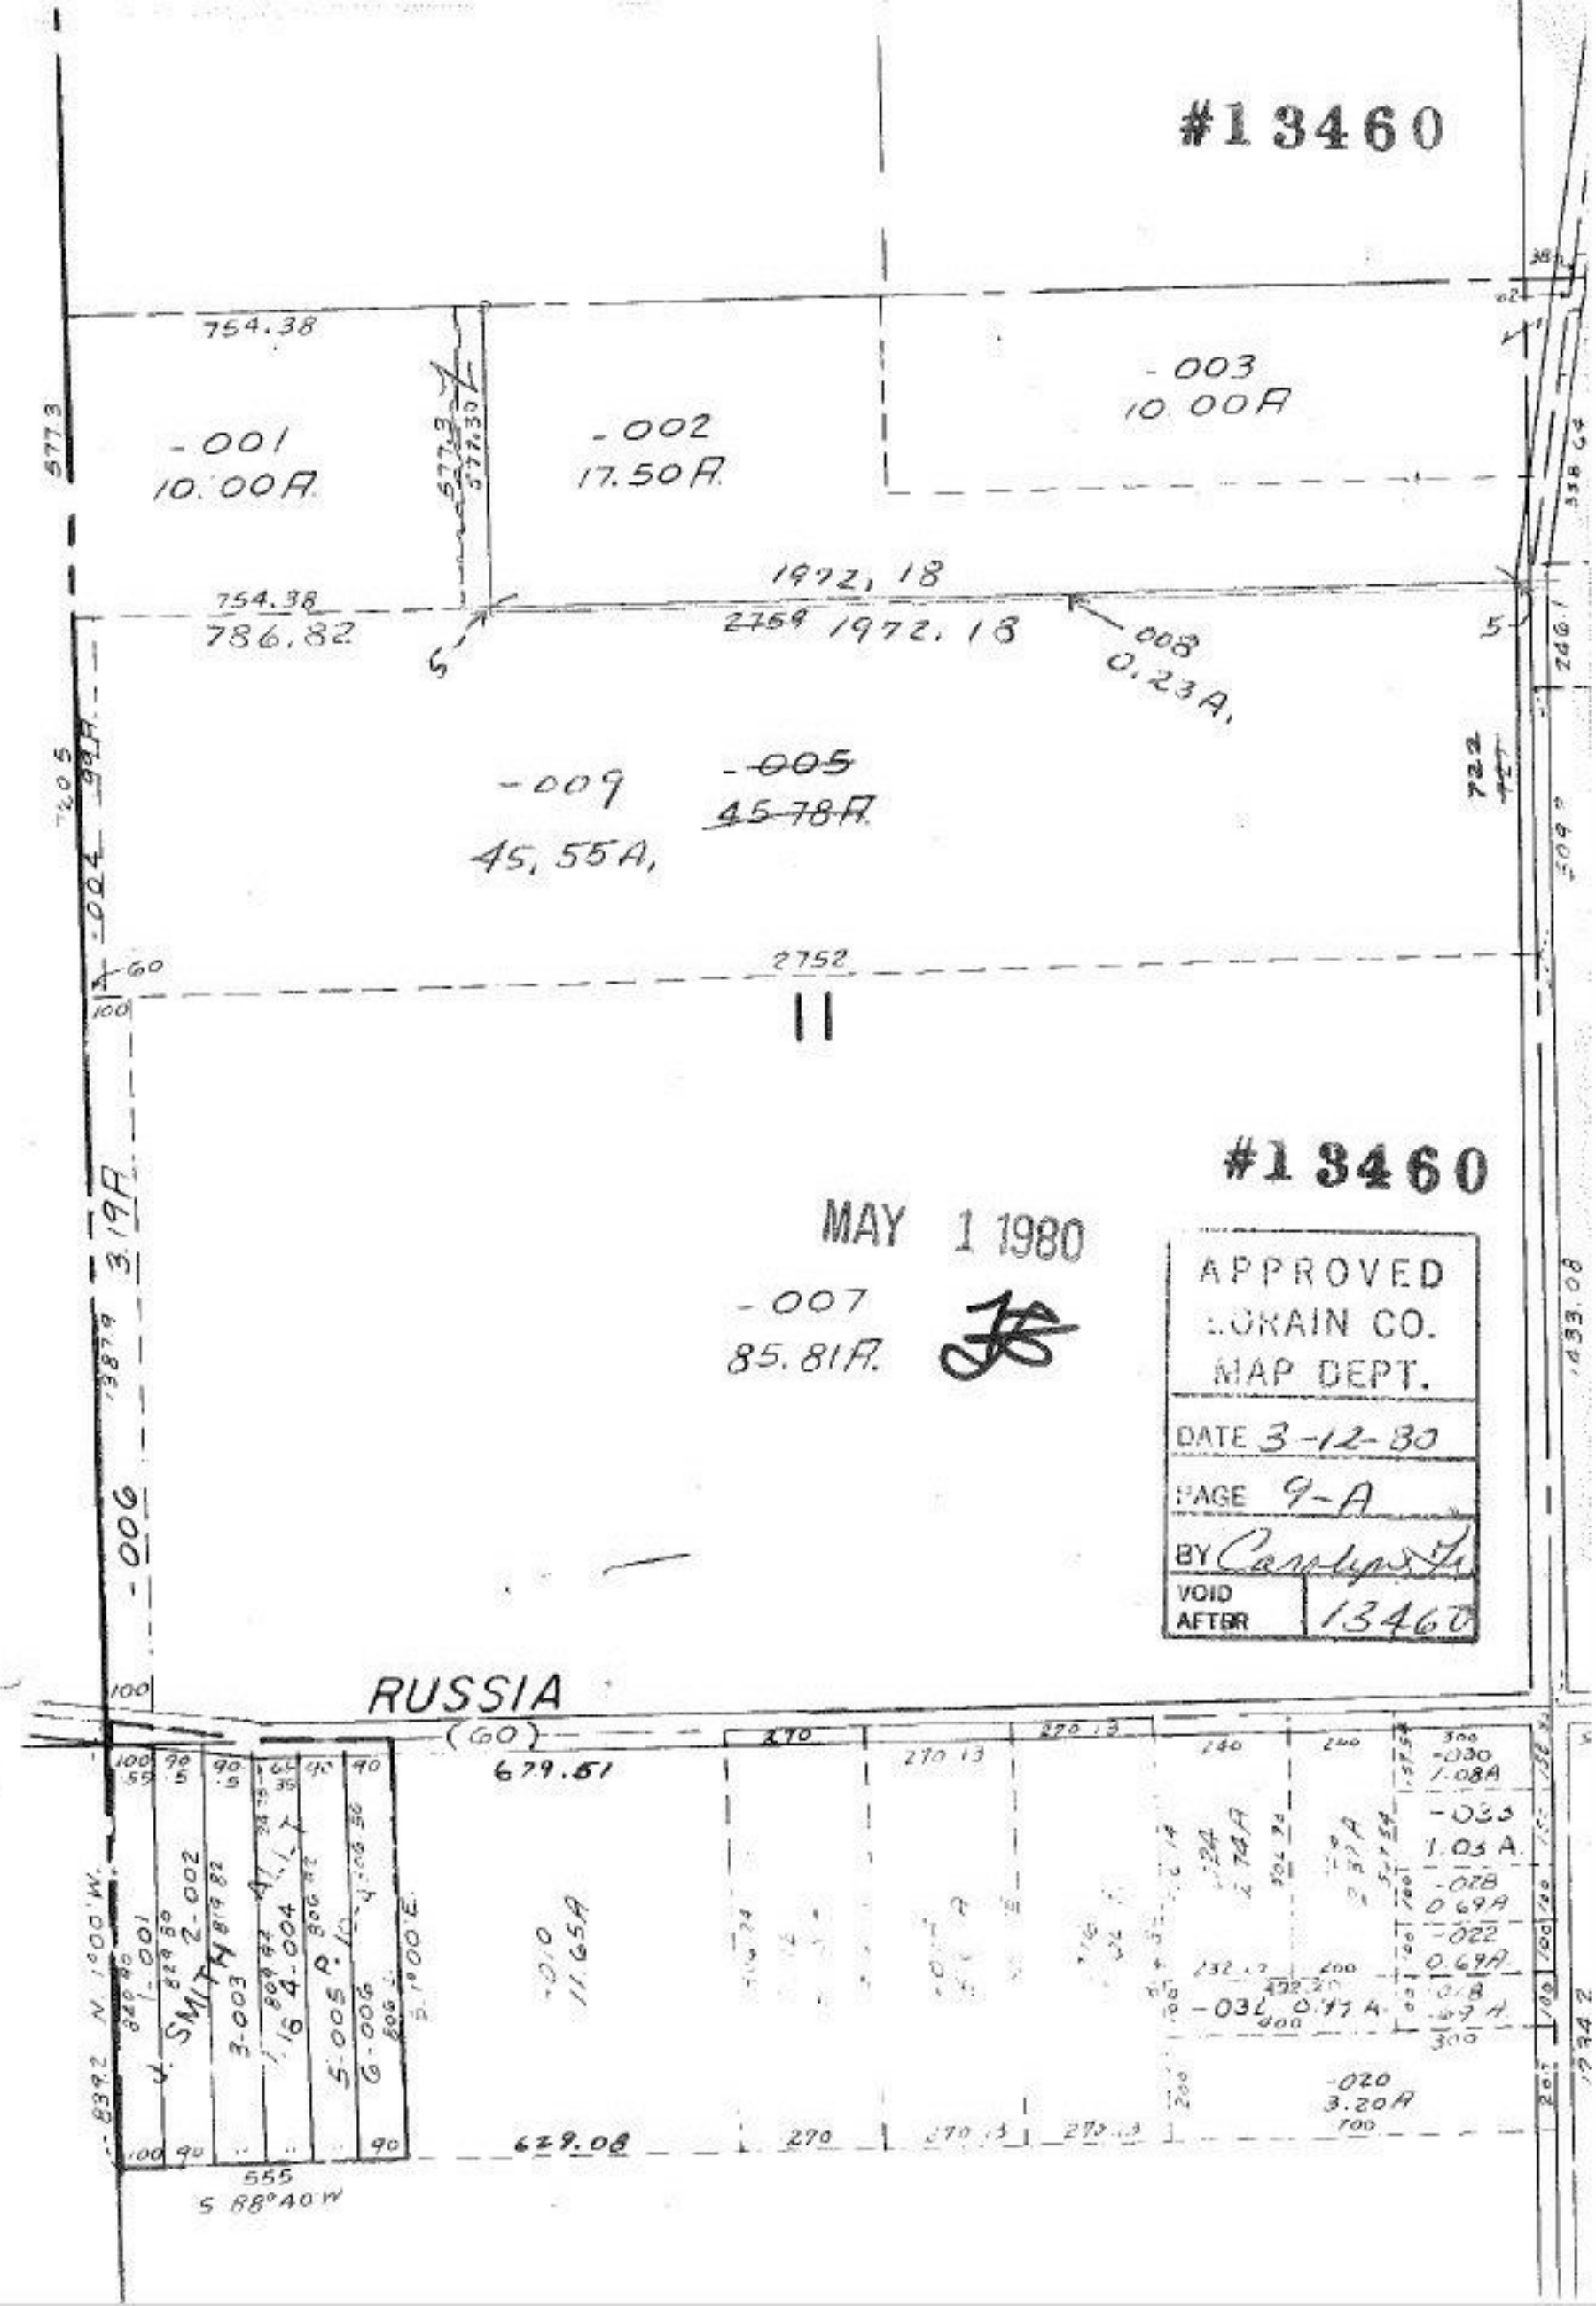
#13460
754.38
-001
10.00A
-002
17.50A
-003
10.00A
1972.18
754.38
786.82
2759 1972.18
-008
0.23A
-009
45.55A
-005
45.78A
2752
#13460
MAY 1 1980
-007
85.81A
APPROVED
LORAIN CO.
MAP DEPT.
DATE 3-12-80
PAGE 9-A
BY
VOID AFTER 13460
RUSSIA
(60)
679.51
-010
11.65A
629.08
-020
3.20A
-033
1.03 A
-028
0.69A
-022
0.69A
-030
1.08A
-006
3.19A
-004
-005
-006
555
S 88°40 W